


## BLOW -UP PLAN 1-1

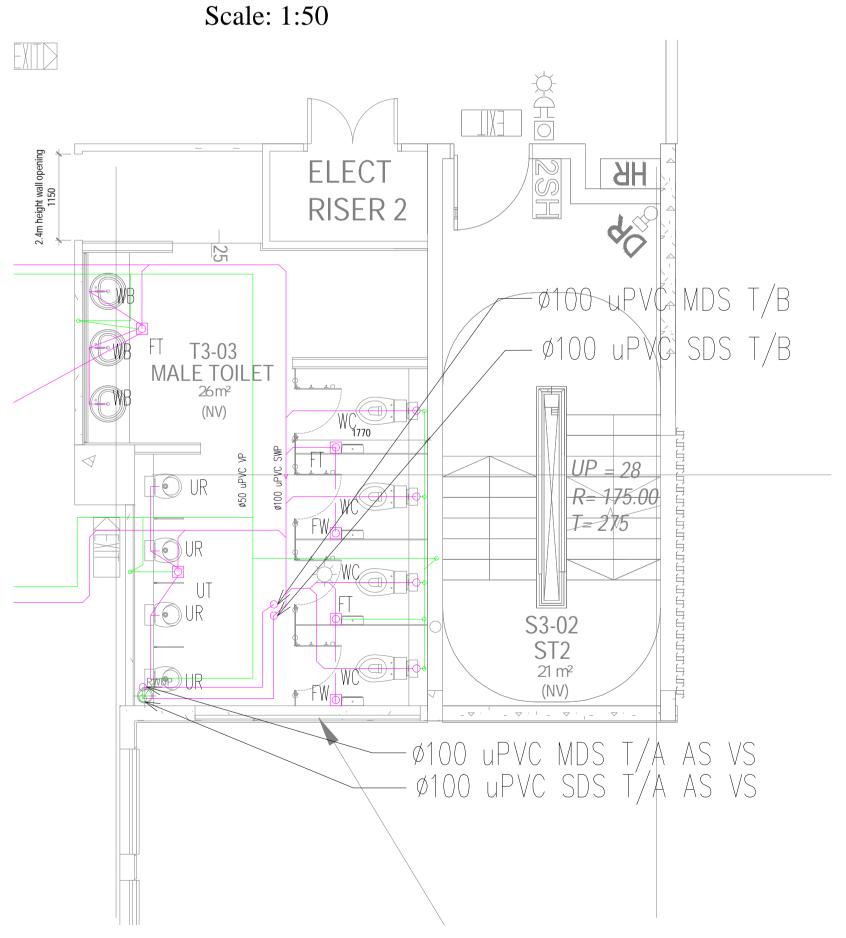

BLOW -UP PLAN 2-2 Scale: 1:50

OFFICIAL (CLOSED)

/AS-BUILT/
Project Ref. No. : A2105-00599-2022

7748

PCCConsultants Pte Ltd
23 NEW INDUSTRIAL ROAD #06-03 TEL: 6444
SOLSTICE BUSINESS CENTER SINGAPORE 536209 FAX: 6444

DATE RECEIVED:

DATE RETURNED:

M&E CONSULTANTS

□ NO EXCEPTION TAKEN □ MAKE CORRECTIONS NOTED PRIOR TO GENERAL USE
□ TO REVISE & RESUBMIT □ REJECTED & RESUBMIT

SIGNATURE:

WHERE RESUBMISSION IS REQUIRED, SUBMIT REVISED DRAWINGS FOR REVIEW PRIOR TO PROCEEDING WITH WORK
 THIS REVIEW IS FOR GENERAL ARRANGEMENT ONLY AND DOES NOT EXTEND TO DIMENSIONS OF SETTING OUT OF THE WORKS AND DOES NOT RELEASE THE CONTRACTOR OF HIS RESPONSIBILITIES TO ENSURE FULL COMPLIANCE
 THIS REVIEW DOES NOT RELEASE THE CONTRACTOR OF HIS RESPONSIBILITIES TO ENSURE WORKS IN COMPLIANCE TO CONTRACT SPECIFICATION, OTHER DRAWINGS AND STATUTORY REQUIREMENT HAVING JURISDICTION OVER THE INSTALLATION.

DSTA

Defence Science & Technology Agency





EDMUND TEO KUAN WEI

Senior Programme Manager

PEH SEOH CHIN
HCD (Army Camps)

D&B Main Contractor:



29 Harrison Road, Lian Beng Building , Singapore 369648
TEL. No.6283 1468 FAX No. 6280 9360
e-mail : lianbengconstn@pacific.net.sg
Website: www.lianbeng.com.sg

Architect:

ID ARCHITECTS PTE LTD

3 HarbourFront Place, #03-01,
HarbourFront Tower Two,
Singapore 099254
Tel:6225 6011
Fax:6225 6022

general@idarchitects.com.sg www.idarchitects.com.sg ida

Structure

TW- ASIA Consultants Pte Ltd

NO. 28 SIN MING LANE #04-137 MIDVIEW CITY SINGAPORE 573972 TEL : 62916292 FAX : 62932196

M&E Consultar

Pdc Consultants Pte Ltd
MECHANICAL + ELECTRICAL
Paya Lebar Square

#10-17/18 (Office Lobby 1)

60 Paya Lebar Road Singapore 409051 t:6444 7748 f:6444 7141 e:contact@pdcengrs.com

Sub Contractor:

WATERTECH PLUMBING & CONSTRUCTION PTE LTD 30 Kaki Bukit Rd 3 #04-02
Empire TechnoCentre
Singapore 417819

Tel:6444 6855 FAX : 6444 7378

Project No.:

D2019-00162

Project Title:

PROPOSED ADDITIONS OF 1 BLOCK OF 3-STOREY OFFICE BUILDING (BLK 2), 1 BLOCK OF 6-STOREY ACCOMMODATION BUILDING (BLK 3), 1 BLOCK OF 4-STOREY ACCOMMODATION BUILDING (BLK 4), 1 BLOCK OF 2-STOREY TRAINING MULTIPLEX (BLK 9), 1 BLOCK OF MSVS (BLK 10), AND ANCILLARY FACILITIES (BLK 5, 6 & 8) TO EXISTING DIEPPE BARRACK ON LOT 05019M MK13 AT SEMBAWANG ROAD (MANDAI PLANNING AREA)

Drawing title:

BLK 2 3RD STOREY SANITARY DRAWING

	_			
	Initial	Date		
Drawn	SAN	15.08.2024	Scale	AS SHOWN
Checked	TOMMY	15.08.2024	Software	CAD
Drawing no.:				Revision no.:
D2019-00162/BLK 2/S 03				

THIS DRAWING IS COPYRIGHT

THIS DRAWING IS THE PROPERTY OF DSTA. IF FOUND, PLEASE RETURN TO DSTA BUILDING AND INFRASTRUCTURE PROGRAMME CENTRE, 1 DEPOT ROAD, SINGAPORE 109679.

SINGAPORE 109679.
REPRODUCTION OF DRAWING WITHOUT THE WRITTEN PERMISSION OF DSTA BI IS STRICTLY PROHIBITED. ANY UNAUTHORIZED REPRODUCTION OR POSSESSION SHALL BE DEALT WITH UNDER THE OFFICIAL SECRETS ACT.