



3RD STOREY PLAN  
Scale: 1:200

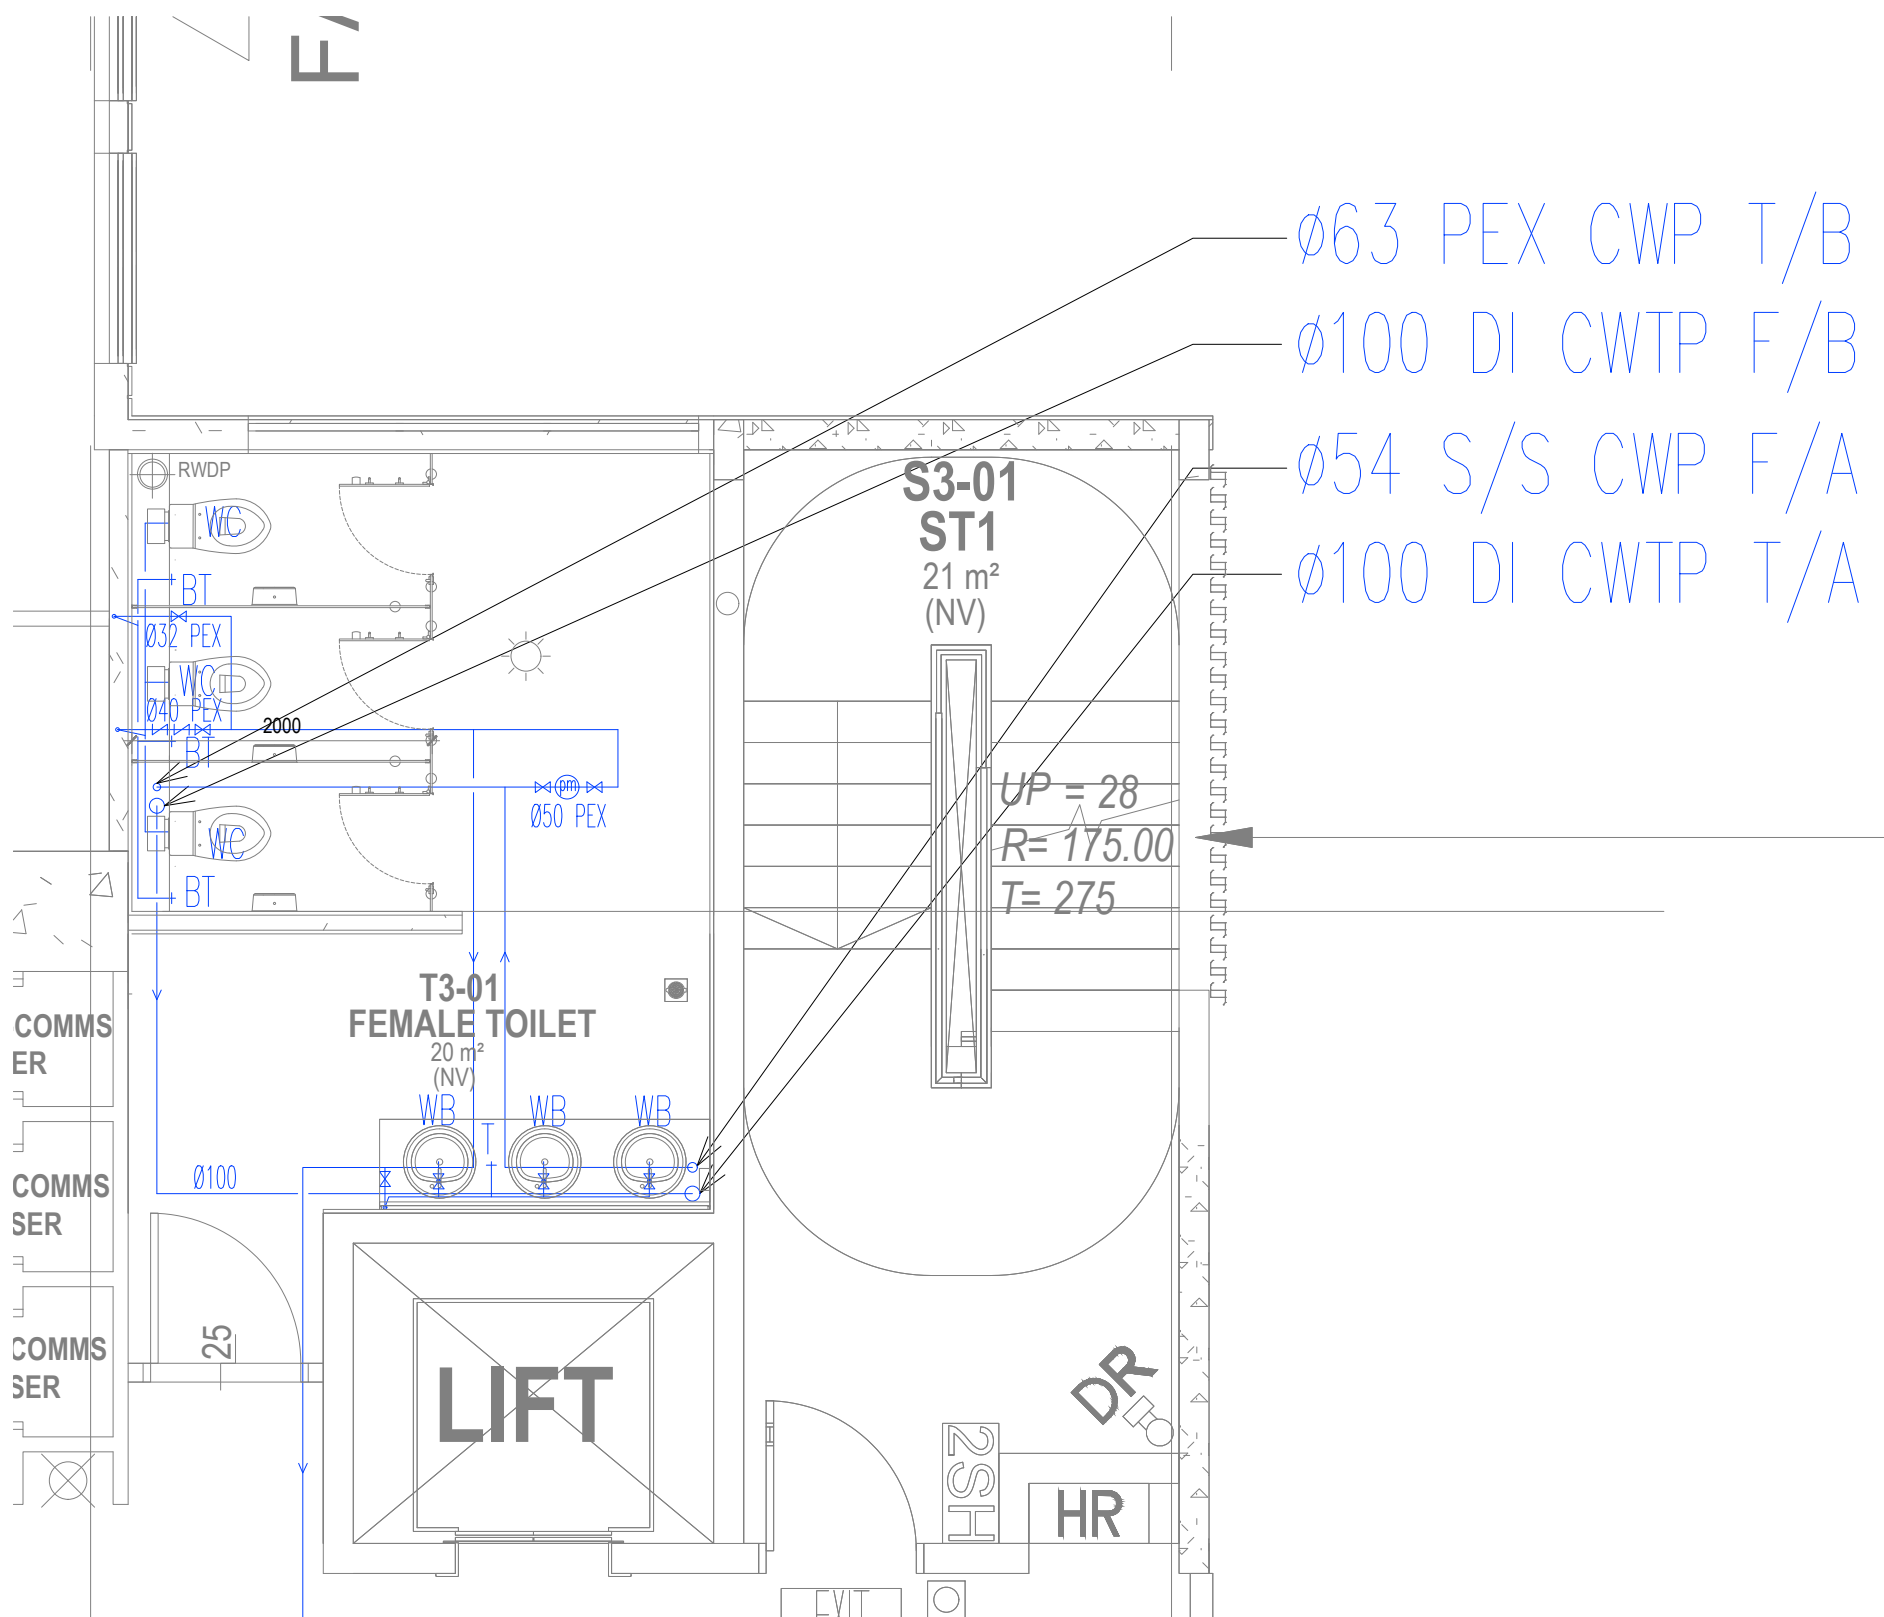

BLOW-UP PLAN 1-1  
Scale: 1:50

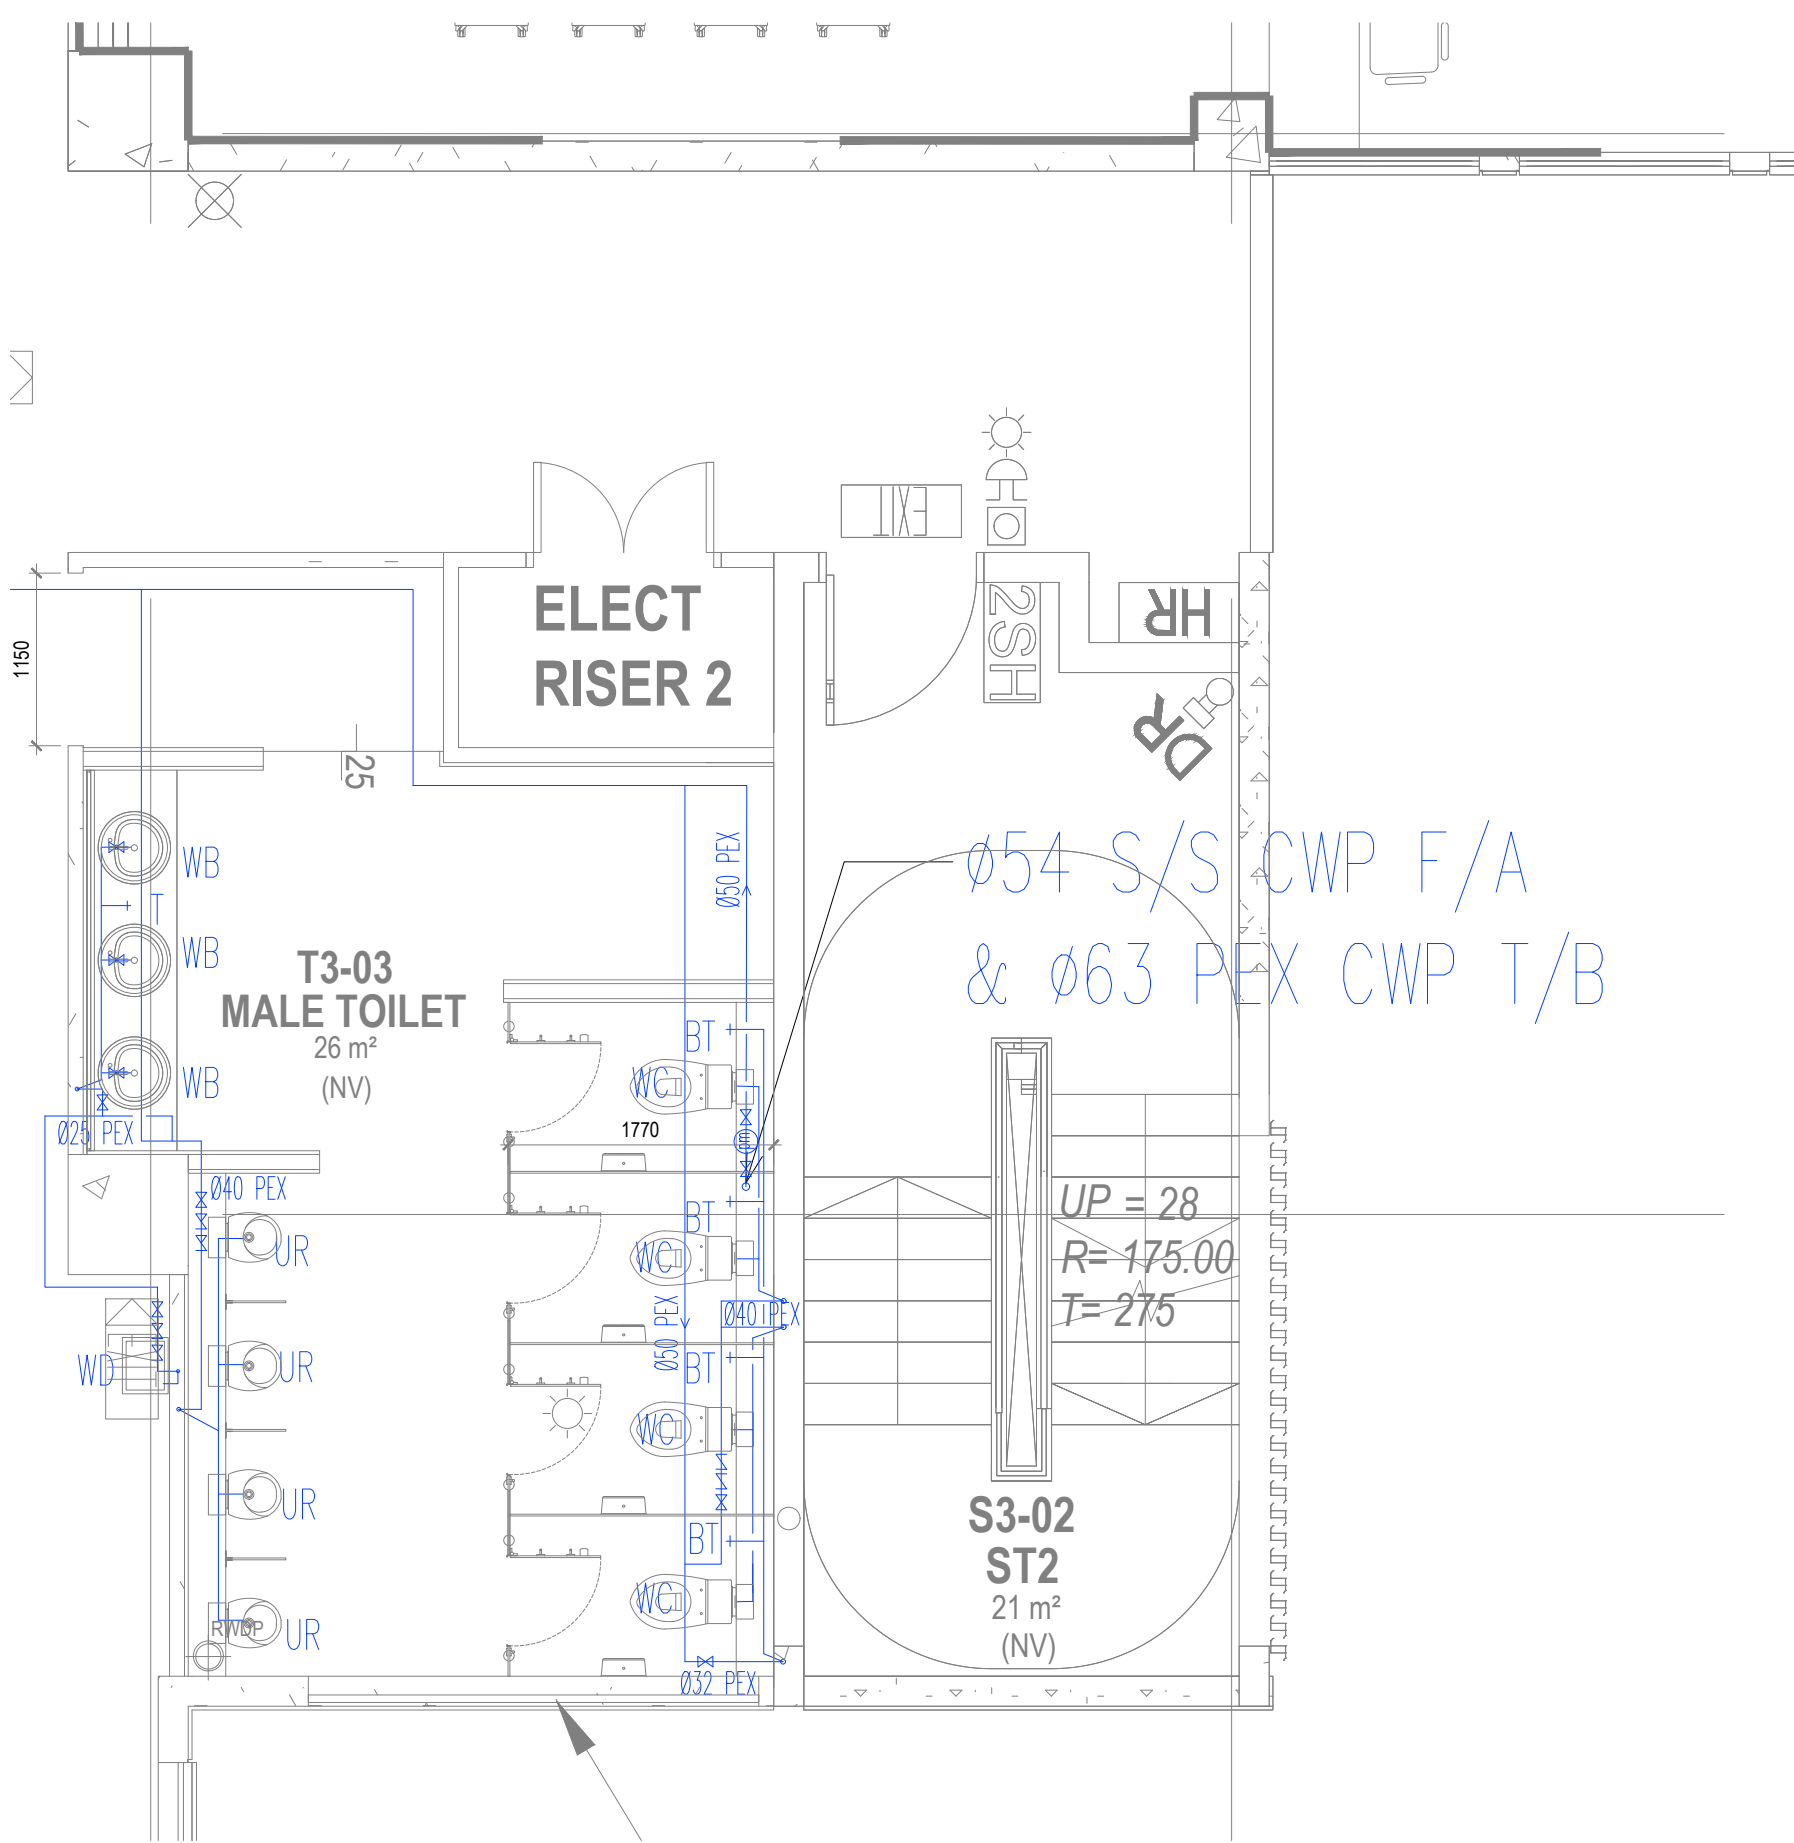

BLOW-UP PLAN 2-2  
Scale: 1:50

M&E CONSULTANTS  
**PdcConsultants Pte Ltd**  
23 NEW INDUSTRIAL ROAD #06-03  
SOLISICE BUSINESS CENTER SINGAPORE 536209  
TEL: 6444 7748  
FAX: 6444 7741

DATE RECEIVED: \_\_\_\_\_ RECEIVED BY: \_\_\_\_\_  
DATE RETURNED: \_\_\_\_\_  
☐ NO EXCEPTION TAKEN ☐ MAKE CORRECTIONS NOTED PRIOR TO GENERAL USE  
☐ TO REVISE & RESUBMIT ☐ REJECTED & RESUBMIT

SIGNATURE: \_\_\_\_\_

- WHERE RESUBMISSION IS REQUIRED, SUBMIT REVISED DRAWINGS FOR REVIEW PRIOR TO PROCEEDING WITH WORK
- THIS REVIEW IS FOR GENERAL ARRANGEMENT ONLY AND DOES NOT EXTEND TO DIMENSIONS OF SETTING OUT OF THE WORKS AND DOES NOT RELEASE THE CONTRACTOR OF HIS RESPONSIBILITIES TO ENSURE FULL COMPLIANCE
- THIS REVIEW DOES NOT RELEASE THE CONTRACTOR OF HIS RESPONSIBILITIES TO ENSURE WORKS IN COMPLIANCE TO CONTRACT SPECIFICATION, OTHER DRAWINGS AND STATUTORY REQUIREMENTS HAVING JURISDICTION OVER THE INSTALLATION.

AS-BUILT DRAWING  
Project Ref. No. : A2105-00599-2022

**DSTA**  
Defence Science & Technology Agency

PEH SEOH CHIN  
LCCD (Army Corps)

EDMUND TED KUAN WEI  
Senior Programme Manager

D&B Main Contractor:  
**DEENN ENGINEERING PTE LTD**  
29 Harrison Road, Lian Beng Building, Singapore 369648  
TEL. No. 6283 1468 FAX No. 6280 9360  
e-mail : lianbengconstn@pacific.net.sg  
Website: www.lianbeng.com.sg

Architect:  
**ID ARCHITECTS PTE LTD**  
3 HarbourFront Place, #03-01,  
HarbourFront Tower Two,  
Singapore 099254  
Tel: 6225 6011  
Fax: 6225 6022  
general@idarchitects.com.sg  
www.idarchitects.com.sg

Structure:  
**TW-ASIA Consultants Pte Ltd**  
NO. 28 SIN MING LANE #04-137 MIDVIEW CITY  
SINGAPORE 573972 TEL : 62916292 FAX : 62932196

M&E Consultant:  
**PdcConsultants Pte Ltd**  
MECHANICAL • ELECTRICAL  
Paya Lebar Square  
#10-17/18 (Office Lobby 1)  
60 Paya Lebar Road Singapore 409051  
t : 6444 7748 f : 6444 7141  
e : contact@pdcengrs.com

Sub Contractor:  
**WATERTech PLUMBING & CONSTRUCTION PTE LTD**  
30 Kallang Road #03-04-02  
Empire TechnoCentre  
Singapore 417819  
Tel: 6444 6855 FAX : 6444 7378

Project No.:  
D2019-00162

Project Title:  
PROPOSED ADDITIONS OF 1 BLOCK OF 3-STORY OFFICE BUILDING BLK 2, 1 BLOCK OF 6-STORY ACCOMMODATION BUILDING BLK 3 (11), 1 BLOCK OF 4-STORY ACCOMMODATION BUILDING BLK 4 (10), 1 BLOCK OF 2-STORY TRAINING MULTIPLEX BLK 9 (6), 1 BLOCK OF MSVS BLK 10 (9), AND ANCILLARY FACILITIES BLK 5, 6(4) & 8 TO EXISTING DIEPPE BARRACK ON LOT 05019M MK13 AT SEMBAWANG ROAD (MANDAI PLANNING AREA)

Drawing title:  
BLK 2 3RD STOREY PLUMBING DRAWING

	Initial	Date	Scale	AS SHOWN
Drawn	SAN	15.08.2024	Scale	AS SHOWN
Checked	TOMMY	15.08.2024	Software	CAD

Drawing no.:  
D2019-00162/WT/LB/BLK2/P03

Revision no.:  
THIS DRAWING IS COPYRIGHT  
THIS DRAWING IS THE PROPERTY OF DSTA. IF FOUND, PLEASE RETURN TO DSTA  
BUILDING AND INFRASTRUCTURE PROGRAMME CENTRE, 1 DEPOT ROAD,  
SINGAPORE 106679  
REPRODUCTION OF DRAWING WITHOUT THE WRITTEN PERMISSION OF DSTA IS  
STRICTLY PROHIBITED. ANY UNAUTHORIZED REPRODUCTION OR POSSESSION  
SHALL BE DEALT WITH UNDER THE OFFICIAL SECRETS ACT.