M&E CONSULTANTS

Pdcconsultants Pte Ltd

23 New INDUSTRIAL ROAD #05-03 TEL: 6444 7748

SOLSTICE BUSINESS CENTER SINGAPORE 536209 FAX: 6444 7141

DATE RECEIVED: RECEIVED BY:

DATE RETURNED:

NO EXCEPTION TAKEN MAKE CORRECTIONS NOTED PRIOR TO GENERAL USE

TO REVISE & RESUBMIT REJECTED & RESUBMIT

SIGNATURE:

● WHERE RESUBMISSION IS REQUIRED, SUBMIT REVISED DRAWINGS FOR REVIEW PRIOR TO PROCEEDING WITH WORK

● THIS REVIEW IS FOR GENERAL ARRANGEMENT ONLY AND DOES NOT EXTEND TO DIMENSIONS OF SETTING OUT OF THE WORKS AND DOES NOT RELEASE THE CONTRACTOR OF HIS RESPONSIBILITIES TO ENSURE FULL COMPLIANC

● THIS REVIEW DOES NOT RELEASE THE CONTRACTOR OF HIS RESPONSIBILITIES TO ENSURE FULL COMPLIANC

TO CONTRACT SPECIFICATION. OTHER DRAWINGS AND STATUTORY REQUIREMENT HAVING JURISDICTION OVER THE

AS-BUILT DRAWING

Project Ref. No. : A2105-00599-2022







SEOH CHIN

&B Main Contractor:

EDMUND TEO KUAN WEI Senior Programme Manager



TEL. No.6283 1468 FAX No. 6280 9360 e-mail : lianbengconstn@pacific.net.sg
Website: www.lianbeng.com.sg

Architect:

ID ARCHITECTS PTE LTD

3 HarbourFront Place, #03-01,
HarbourFront Tower Two,

3 HarbourFront Place, #03-01, HarbourFront Tower Two, Singapore 099254 Tel:6225 6011 Fax:6225 6022 general@idarchitects.com.sg www.idarchitects.com.sg

Iro.



M&E Consultant:



Pdc Consultants Pte Ltd

MECHANICAL + ELECTRICAL

Paya Lebar Square

Paya Lebar Square #10-17/18 (Office Lobby 1) 60 Paya Lebar Road Singapore 409051 t: 6444 7748 f: 6444 7141 e: contact@pdcengrs.com

WATERTECH PLUMBING & CONSTRUCTION PTE LTD 30 Kaki Bukit Rd 3 #04-02
Empire TechnoCentre
Singapore 417819
Tel:6444 6855 FAX: 6444 7378

Project No.:

D2019-00162

Project Title:

PROPOSED ADDITIONS OF 1 BLOCK OF 3-STOREY OFFICE BUILDING BLK 2, 1 BLOCK OF 6-STOREY ACCOMMODATION BUILDING BLK 3 (11), 1 BLOCK OF 4-STOREY ACCOMMODATION BUILDING BLK 4 (10), 1 BLOCK OF 2-STOREY TRAINING MULTIPLEX BLK 9 (6), 1 BLOCK OF MSVS BLK 10 (9), AND ANCILLARY FACILITIES BLK 5, 6(4) & 8 TO EXISTING DIEPPE BARRACK ON LOT 05019M MK13 AT SEMBAWANG ROAD (MANDAI PLANNING AREA)


Drawing title:

BLK 2 ROOF SANITARY DRAWING

	Initial	Date		
Drawn	SAN	15.08.2024	Scale	AS SHOWN
Checked	TOMMY	15.08.2024	Software	CAD
Drawing no.:				Revision no.:
D2019-0	0162/WT/LE	B/BLK2/P04		

THIS DRAWING IS COPYRIGHT
THIS DRAWING IS THE PROPERTY OF DSTA. IF FOUND, PLEASE RETURN TO DSTA
BUILDING AND INFRASTRUCTURE PROGRAMME CENTRE, 1 DEPOT ROAD,

SINGAPORE 109679.
REPRODUCTION OF DRAWING WITHOUT THE WRITTEN PERMISSION OF DSTA BI IS STRICTLY PROHIBITED. ANY UNAUTHORIZED REPRODUCTION OR POSSESSION SHALL BE DEALT WITH UNDER THE OFFICIAL SECRETS ACT.

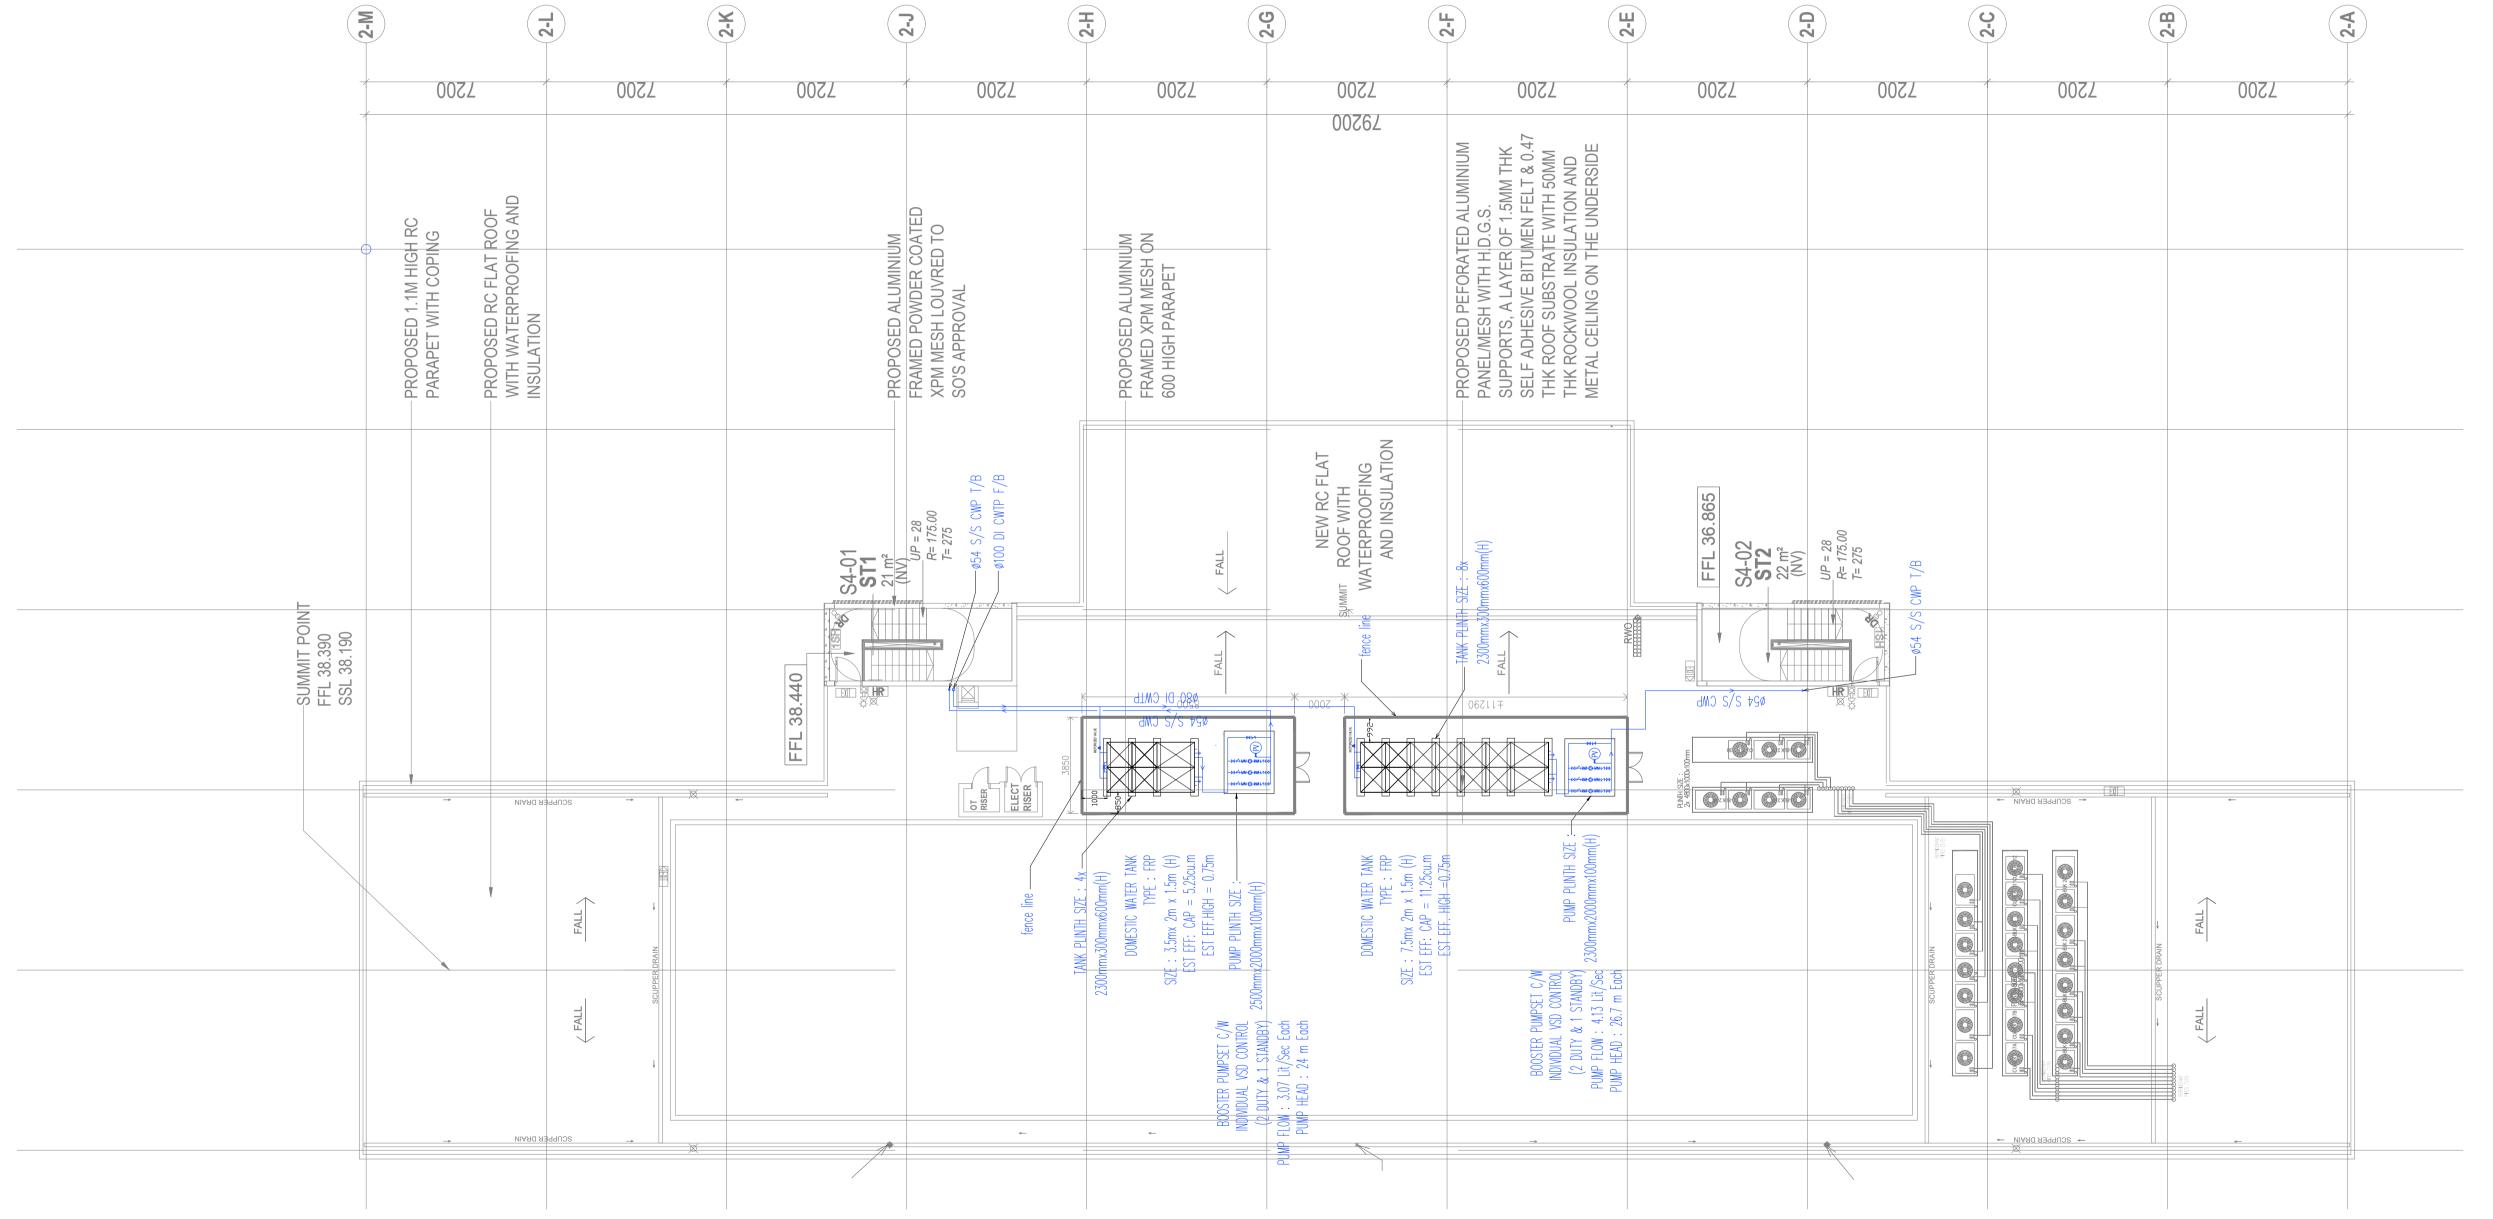

ROOF PLAN

Scale: 1:150