


BLK 2 - LEVEL 3 MEETING ROOM 03-07
SCALE 1:100

LEGEND & SYMBOL

P1	LASER PROJECTOR C/W MTG BRACKET 4200 ANSI LUMENS : WXGA RESOLUTION EB-L200W (EPSON/JAPAN) DIM : 325(W) x 90(H) x 299(D)mm
MS	MOTORISED SCREEN - 3000(W) X 3000(H) IMAGE SIZE : 3000(W) X 1685(H), 16:9 CLASS 10 (LAV/SINGAPORE) CASING DIM : 3138(W) x 156(H) x 134(D)mm
	5" FULL RANGE CEILING SPEAKER, 30W/100V F-2322C (TOA/JAPAN) DIM : 230(DIA) x 200(H)mm
AV 1	TWO INPUT DTP TRANSMITTER FOR HDMI & VGA DTP T UWP 4K 232 D (EXTRON/USA) DIM : 89(W) x 107(H) x 48(D)mm
LAN	LAN RECEPTACLE SINGLE GANG SIZE
S	UP/DOWN SWITCH SINGLE GANG SIZE
Dimmer	4 CHANNEL BALLAST CONTROLLER, POWER SUPPLY UNIT, RS232 AV INTERFACE HOUSE IN ENCLOSURE 474 / 402 / 503 (HELVAR / FINLAND) DIM : 480(W) x 380(H) x 110(D)mm
	10 BUTTON CONTROL PANEL 166SS (HELVAR/FINLAND) DIM : 86(W) x 86(H) x 17(D)mm
	13A 1-GANG SWITCH SOCKET OUTLET
20A	20A ISOLATOR
TP	5" WIRED TOUCHPANEL TLP PRO 525T (EXTRON/USA) DIM : 151(W) x 99(H) x 73(D)mm
RACK 22U	19" EQUIPMENT RACK DIM : 600(W) x 1180-22U(H) x 600(D)mm

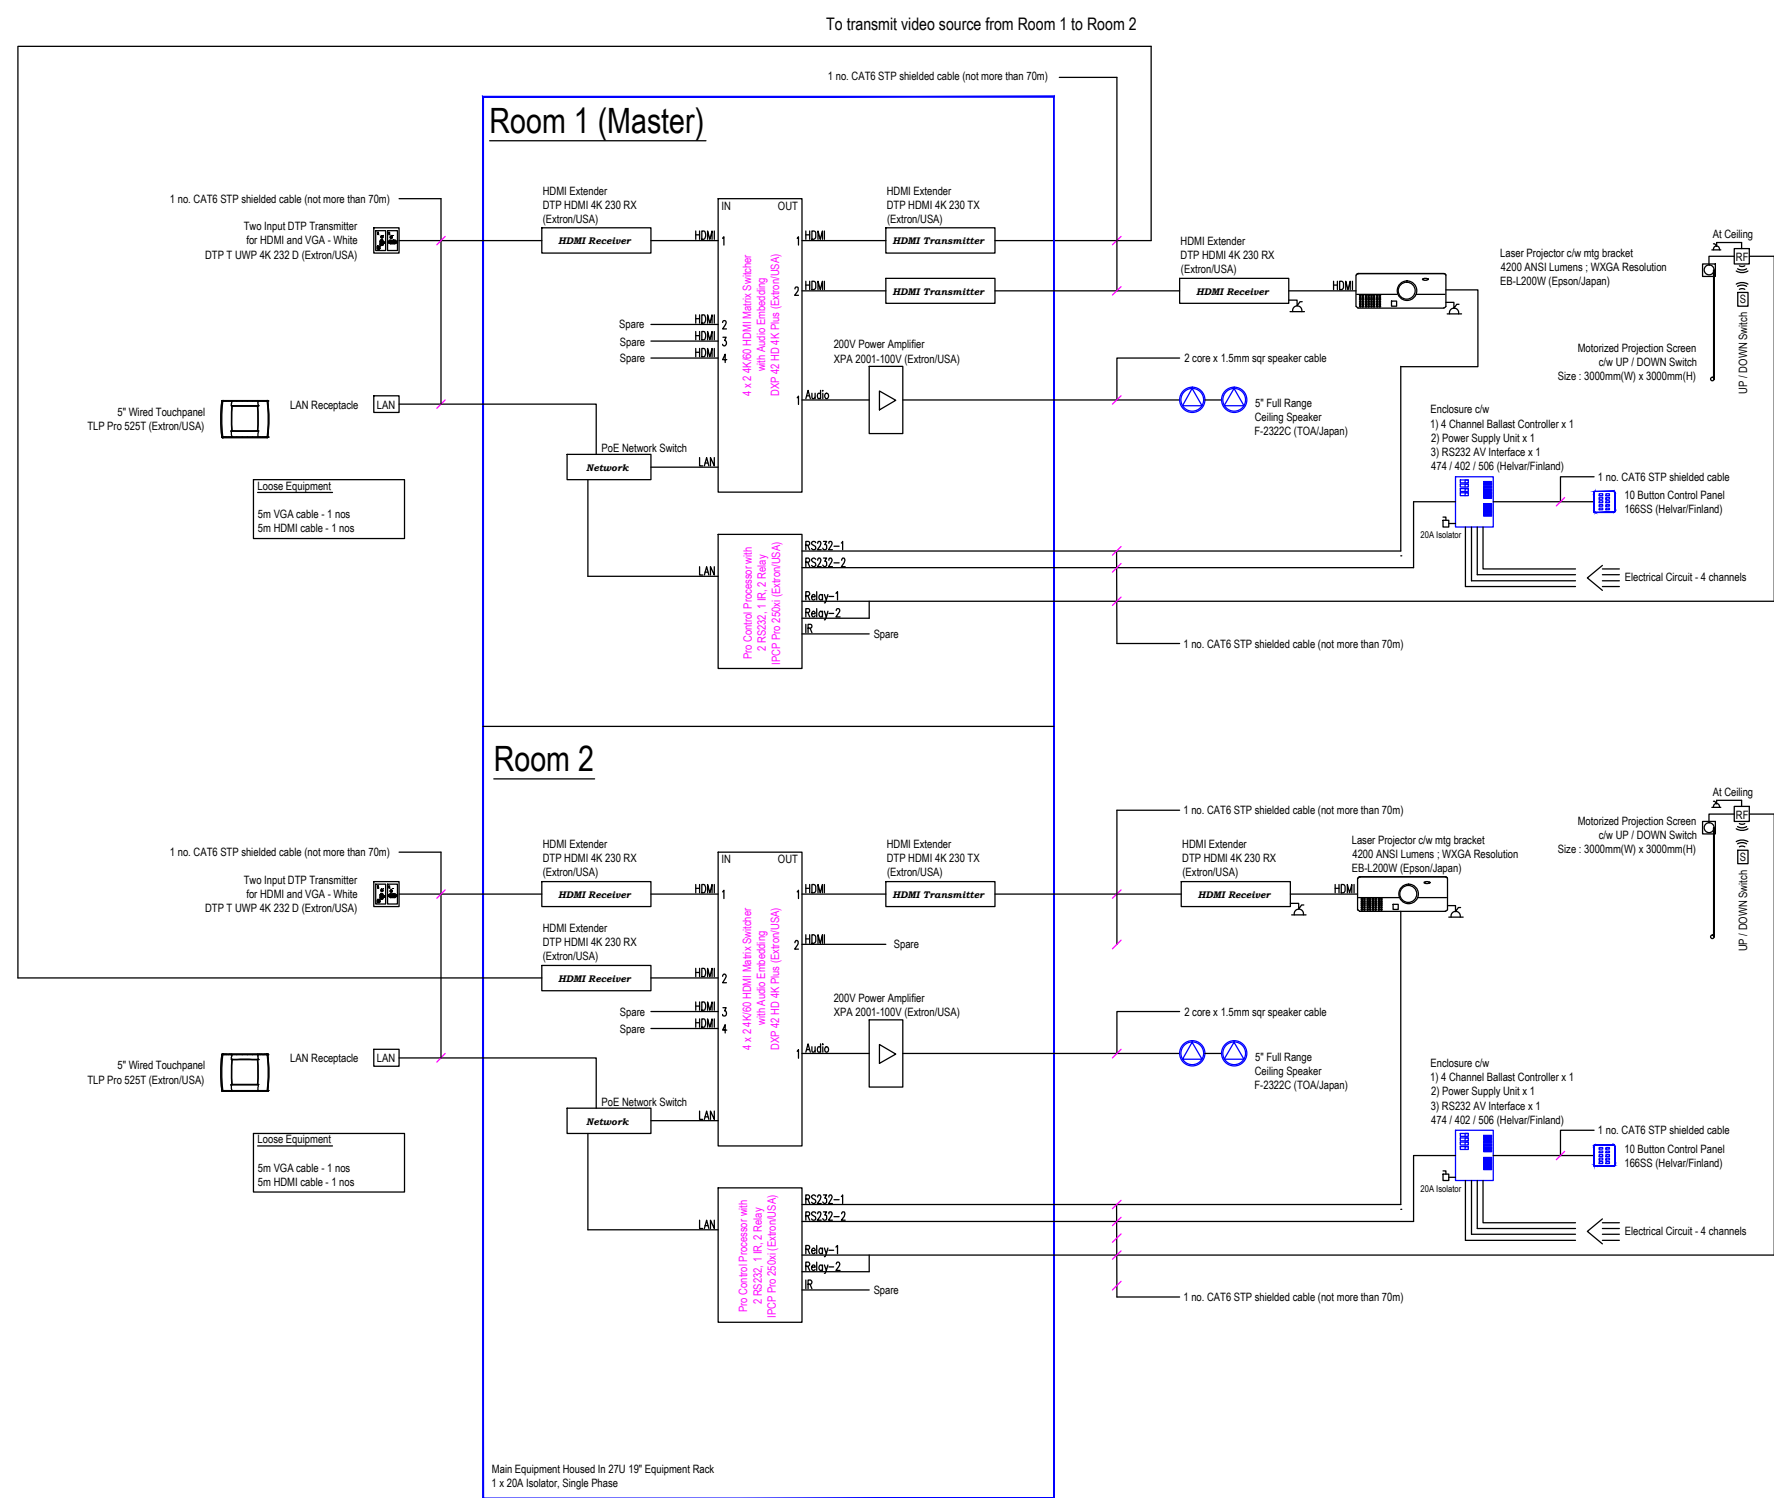


AUDIO VISUAL SYSTEM
BLK 2 - LEVEL 3 MEETING ROOM 03-07

18 July
Commented to add 1 more projector.
Added 1 projector, 1 screen, 1 set of DTP hdmi extender. Upgrade the
control processor from IPCP PRO 250x to IPCP PRO 350x.

AS BUILT DRAWING

DEVELOPER:

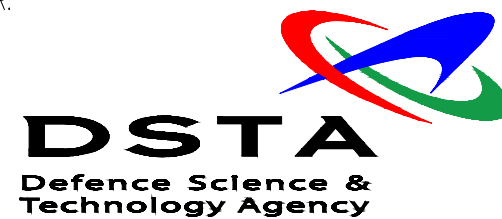

VYNNA PEH SEOH
CHIN

HCD (Army Camps)

Edmund Teo
Kuan Wei

Senior Programme Manager

Project No.:

D2019-00162

D&B MAIN CONTRACTOR:

DEENN ENGINEERING PTE LTD
29 Harrison Road, Lian Beng Building, Singapore 369648
TEL. No.6283 1468 FAX No. 6280 9360
e-mail : lianbengconstn@pacific.net.sg
Website: www.lianbeng.com.sg

ARCHITECT CONSULTANT:

ID ARCHITECTS PTE LTD
3 Harbourfront Place, #03-01
Harbourfront Tower Two
Singapore 099254
Tel: 6225 4011 Fax: 6225 4022
Email: general@idarchitects.com.sg
www.idarchitects.com.sg

STRUCTURE CONSULTANT:

TW-ASIA Consultants Pte Ltd

NO. 25, SIN MING LANE #04-137 MINDEN CITY
SINGAPORE 573972 TEL : 62916292 FAX : 62933296

M&E Consultant:

PdcConsultants Pte Ltd
23 New Industrial Road #06-03
Solstice Business Center
Singapore 536209
t: 6444 7748 f: 6444 7141
e: contact@pdcengrs.com

Sub Contractor:

CHIN SENG ENGINEERING (S) PTE LTD
33 Ubi Avenue 3, Vertex Tower B, #08-27, Singapore 408668
TEL: 6742 9392 FAX: 6742 9390

Project Title:

PROPOSED ADDITIONS OF 1 BLOCK OF 3-STORY OFFICE
BUILDING BLK 2, 1 BLOCK OF 6-STORY ACCOMMODATION
BUILDING BLK 3 (11), 1 BLOCK OF 4-STORY ACCOMMODATION
BUILDING BLK 4 (10), 1 BLOCK OF 2-STORY TRAINING
MULTIPLEX BLK 9 (6), 1 BLOCK OF MSVS BLK 10 (9), AND
ANCILLARY FACILITIES BLK 5, 6(4) & 8 TO EXISTING DIEPPE
BARRACK ON LOT 05019M MK13 AT SEMBAWANG ROAD (MANDAI
PLANNING AREA)

Drawing Title:

AUDIO VISUAL SYSTEM
BLOCK 2 - LEVEL 3 MEETING ROOM 03-07

Initial	Date	Job ref no.
Designed JEFFREY	08/09/2023	
Checked JEFFREY	08/09/2023	
Drawn KHANG	08/09/2023	Filename
Software CAD		
Scale AS: SHOWN	Sources	
Drawing no. D2019-00162/ELECT/BLK2/AV/06		B
		Revision

THIS DRAWING IS COPYRIGHT
THIS DRAWING IS THE PROPERTY OF DSTA. IF FOUND, PLEASE RETURN TO
DSTA BUILDING AND INFRASTRUCTURE PROGRAMME CENTRE,
1 DEPOT ROAD, SINGAPORE 109679.
REPRODUCTION OF DRAWING WITHOUT THE WRITTEN PERMISSION OF DSTA IS
STRICTLY PROHIBITED. ANY UNAUTHORIZED REPRODUCTION OR POSSESSION
SHALL BE DEALT WITH UNDER THE OFFICIAL SECRETS ACT.