



2-2

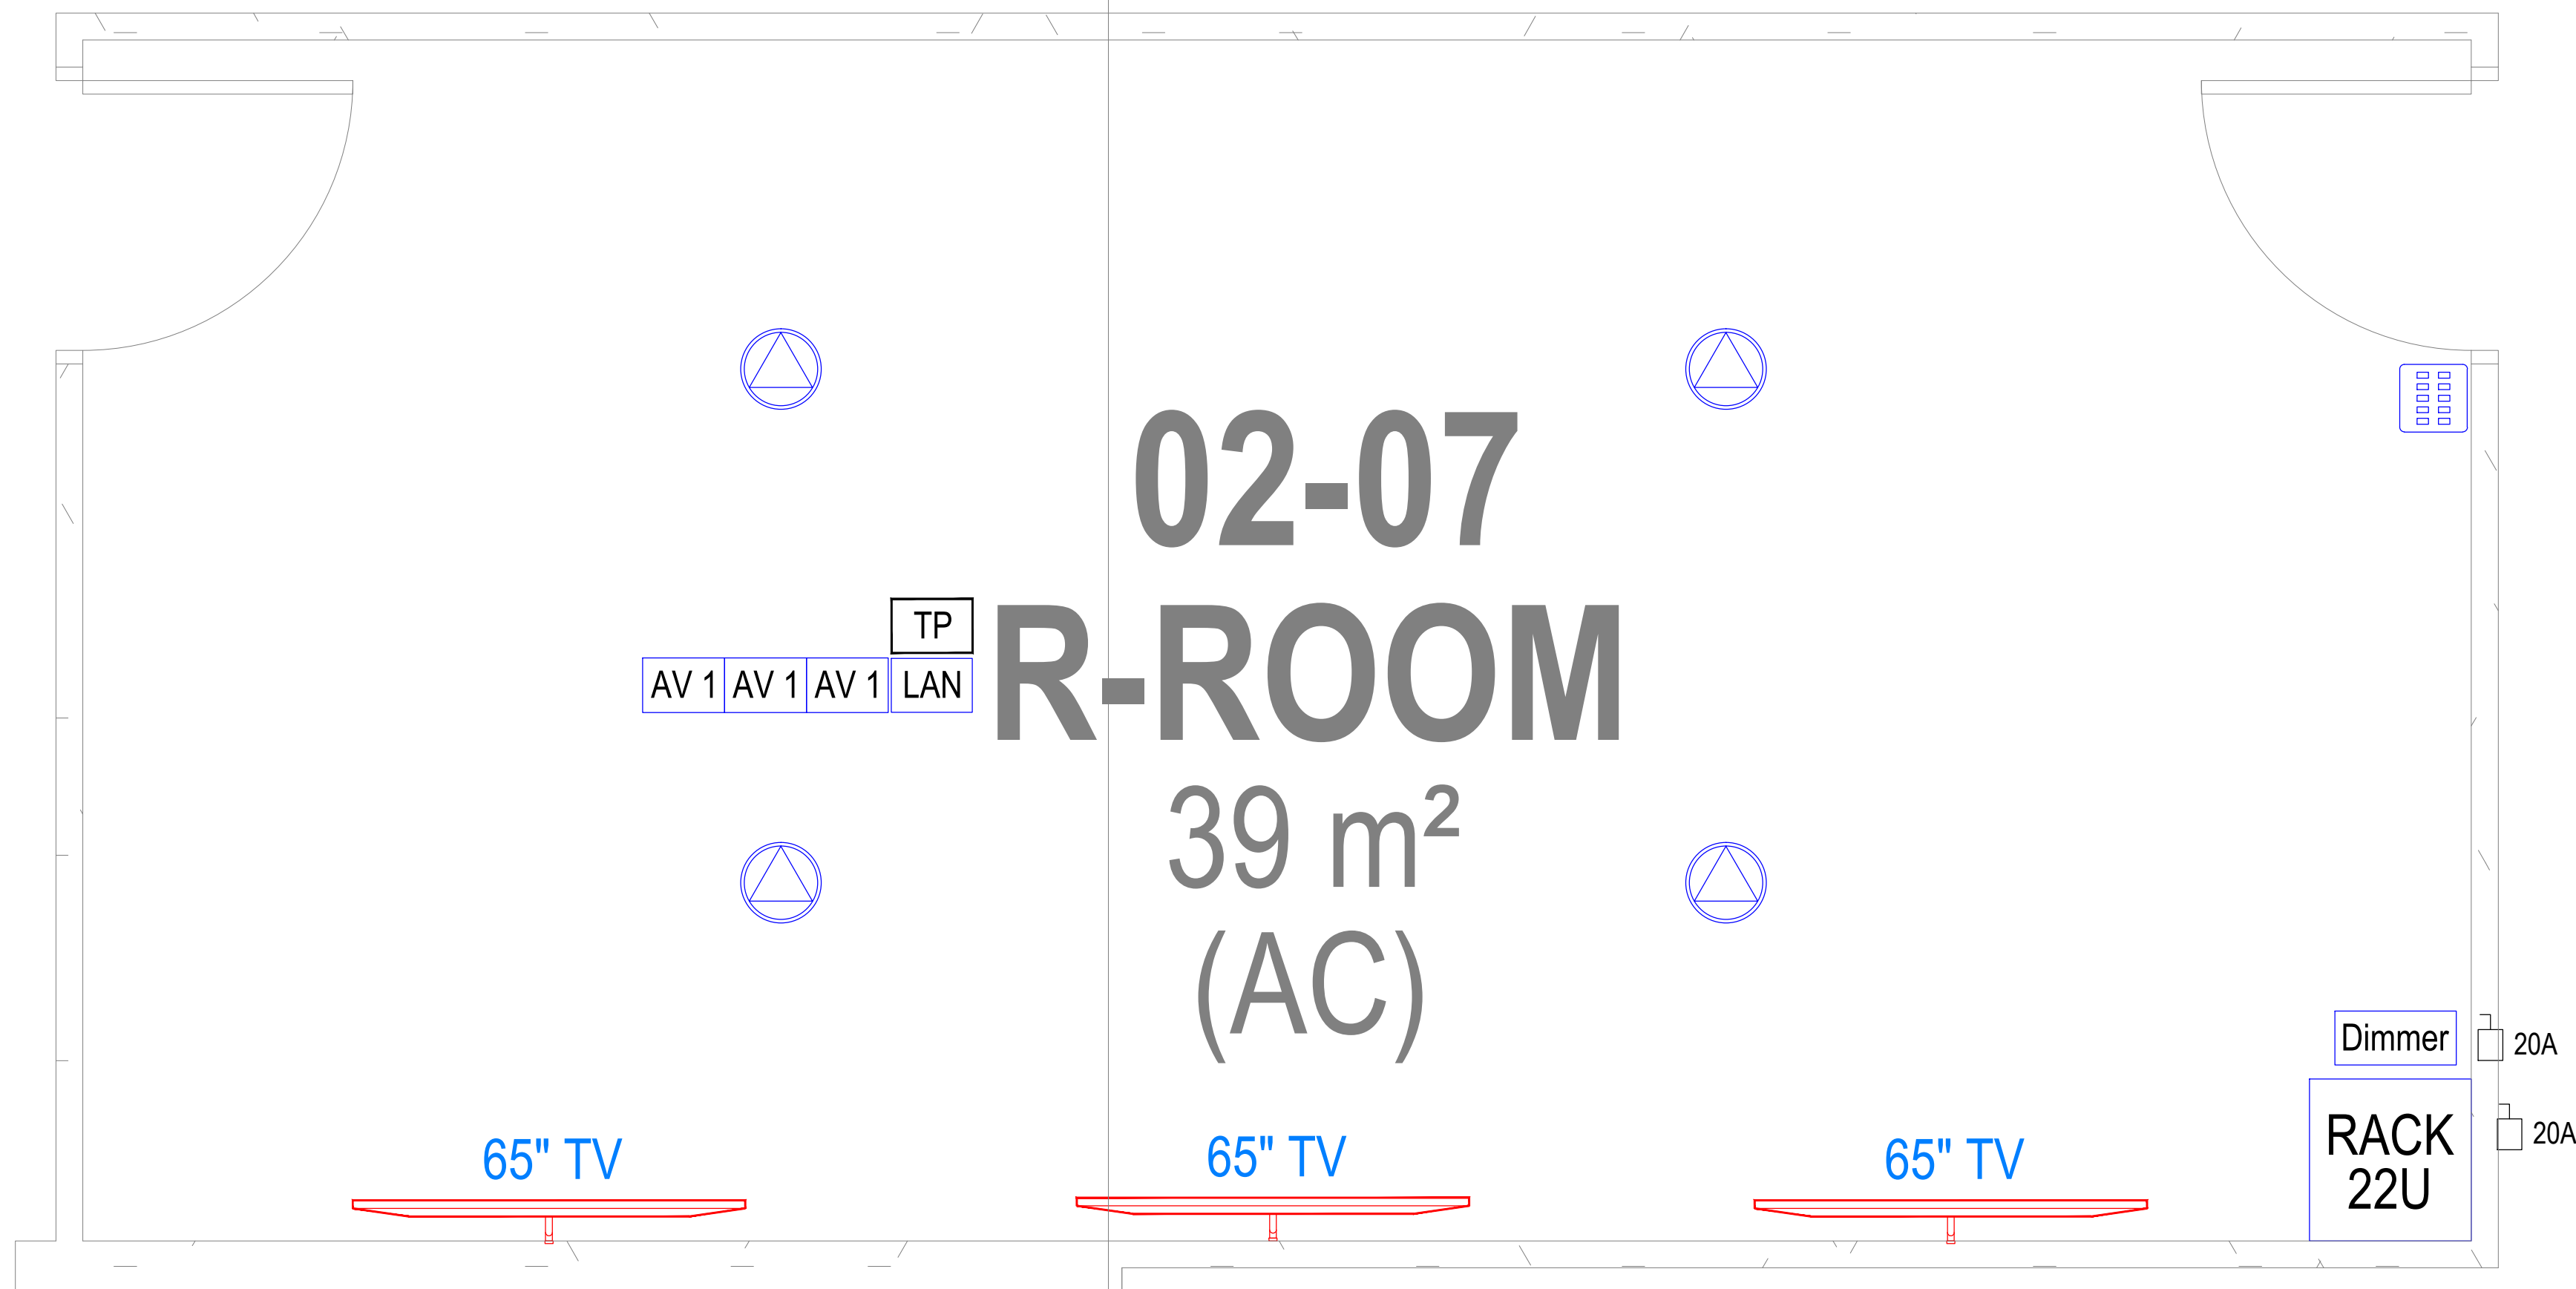

BLK 2 - LEVEL 2 R-ROOM 02-07  
SCALE 1:100

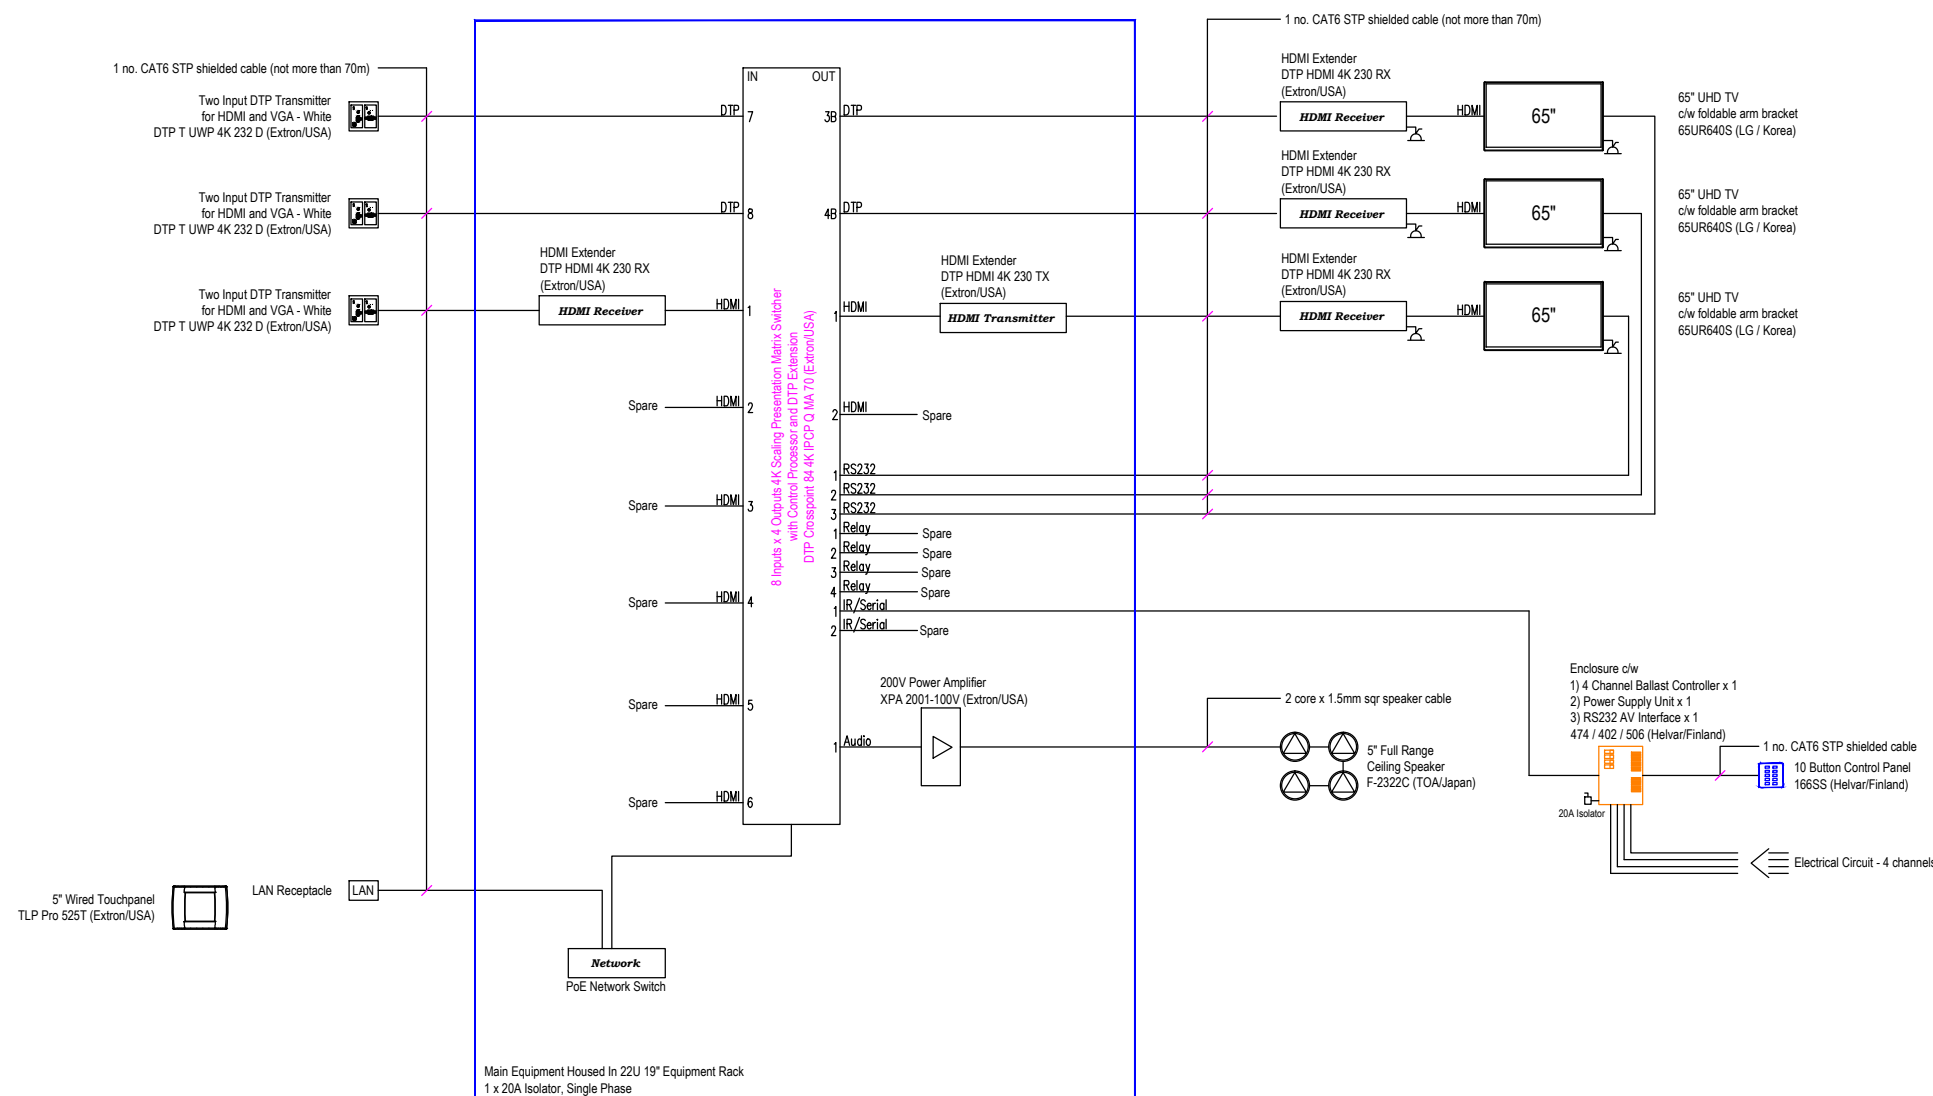

AUDIO VISUAL SYSTEM  
BLK 2 - LEVEL 2 R-ROOM 02-07

LEGEND & SYMBOL

	65" COMMERCIAL UHD TV C/W FOLDABLE ARM BRACKET 65UR640S (LG/KOREA) DIM : 1454(W) x 838(H) x 57.7(D)mm
	5" FULL RANGE CEILING SPEAKER, 30W/100V F-2322C (TOA/JAPAN) DIM : 230(DIA) x 200(H)mm
	TWO INPUT DTP TRANSMITTER FOR HDMI & VGA DTP T UWP 4K 232 D (EXTRON/USA) DIM : 89(W) x 107(H) x 48(D)mm
	LAN RECEPTACLE SINGLE GANG SIZE
	4 CHANNEL BALLAST CONTROLLER, POWER SUPPLY UNIT, RS232 AV INTERFACE HOUSE IN ENCLOSURE 474 / 402 / 503 (HELVAR / FINLAND) DIM : 480(W) x 380(H) x 110(D)mm
	10 BUTTON CONTROL PANEL 166SS (HELVAR/FINLAND) DIM : 86(W) x 86(H) x 17(D)mm
	19" EQUIPMENT RACK DIM : 600(W) x 1180-22U(H) x 600(D)mm
	13A 1-GANG SWITCH SOCKET OUTLET
	20A ISOLATOR
	5" WIRED TOUCHPANEL TLP PRO 525T (EXTRON/USA) DIM : 151(W) x 99(H) x 73(D)mm

AS BUILT DRAWING

DEVELOPER:



VYNNA PEH SEOH  
CHIN

HCD (Army Camps)

Edmund Teo  
Kuan Wei

Senior Programme Manager

Project No.:

D2019-00162

D&B MAIN CONTRACTOR:

**DEENN ENGINEERING PTE LTD**  
29 Harrison Road, Lian Beng Building, Singapore 369648  
TEL: No.6283 1468 FAX No. 6280 9360  
e-mail : lianbengconstn@pacific.net.sg  
Website: www.lianbeng.com.sg

ARCHITECT CONSULTANT:

**ID ARCHITECTS PTE LTD**  
3 Harbourfront Place, #03-01  
Harbourfront Tower Two  
Singapore 099254  
Tel: 6225 4011 Fax: 6225 4022  
Email: general@idarchitects.com.sg  
www.idarchitects.com.sg

STRUCTURE CONSULTANT:

TW-ASIA Consultants Pte Ltd

NO. 25, SIN MING LANE #04-137 MINDEN CITY  
SINGAPORE 573972 TEL : 62916292 FAX : 62933296

M&E Consultant:

**PdcConsultants Pte Ltd**  
23 New Industrial Road #06-03  
Solstice Business Center  
Singapore 536209  
t : 6444 7748 f: 6444 7141  
e: contact@pdcengrs.com

Sub Contractor:

CHIN SENG ENGINEERING (S) PTE LTD

33 Ubi Avenue 3, Vertex Tower B, #08-27, Singapore 408868  
TEL: 6742 9392 FAX: 6742 9390

Project Title:

PROPOSED ADDITIONS OF 1 BLOCK OF 3-STORY OFFICE  
BUILDING BLK 2, 1 BLOCK OF 6-STORY ACCOMMODATION  
BUILDING BLK 3 (11), 1 BLOCK OF 4-STORY ACCOMMODATION  
BUILDING BLK 4 (10), 1 BLOCK OF 2-STORY TRAINING  
MULTIPLEX BLK 9 (6), 1 BLOCK OF MSVS BLK 10 (9), AND  
ANCILLARY FACILITIES BLK 5, 6(4) & 8 TO EXISTING DIEPPE  
BARRACK ON LOT 05019M MK13 AT SEMBANG ROAD (MANDAI  
PLANNING AREA)

Drawing Title:

AUDIO VISUAL SYSTEM  
BLOCK 2 - LEVEL 2 R-ROOM 02-07

	Initial	Date	Job ref no.
Designed	JEFFREY	08/09/2023	
Checked	JEFFREY	08/09/2023	
Drawn	KHANG	08/09/2023	Filename
Software	CAD		
Scale	1:300	Sources	
Drawing no.	D2019-00162/ELECT/BLK2/AV/10		

THIS DRAWING IS COPYRIGHT  
THIS DRAWING IS THE PROPERTY OF DSTA. IF FOUND, PLEASE RETURN TO  
DSTA BUILDING AND INFRASTRUCTURE PROGRAMME CENTRE,  
1 DEPOT ROAD, SINGAPORE 109679.  
REPRODUCTION OF DRAWING WITHOUT THE WRITTEN PERMISSION OF DSTA BI  
IS STRICTLY PROHIBITED. ANY UNAUTHORIZED REPRODUCTION OR POSSESSION  
SHALL BE DEALT WITH UNDER THE OFFICIAL SECRETS ACT.