

AS BUILT DRAWING

DEVELOPER:



LYNNA PEH SEOH
CHIN

HCD (Army Camps)

Edmund Teo
Kuan Wei

Senior Programme Manager

D&B MAIN CONTRACTOR:

DEENN ENGINEERING PTE LTD
29 Harrison Road, Lian Beng Building, Singapore 369648
TEL: No.6283 1468 FAX No. 6280 9360
e-mail : lianbengconstn@pacific.net.sg
Website: www.lianbeng.com.sg

ARCHITECT CONSULTANT:

ID ARCHITECTS PTE LTD
3 Harbourfront Place, #03-01
Harbourfront Tower Two
Singapore 099254
Tel: 6225 4011 Fax: 6225 4022
Email: general@idarchitects.com.sg
www.idarchitects.com.sg



STRUCTURE CONSULTANT:

TW-ASIA Consultants Pte Ltd

NO. 25, SUN MING LANE #04-137 MINDEN CITY
SINGAPORE 573972 TEL : 62916292 FAX : 629332 95

M&E Consultant:

PdcConsultants Pte Ltd
23 New Industrial Road #06-03
Solstice Business Center
Singapore 536209
t : 6444 7745 f: 6444 7141
e: contact@pdcengrs.com

Sub Contractor:

CHIN SENG ENGINEERING (S) PTE LTD

33 Ulu Avenue 3, Vertex Tower B, #08-27, Singapore 408868
TEL: 6742 9392 FAX: 6742 9390

Project Title:

PROPOSED ADDITIONS OF 1 BLOCK OF 3-STORY OFFICE
BUILDING BLK 2, 1 BLOCK OF 6-STORY ACCOMMODATION
BUILDING BLK 3 (11), 1 BLOCK OF 4-STORY ACCOMMODATION
BUILDING BLK 4 (10), 1 BLOCK OF 2-STORY TRAINING MULTIPLEX
BLK 9 (6), 1 BLOCK OF MSVS BLK 10 (9), AND ANCILLARY
FACILITIES BLK 5, 6(4) & 8 TO EXISTING DIEPPE BARRACK ON LOT
05019M MK13 AT SEMBAWANG ROAD (MANDAI PLANNING AREA)

Drawing Title:


AUDIO VISUAL SYSTEM
BLOCK 2 - LEVEL 1 DC ROOM 01-14

	Initial	Date	Job ref no.
Designed	JEFFREY	4/06/2024	
Checked	JEFFREY	4/06/2024	
Drawn	KHANG	4/06/2024	Filename
Software	CAD		
Scale	AS SHOWN	Sources	
Drawing no.	D2019-00162/ELECT/BLK2/AV/02		

THIS DRAWING IS COPYRIGHT
THIS DRAWING IS THE PROPERTY OF DSTA. IF FOUND, PLEASE RETURN TO
DSTA BUILDING AND INFRASTRUCTURE PROGRAMME CENTRE,
1 DEPOT ROAD, SINGAPORE 109679.
REPRODUCTION OF DRAWING WITHOUT THE WRITTEN PERMISSION OF DSTA BI
IS STRICTLY PROHIBITED. ANY UNAUTHORIZED REPRODUCTION OR POSSESSION
SHALL BE DEALT WITH UNDER THE OFFICIAL SECRETS ACT.

LEGEND & SYMBOL


P2	5200 ANSI LUMENS ; WUXGA RESOLUTION EB-L520U (EPSON/JAPAN)
MS	MOTORISED SCREEN - 6000(W) X 6000(H) IMAGE SIZE : 6000(W) X 3750(H), 16:10 HARIZ MEGAVIEW (LAV/SINGAPORE) CASING DIM : 6359(W) x 274(H) x 254(D)mm
	5" FULL RANGE CEILING SPEAKER, 30W/100V F-2322C (TOA/JAPAN) DIM : 230(DIA) x 200(H)mm
AV 1	TWO INPUT DTP TRANSMITTER FOR HDMI & VGA DTP T UWP 4K 232 D (EXTRON/USA) DIM : 89(W) x 107(H) x 48(D)mm
LAN	LAN RECEPTACLE SINGLE GANG SIZE
S	UP/DOWN SWITCH SINGLE GANG SIZE
Dimmer	4 CHANNEL BALLAST CONTROLLER, POWER SUPPLY UNIT, RS232 AV INTERFACE HOUSE IN ENCLOSURE 474 / 402 / 503 (HELVAR / FINLAND) DIM : 480(W) x 380(H) x 110(D)mm
	10 BUTTON CONTROL PANEL 166SS (HELVAR/FINLAND) DIM : 86(W) x 86(H) x 17(D)mm
RACK 22U	19" EQUIPMENT RACK DIM : 600(W) x 1180-22U(H) x 600(D)mm
TP	10" WIRED TOUCHPANEL TLP PRO 1025T (EXTRON/USA) DIM : 257(W) x 174(H) x 105(D)mm
	13A 1-GANG SWITCH SOCKET OUTLET
20A	20A ISOLATOR

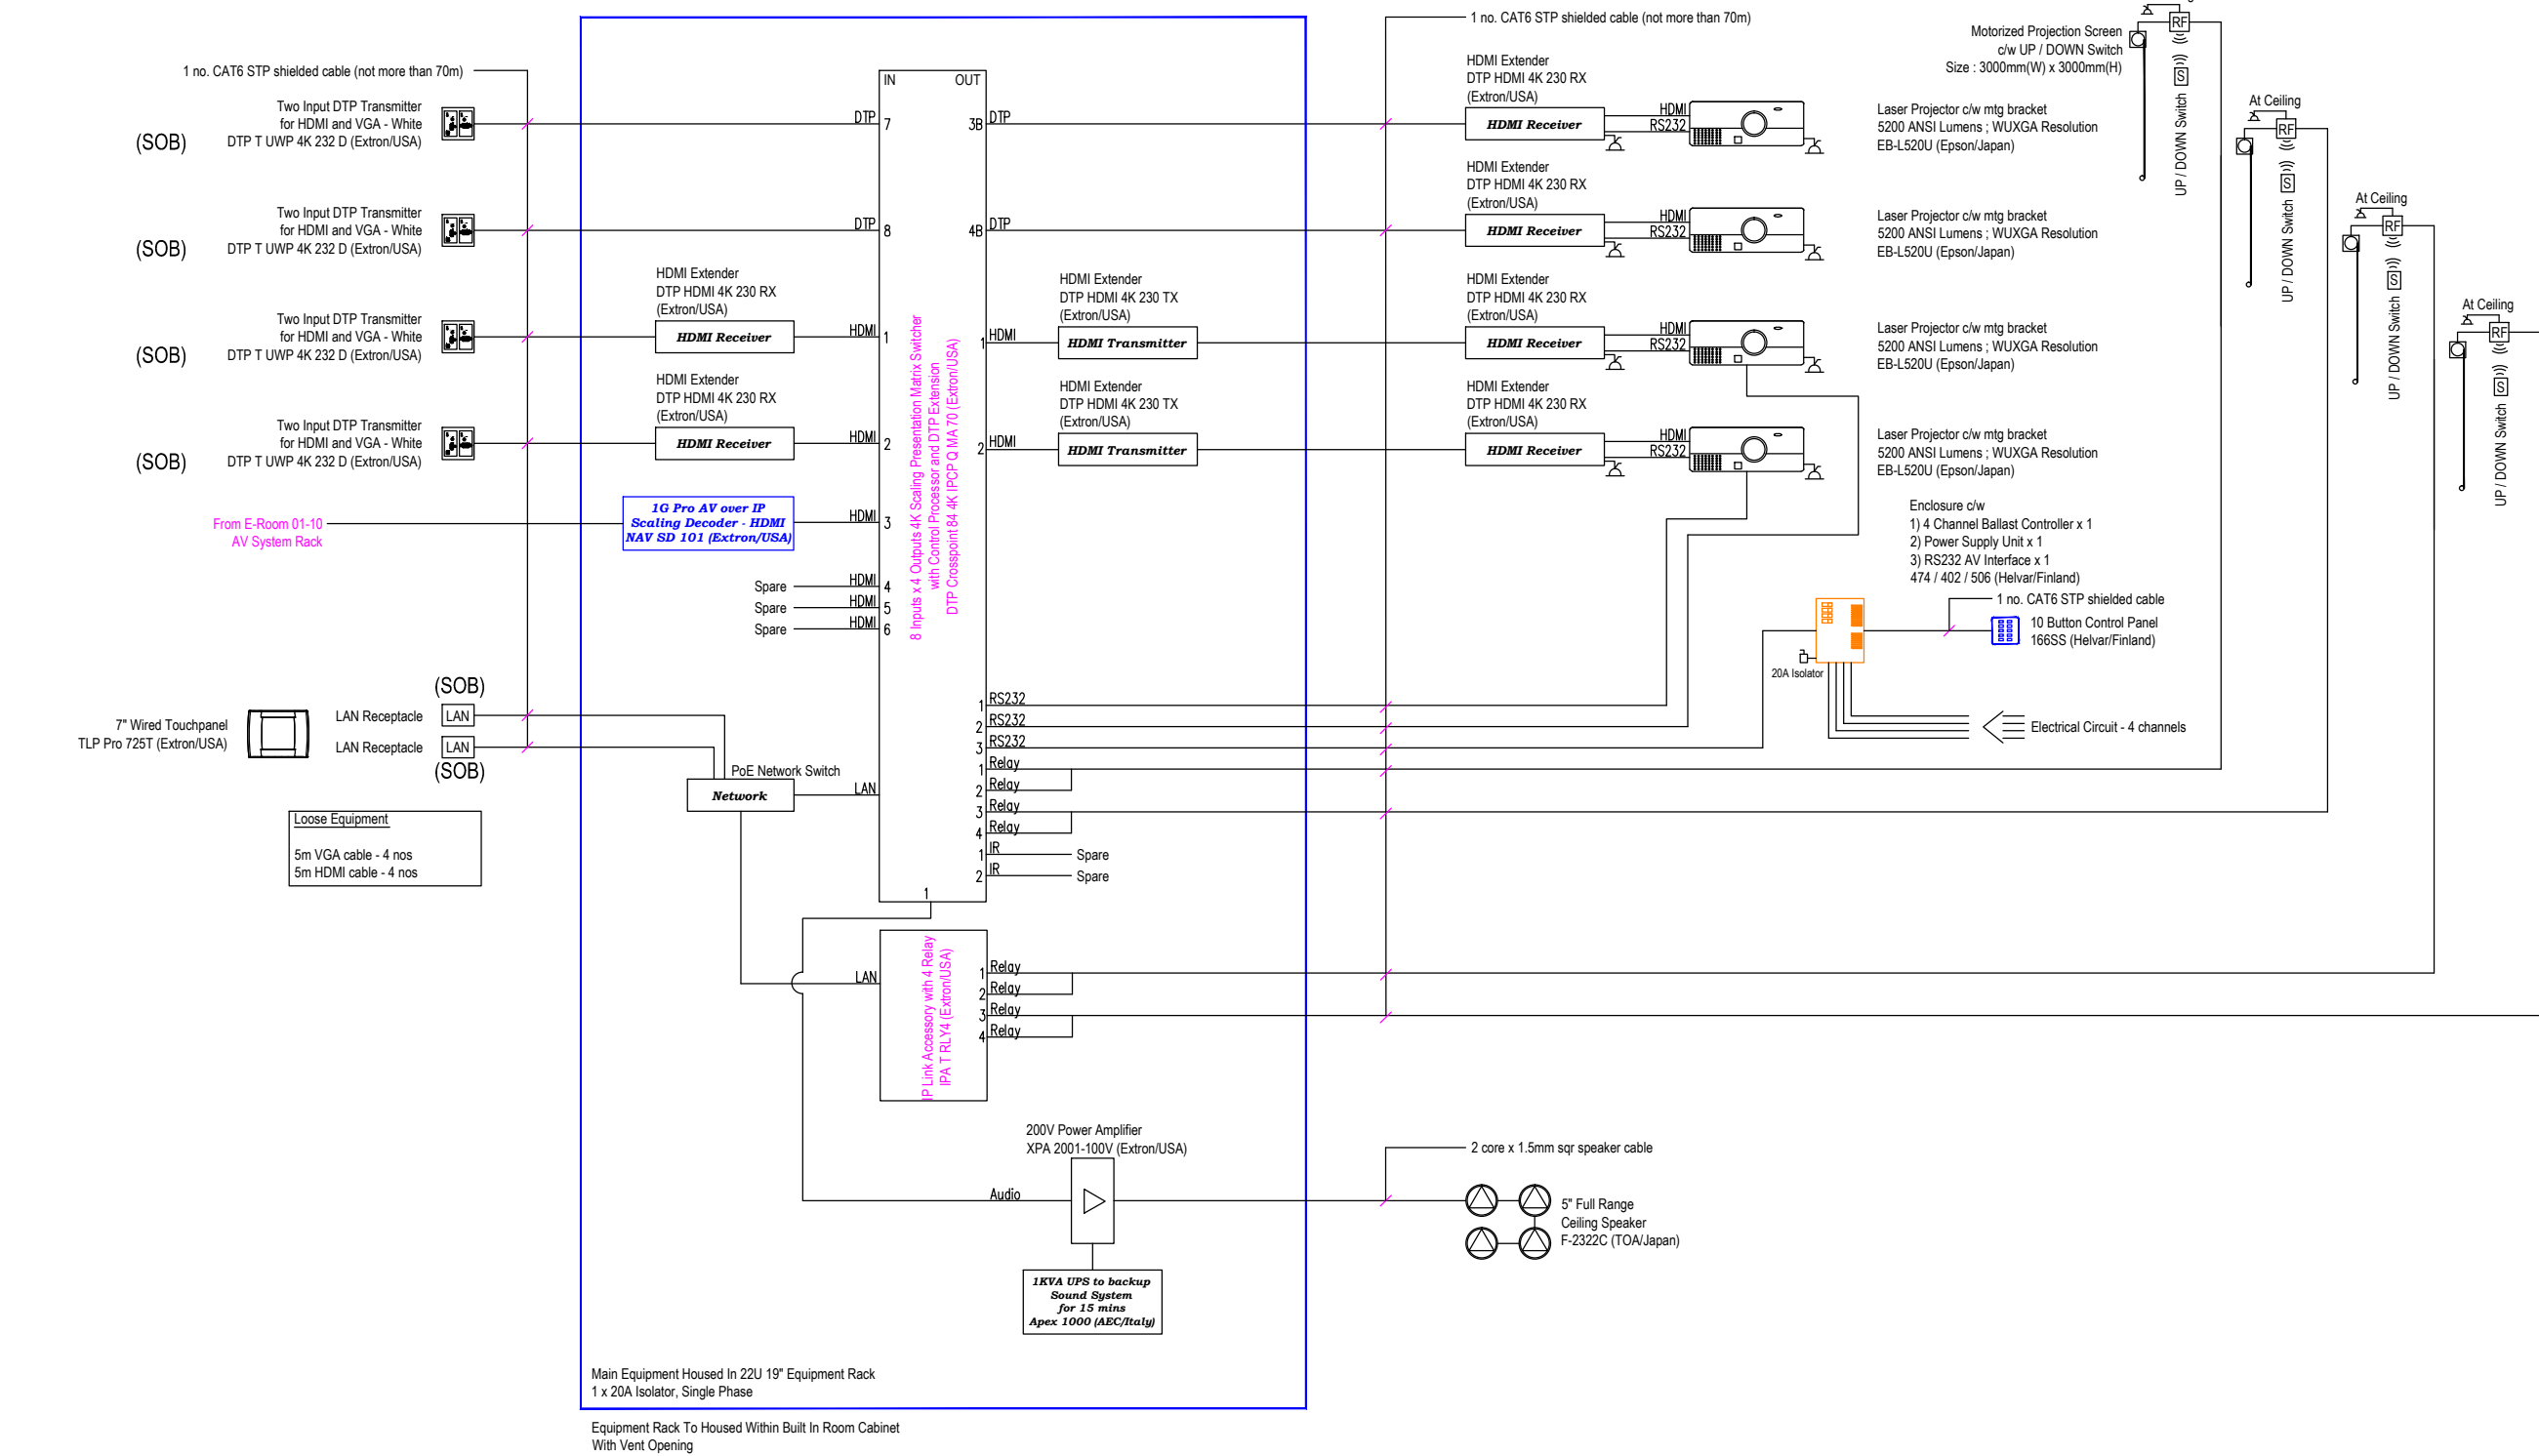

AUDIO VISUAL SYSTEM
BLK 2 - LEVEL 1 DC ROOM 01-14

2-4

2-5

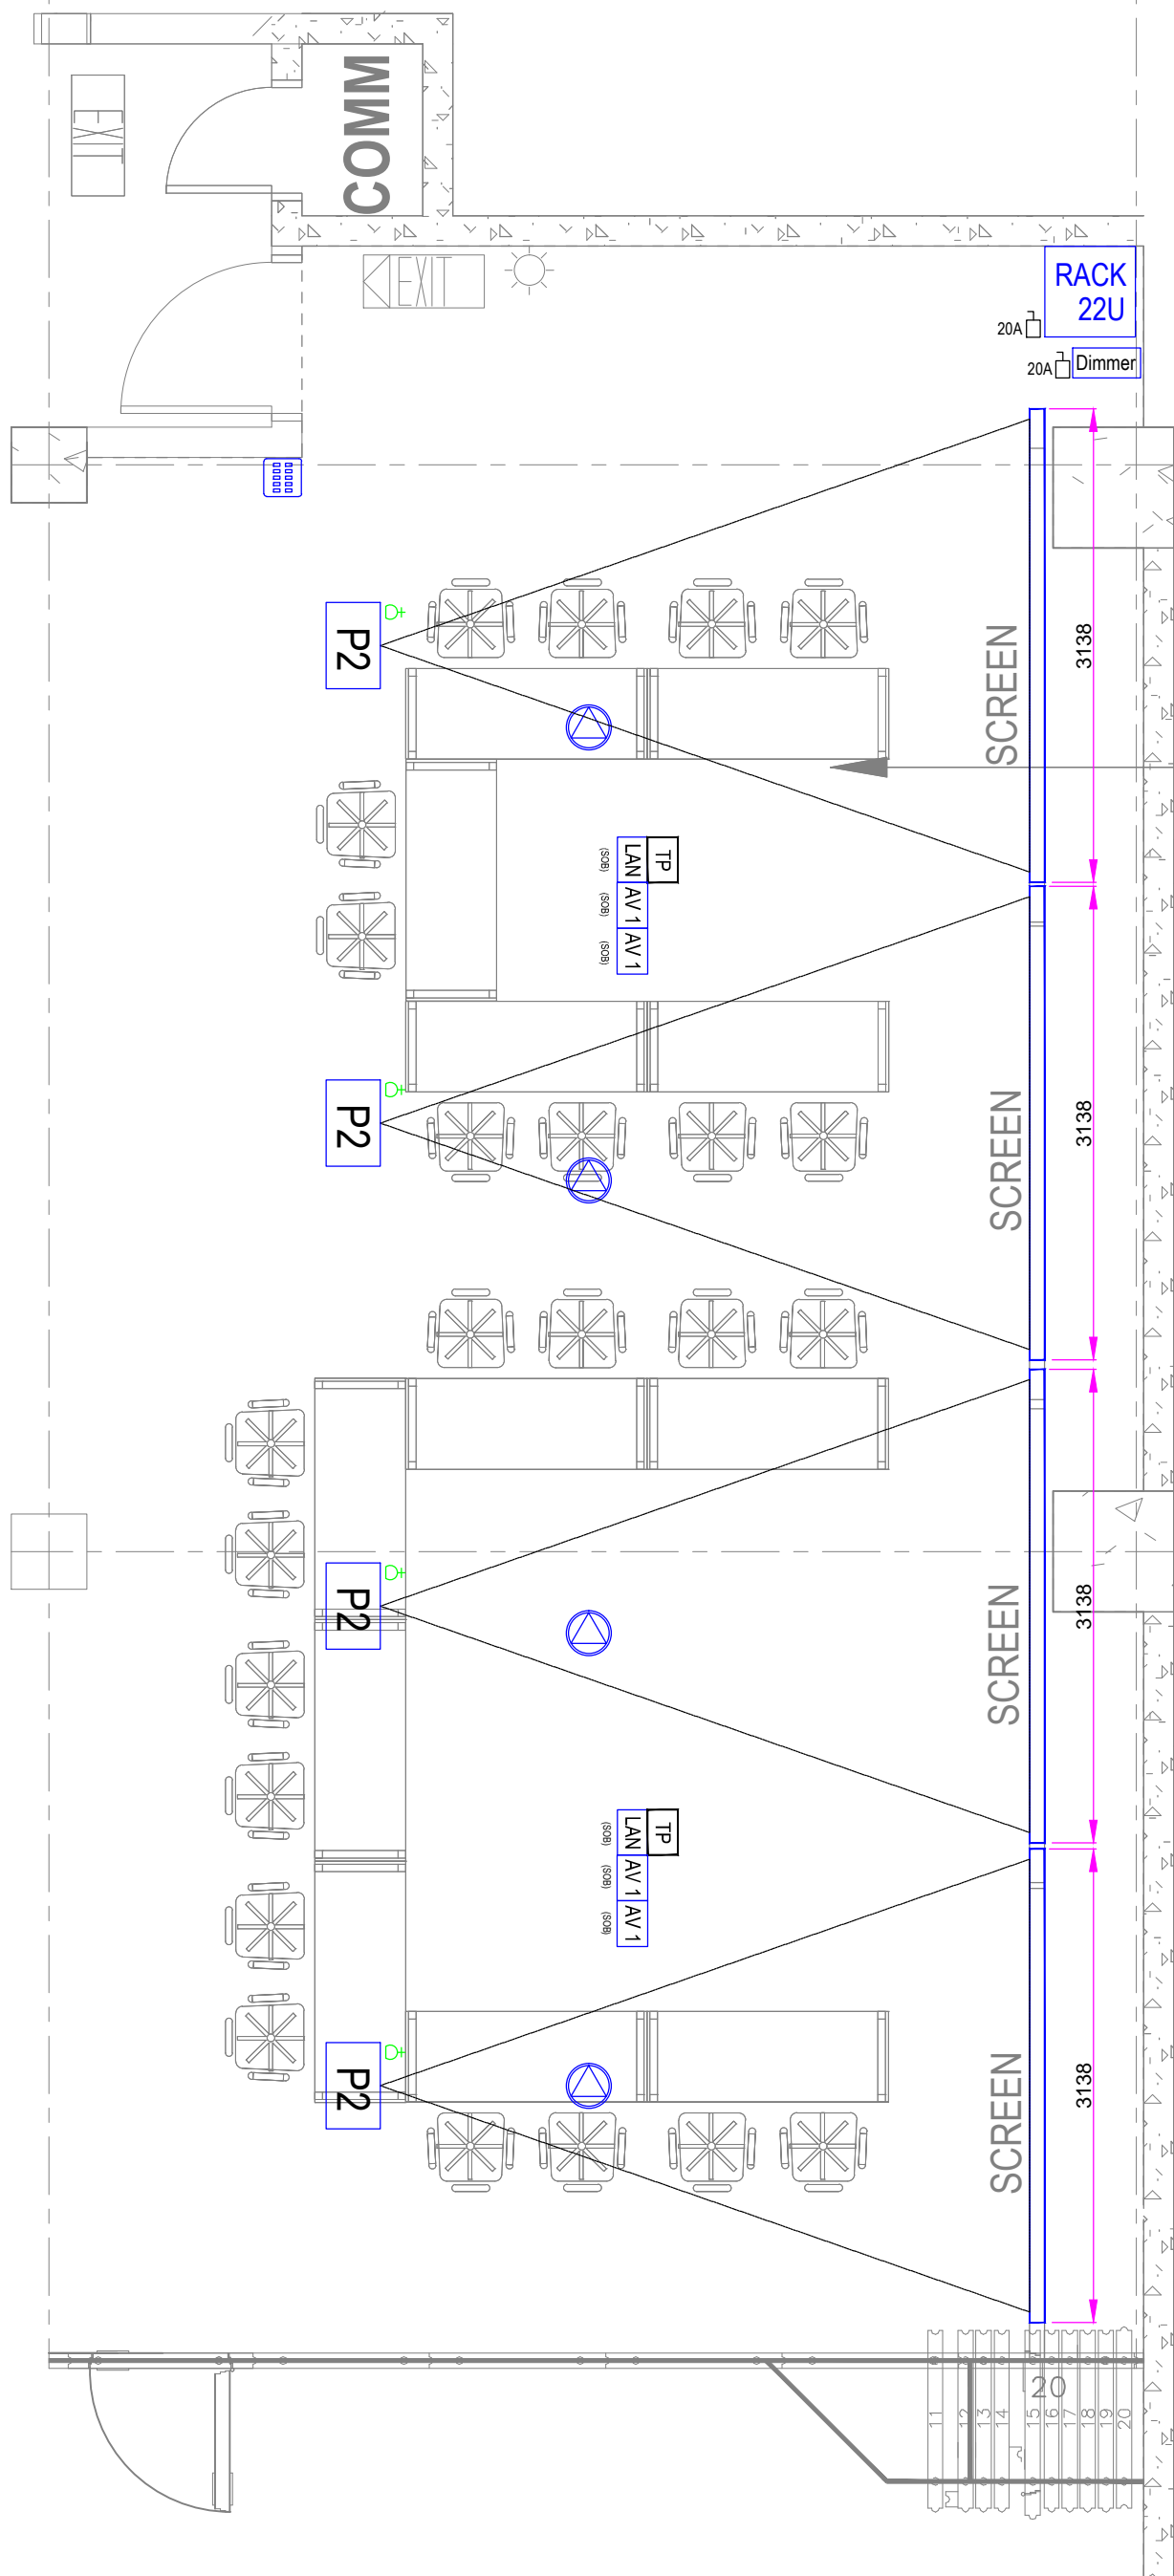

BLK 2 - LEVEL 1 DC ROOM 01-14
SCALE 1 : 40