



2ND STOREY PLAN
Scale: 1:250

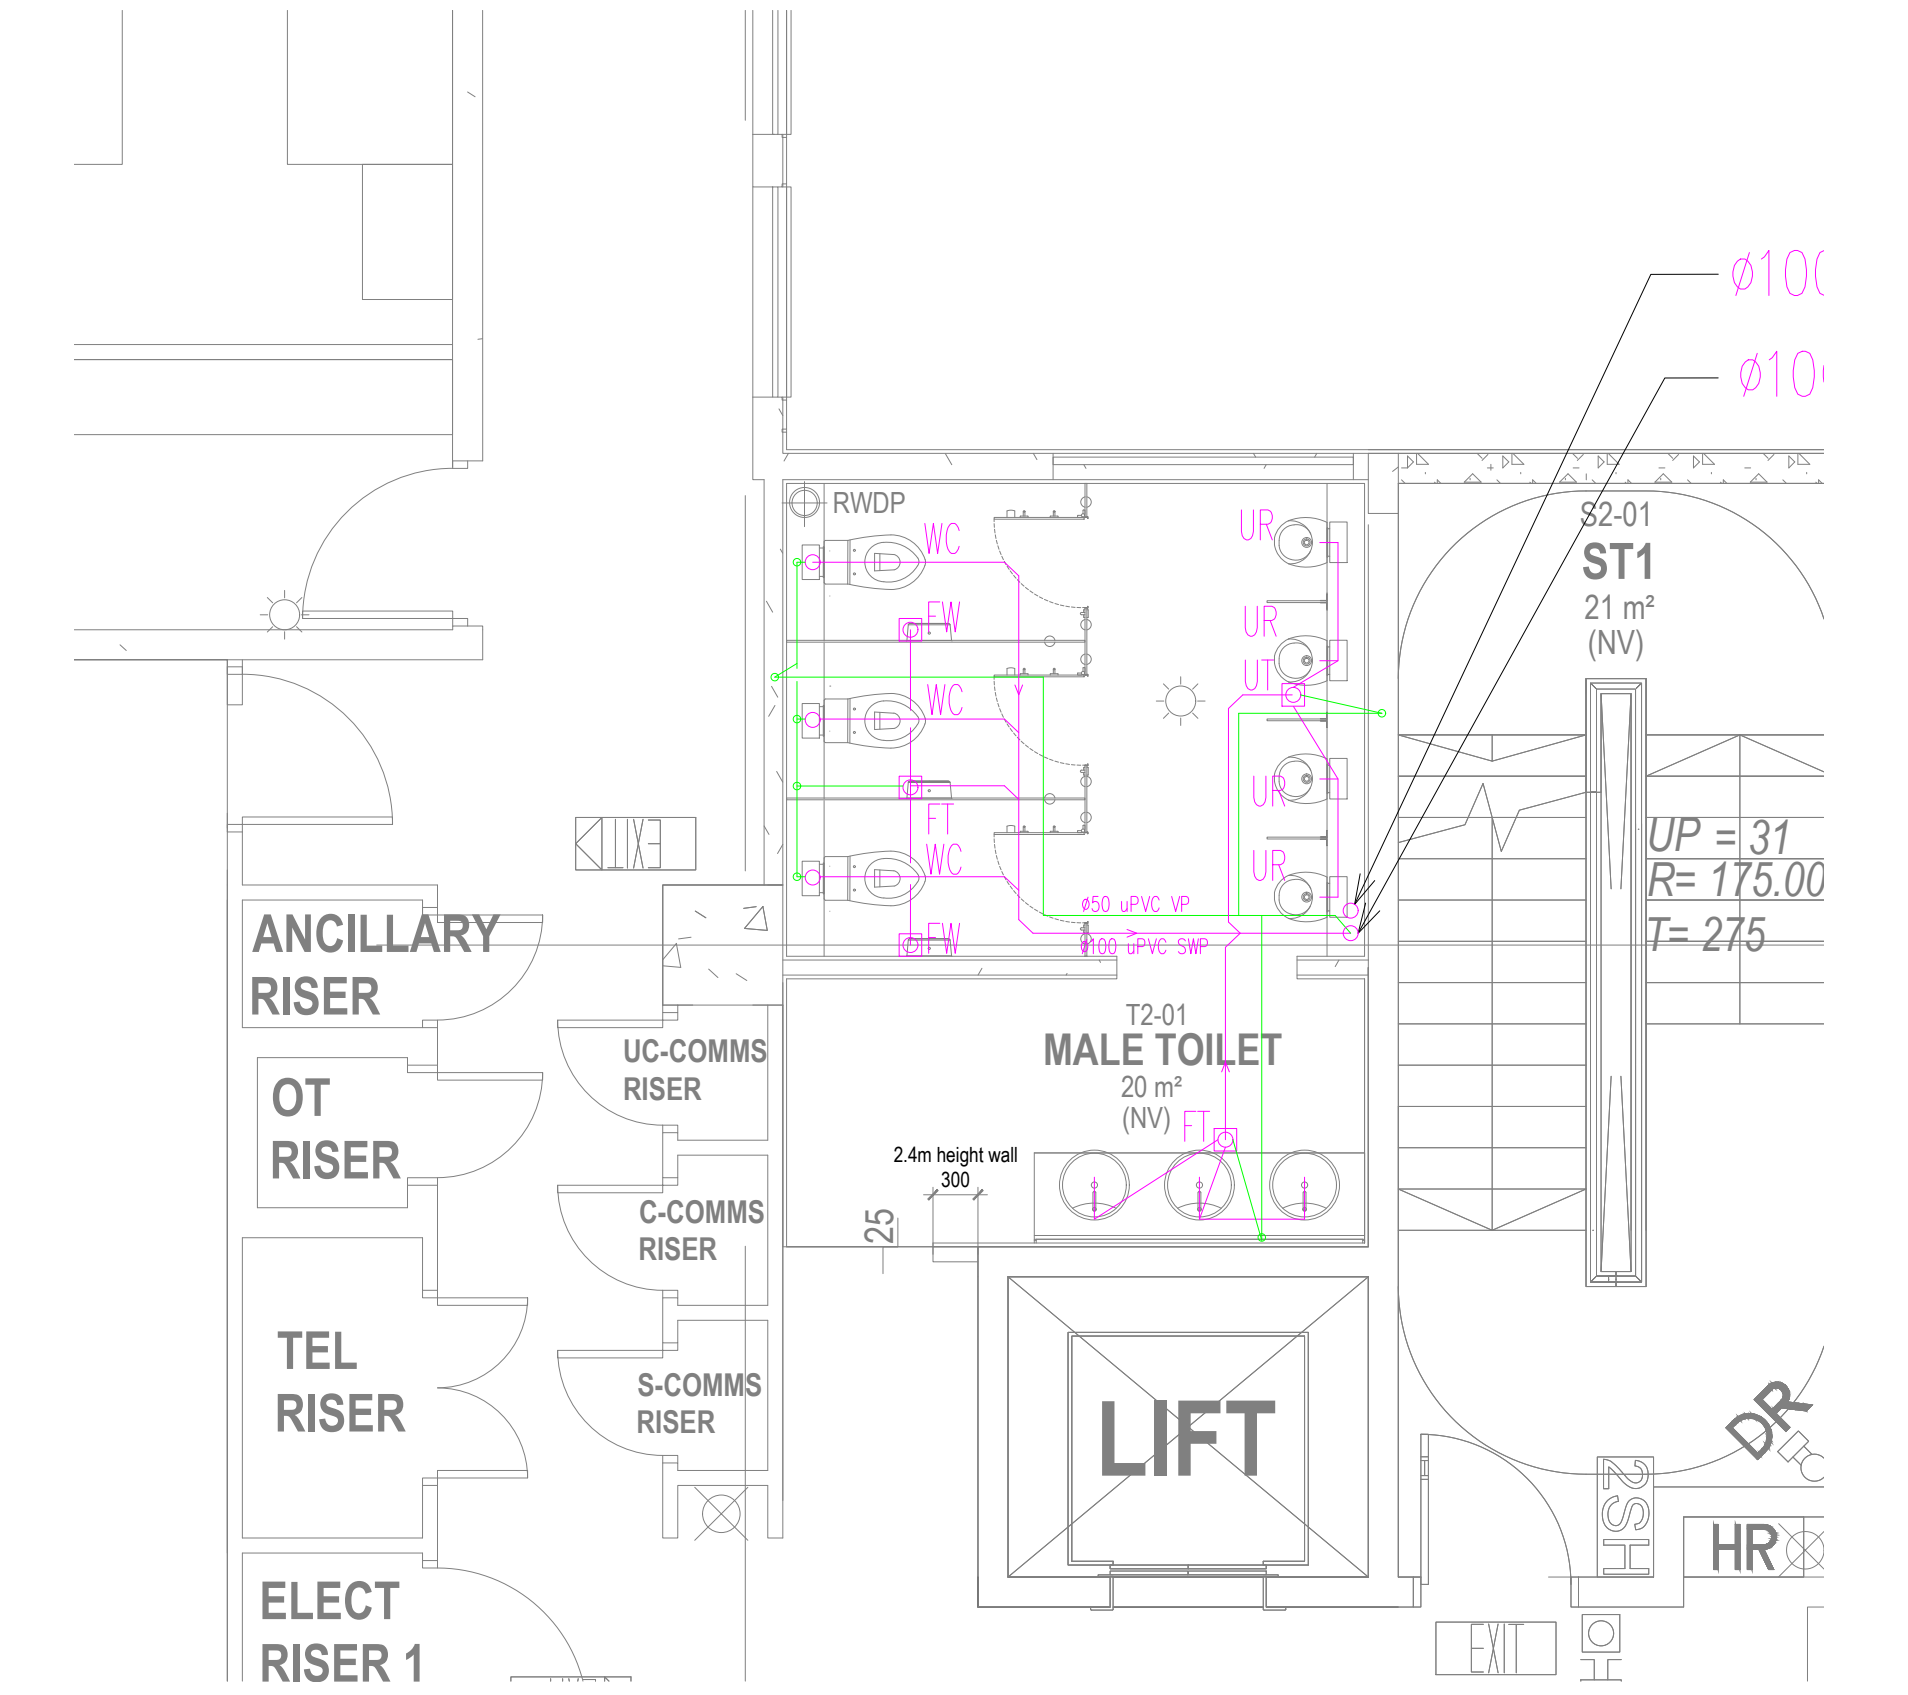

BLOW-UP PLAN 1-1
Scale: 1:50

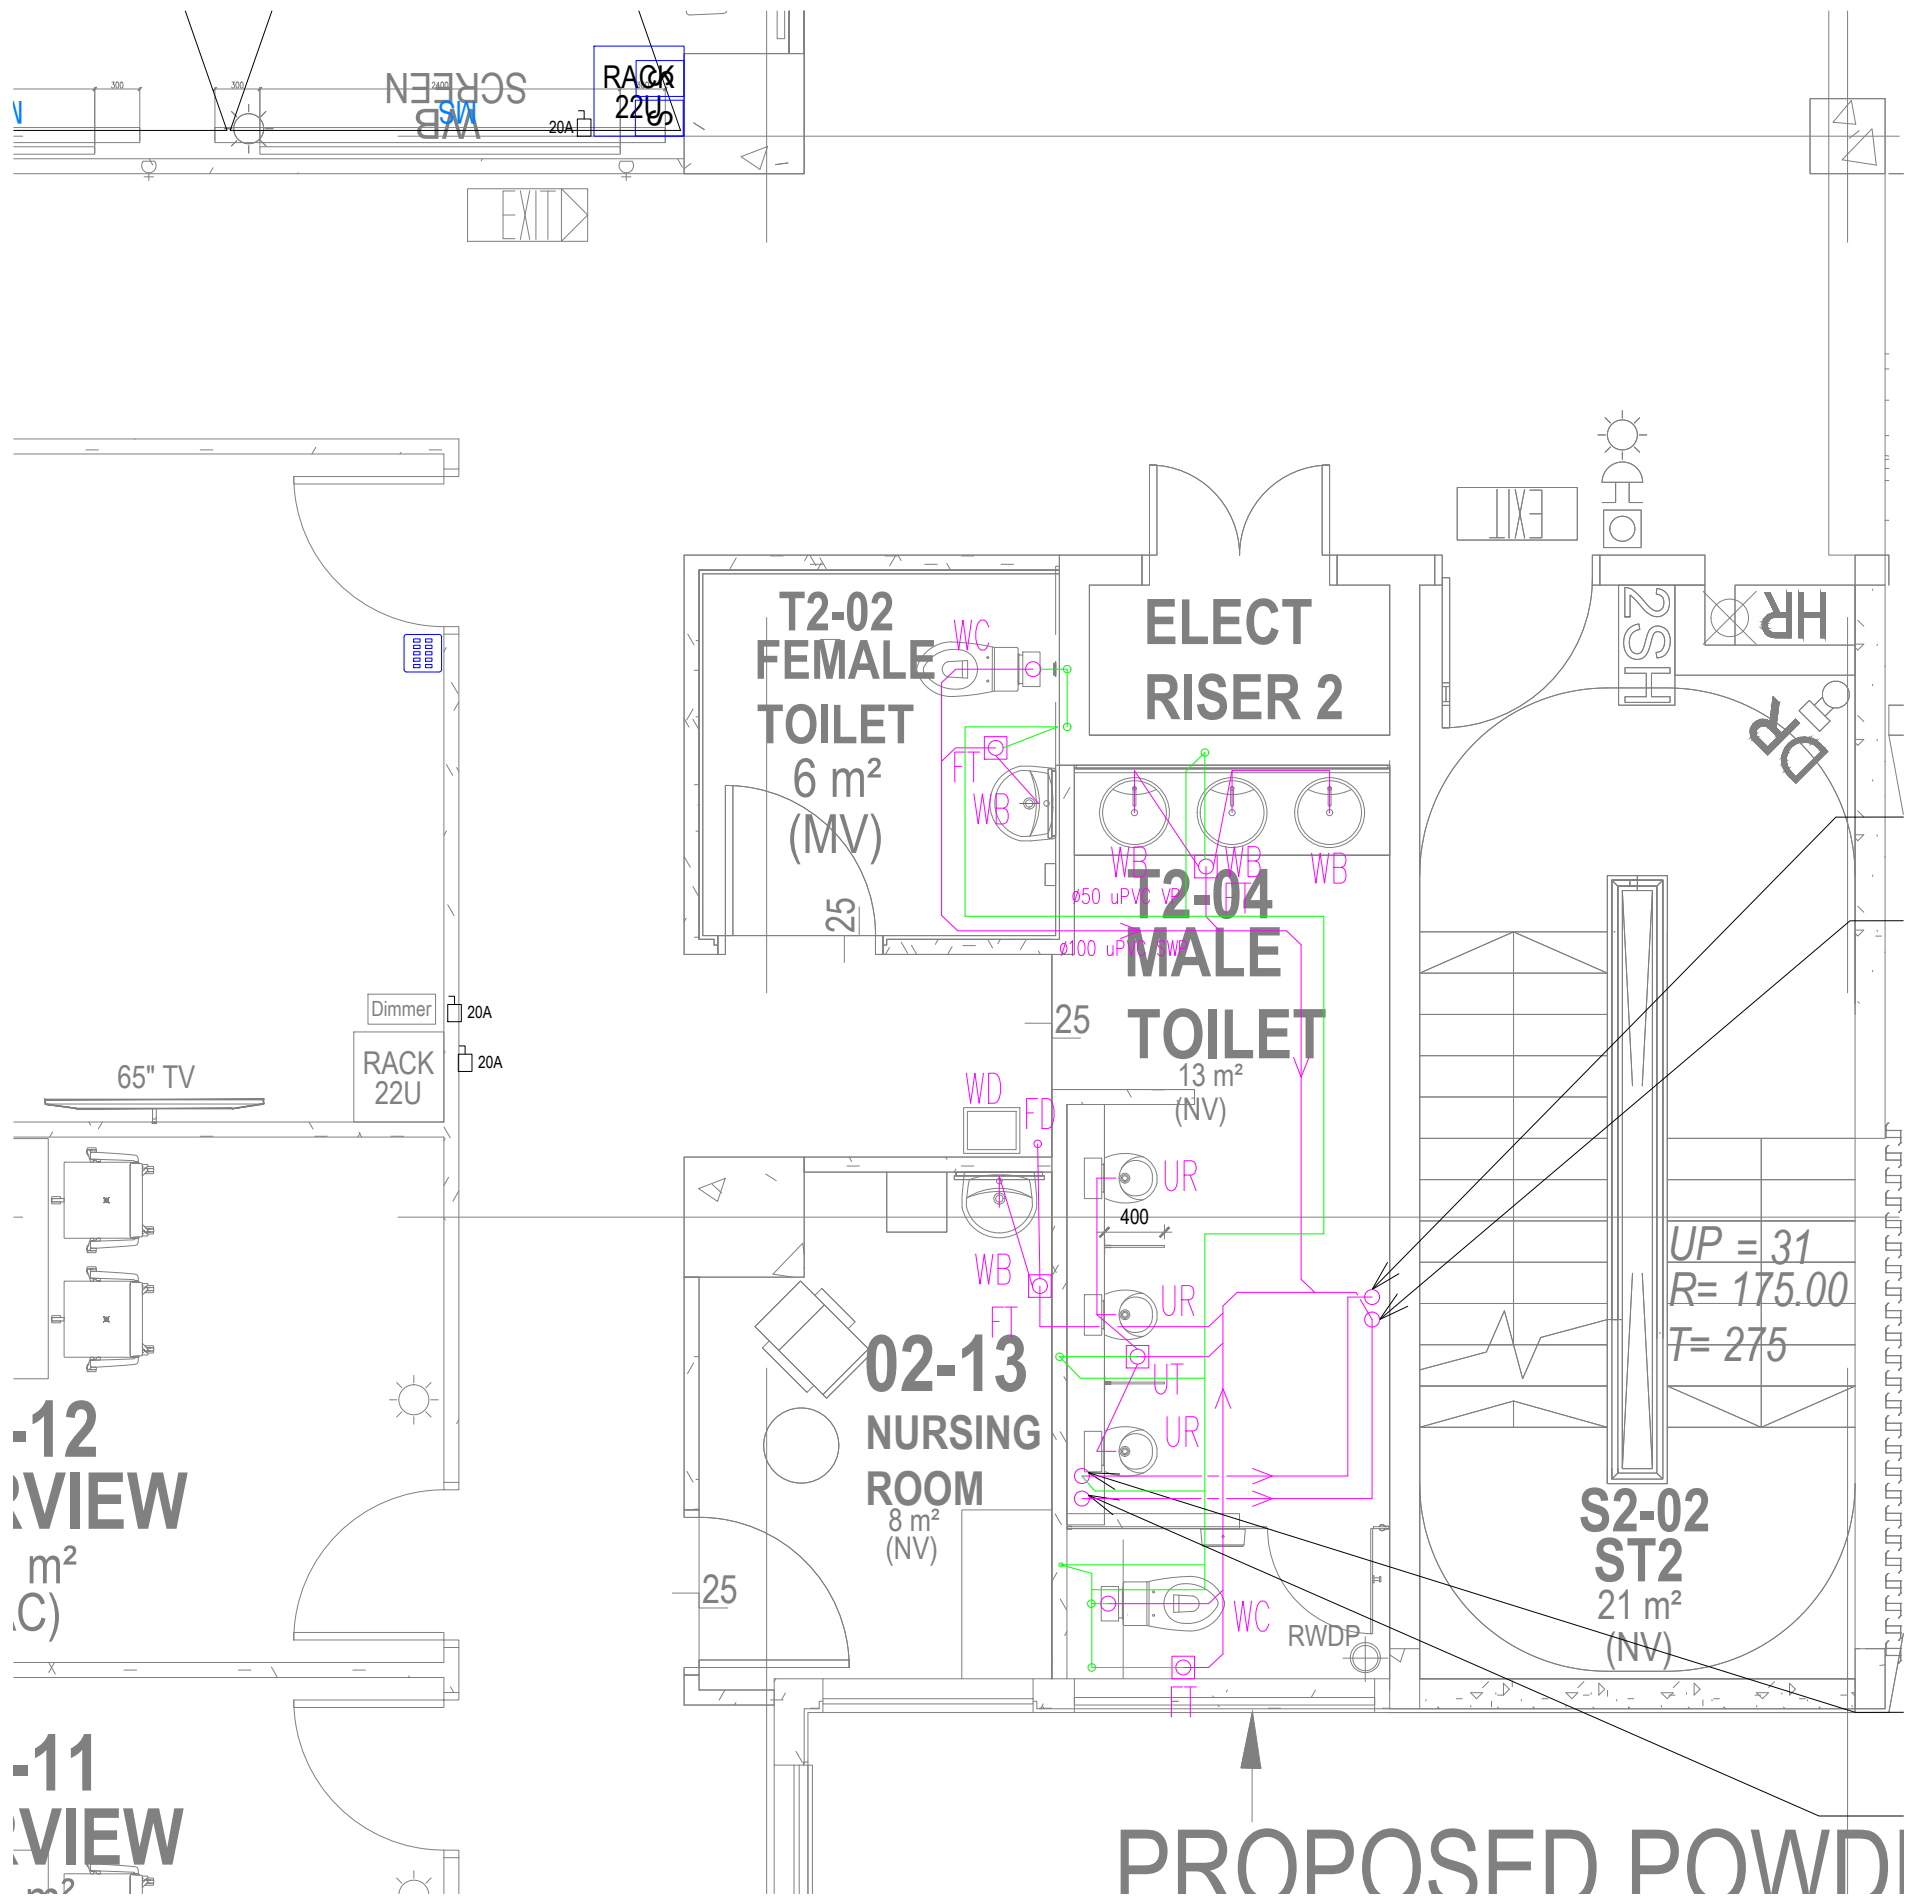

BLOW-UP PLAN 2-2
Scale: 1:50

M&E CONSULTANTS
PdcConsultants Pte Ltd
23 NEW INDUSTRIAL ROAD #06-03
POLYTRON BUSINESS CENTER, SINGAPORE 536209
TEL: 6444 7748
FAX: 6444 7741

DATE RECEIVED: _____ RECEIVED BY: _____
DATE RETURNED: _____
☐ NO EXCEPTION TAKEN ☐ MAKE CORRECTIONS NOTED PRIOR TO GENERAL USE
☐ TO REVISE & RESUBMIT ☐ REJECTED & RESUBMIT

SIGNATURE: _____

- WHERE RESUBMISSION IS REQUIRED, SUBMIT REVISED DRAWINGS FOR REVIEW PRIOR TO PROCEEDING WITH WORK
- THIS REVIEW IS FOR GENERAL ARRANGEMENT ONLY AND DOES NOT EXTEND TO DIMENSIONS OF SETTING OUT OF THE WORKS AND DOES NOT RELEASE THE CONTRACTOR OF HIS RESPONSIBILITIES TO ENSURE FULL COMPLIANCE
- THIS REVIEW DOES NOT RELEASE THE CONTRACTOR OF HIS RESPONSIBILITIES TO ENSURE WORKS IN COMPLIANCE TO CONTRACT SPECIFICATIONS, OTHER DRAWINGS AND STATUTORY REQUIREMENTS HAVING JURISDICTION OVER THE INSTALLATION.

AS-BUILT DRAWING
Project Ref. No. : A2105-00599-2022



PEH SEOH CHIN
UCHI (Army Corps)

EDMUND TED KUAN WEI
Senior Programme Manager

D&R Main Contractor:
DEENN ENGINEERING PTE LTD
29 Harrison Road, Lian Beng Building, Singapore 369648
TEL. No.6283 1468 FAX No. 6280 9360
e-mail : lianbengconstrn@pacific.net.sg
Website: www.lianbeng.com.sg

Architect:
ID ARCHITECTS PTE LTD
3 HarbourFront Place #03-01,
HarbourFront Tower Two,
Singapore 099254
Tel: 6225 6011
Fax: 6225 6022
general@idarchitects.com.sg
www.idarchitects.com.sg

Structure:
TW-Asia Consultants Pte Ltd
NO. 28 SIN MING LANE #04-137 MIDVIEW CITY
SINGAPORE 573972 TEL : 62916292 FAX : 62932196

M&E Consultant:
PdcConsultants Pte Ltd
MECHANICAL • ELECTRICAL
Paya Lebar Square
#10-17/18 (Office Lobby 1)
60 Paya Lebar Road Singapore 409051
t: 6444 7748 f: 6444 7741
e: contact@pdcengrs.com

Sub-Contractor:
WATERTech PLUMBING & CONSTRUCTION PTE LTD
30 Kallang Road #03-004-02
Empire TechnoCentre
Singapore 417819
Tel: 6444 6855 FAX: 6444 7378

Project No.:
D2019-00162

Project Title:
PROPOSED ADDITIONS OF 1 BLOCK OF 3-STORY OFFICE BUILDING BLK 2, 1 BLOCK OF 6-STORY ACCOMMODATION BUILDING BLK 3 (11), 1 BLOCK OF 4-STORY ACCOMMODATION BUILDING BLK 4 (10), 1 BLOCK OF 2-STORY TRAINING MULTIPLEX BLK 9 (6), 1 BLOCK OF MSVS BLK 10 (9), AND ANCILLARY FACILITIES BLK 5, 6(4) & 8 TO EXISTING DIEPPE BARRACK ON LOT 05019M MK13 AT SEMBAWANG ROAD (MANDAI PLANNING AREA)

Drawing title:
BLK 2 2ND STOREY SANITARY DRAWING

	initial	Date	Scale	AS SHOWN
Drawn	SAN	15.08.2024	Scale	AS SHOWN
Checked	TOMMY	15.08.2024	Software	CAD
Drawn no.:	D2019-00162/WT/LB/BLK2/502			
Revision no.:				

THIS DRAWING IS COPYRIGHT
THIS DRAWING IS THE PROPERTY OF DSTA. IF FOUND, PLEASE RETURN TO DSTA
BUILDING AND INFRASTRUCTURE PROGRAMME CENTRE, 1 DEPOT ROAD,
SINGAPORE 106679
REPRODUCTION OF DRAWING WITHOUT THE WRITTEN PERMISSION OF DSTA IS
STRICTLY PROHIBITED. ANY UNAUTHORIZED REPRODUCTION OR POSSESSION
SHALL BE DEALT WITH UNDER THE OFFICIAL SECRETS ACT.