


BLOW -UP PLAN 1-1 Scale: 1:50

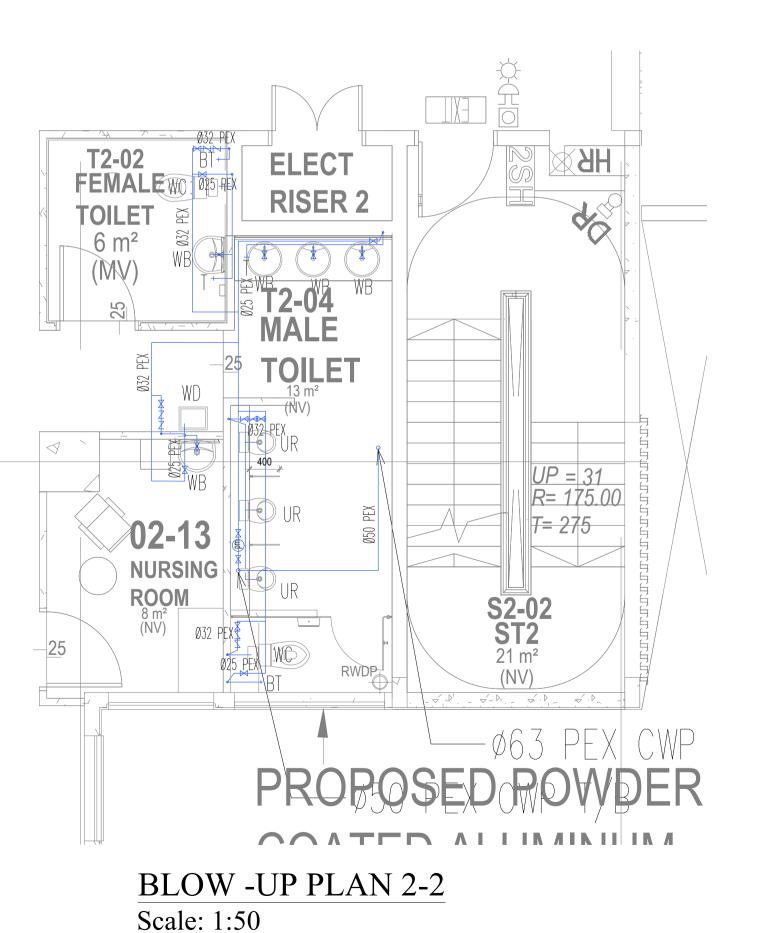

AS-BUILT DRAWING Project Ref. No.: A2105-00599-2022

PdcConsultants Pte Ltd

□ NO EXCEPTION TAKEN □ MAKE CORRECTIONS NOTED PRIOR TO GENERAL US □ TO REVISE & RESUBMIT □ REJECTED & RESUBMIT

DSTA



&B Main Contractor:

Senior Programme Manager

EDMUND TEO KUAN WEI



TEL. No.6283 1468 FAX No. 6280 9360 e-mail: lianbengconstn@pacific.net.sg Website: www.lianbeng.com.sg

Architect:

ID ARCHITECTS PTE LTD 3 HarbourFront Place, #03-01, HarbourFront Tower Two, Singapore 099254 Tel:6225 6011 Fax:6225 6022

general@idarchitects.com.sg www.idarchitects.com.sg

TW—ASIA Consultants Pte Ltd

NO. 28 SIN MING LANE #04-137 MIDVIEW CITY SINGAPORE 573972 TEL": 62916292 FAX: 62932196



Pdc Consultants Pte Ltd

Paya Lebar Square #10-17/18 (Office Lobby 1) 60 Paya Lebar Road Singapore 409051 t:6444 7748 f:6444 7141 e:contact@pdcengrs.com



WATERTECH PLUMBING & CONSTRUCTION PTE LTD 30 Kaki Bukit Rd 3 #04-02 Empire TechnoCentre Singapore 417819 Tel:6444 6855 FAX : 6444 7378

D2019-00162

roject Title:

PROPOSED ADDITIONS OF 1 BLOCK OF 3-STOREY OFFICE BUILDING BLK 2, 1 BLOCK OF 6-STOREY ACCOMMODATION BUILDING BLK 3 (11), 1 BLOCK OF 4-STOREY ACCOMMODATION BUILDING BLK 4 (10), 1 BLOCK OF 2-STOREY TRAINING MULTIPLEX BLK 9 (6), 1 BLOCK OF MSVS BLK 10 (9), AND ANCILLARY FACILITIES BLK 5, 6(4) & 8 TO EXISTING DIEPPE BARRACK ON LOT 05019M MK13 AT SEMBAWANG ROAD (MANDAI PLANNING AREA)

BLK 2 2ND STOREY PLUMBING DRAWING

Drawn SAN 15.08.2024 Scale AS SHOWN Checked TOMMY 15.08.2024 Software CAD Drawing no: Revision no:		Initial	Date		
Oncored Towns 1 Corregio	Drawn	SAN	15.08.2024	Scale	AS SHOWN
Drawing no : Revision no :	Checked	TOMMY	15.08.2024	Software	C AD
Drawing hou	Drawing no.:				Revision no.:

BUILDING AND INFRASTRUCTURE PROGRAMME CENTRE, 1 DEPOT ROAD,

D2019-00162/WT/LB/BLK2/P02

THIS DRAWING IS COPYRIGHT THIS DRAWING IS THE PROPERTY OF DSTA. IF FOUND, PLEASE RETURN TO DSTA

SINGAPORE 109679. REPRODUCTION OF DRAWING WITHOUT THE WRITTEN PERMISSION OF DSTA BI IS STRICTLY PROHIBITED. ANY UNAUTHORIZED REPRODUCTION OR POSSESSION SHALL BE DEALT WITH UNDER THE OFFICIAL SECRETS ACT.

2ND STOREY PLAN

Scale: 1:250