PdcConsultants Pte Ltd □ NO EXCEPTION TAKEN □ MAKE CORRECTIONS NOTED PRIOR TO GENERAL USE □ TO REVISE & RESUBMIT □ REJECTED & RESUBMIT

Project Ref. No.: A2105-00599-2022

AS-BUILT DRAWING





EDMUND TEO KUAN WEI Senior Programme Manager



TEL. No.6283 1468 FAX No. 6280 9360 e-mail : lianbengconstn@pacific.net.sg Website: www.lianbeng.com.sg

Architect:

&B Main Contractor:

ID ARCHITECTS PTE LTD 3 HarbourFront Place, #03-01, HarbourFront Tower Two, Singapore 099254 Tel:6225 6011 Fax:6225 6022

general@idarchitects.com.sg www.idarchitects.com.sg

TW-ASIA Consultants Pte Ltd NO. 28 SIN MING LANE #04-137 MIDVIEW CITY SINGAPORE 573972 TEL": 62916292 FAX: 62932196



Pdc Consultants Pte Ltd Paya Lebar Square #10-17/18 (Office Lobby 1)

60 Paya Lebar Road Singapore 409051 t:6444 7748 f:6444 7141 e:contact@pdcengrs.com



WATERTECH PLUMBING & CONSTRUCTION PTE LTD 30 Kaki Bukit Rd 3 #04-02 Singapore 417819
Tel:6444 6855 FAX : 6444 7378

D2019-00162

Project Title:


PROPOSED ADDITIONS OF 1 BLOCK OF 3-STOREY OFFICE BUILDING BLK 2, 1 BLOCK OF 6-STOREY ACCOMMODATION BUILDING BLK 3 (11), 1 BLOCK OF 4-STOREY ACCOMMODATION BUILDING BLK 4 (10), 1 BLOCK OF 2-STOREY TRAINING MULTIPLEX BLK 9 (6), 1 BLOCK OF MSVS BLK 10 (9), AND ANCILLARY FACILITIES BLK 5, 6(4) & 8 TO EXISTING DIEPPE BARRACK ON LOT 05019M MK13 AT SEMBAWANG ROAD (MANDAI PLANNING AREA)

BLK 2 PLUMBING SCHEMATIC DRAWING

	Initial	Date		
Drawn	SAN	15.08.2024	Scale	AS SHOWN
Checked	TOMMY	15.08.2024	Software	C AD
Drawing no.:				Revision no.:
D2019-00162/WT/LB/BLK2/P05				

THIS DRAWING IS COPYRIGHT THIS DRAWING IS THE PROPERTY OF DSTA. IF FOUND, PLEASE RETURN TO DSTA BUILDING AND INFRASTRUCTURE PROGRAMME CENTRE, 1 DEPOT ROAD, SINGAPORE 109679.

REPRODUCTION OF DRAWING WITHOUT THE WRITTEN PERMISSION OF DSTA BI IS STRICTLY PROHIBITED. ANY UNAUTHORIZED REPRODUCTION OR POSSESSION SHALL BE DEALT WITH UNDER THE OFFICIAL SECRETS ACT.

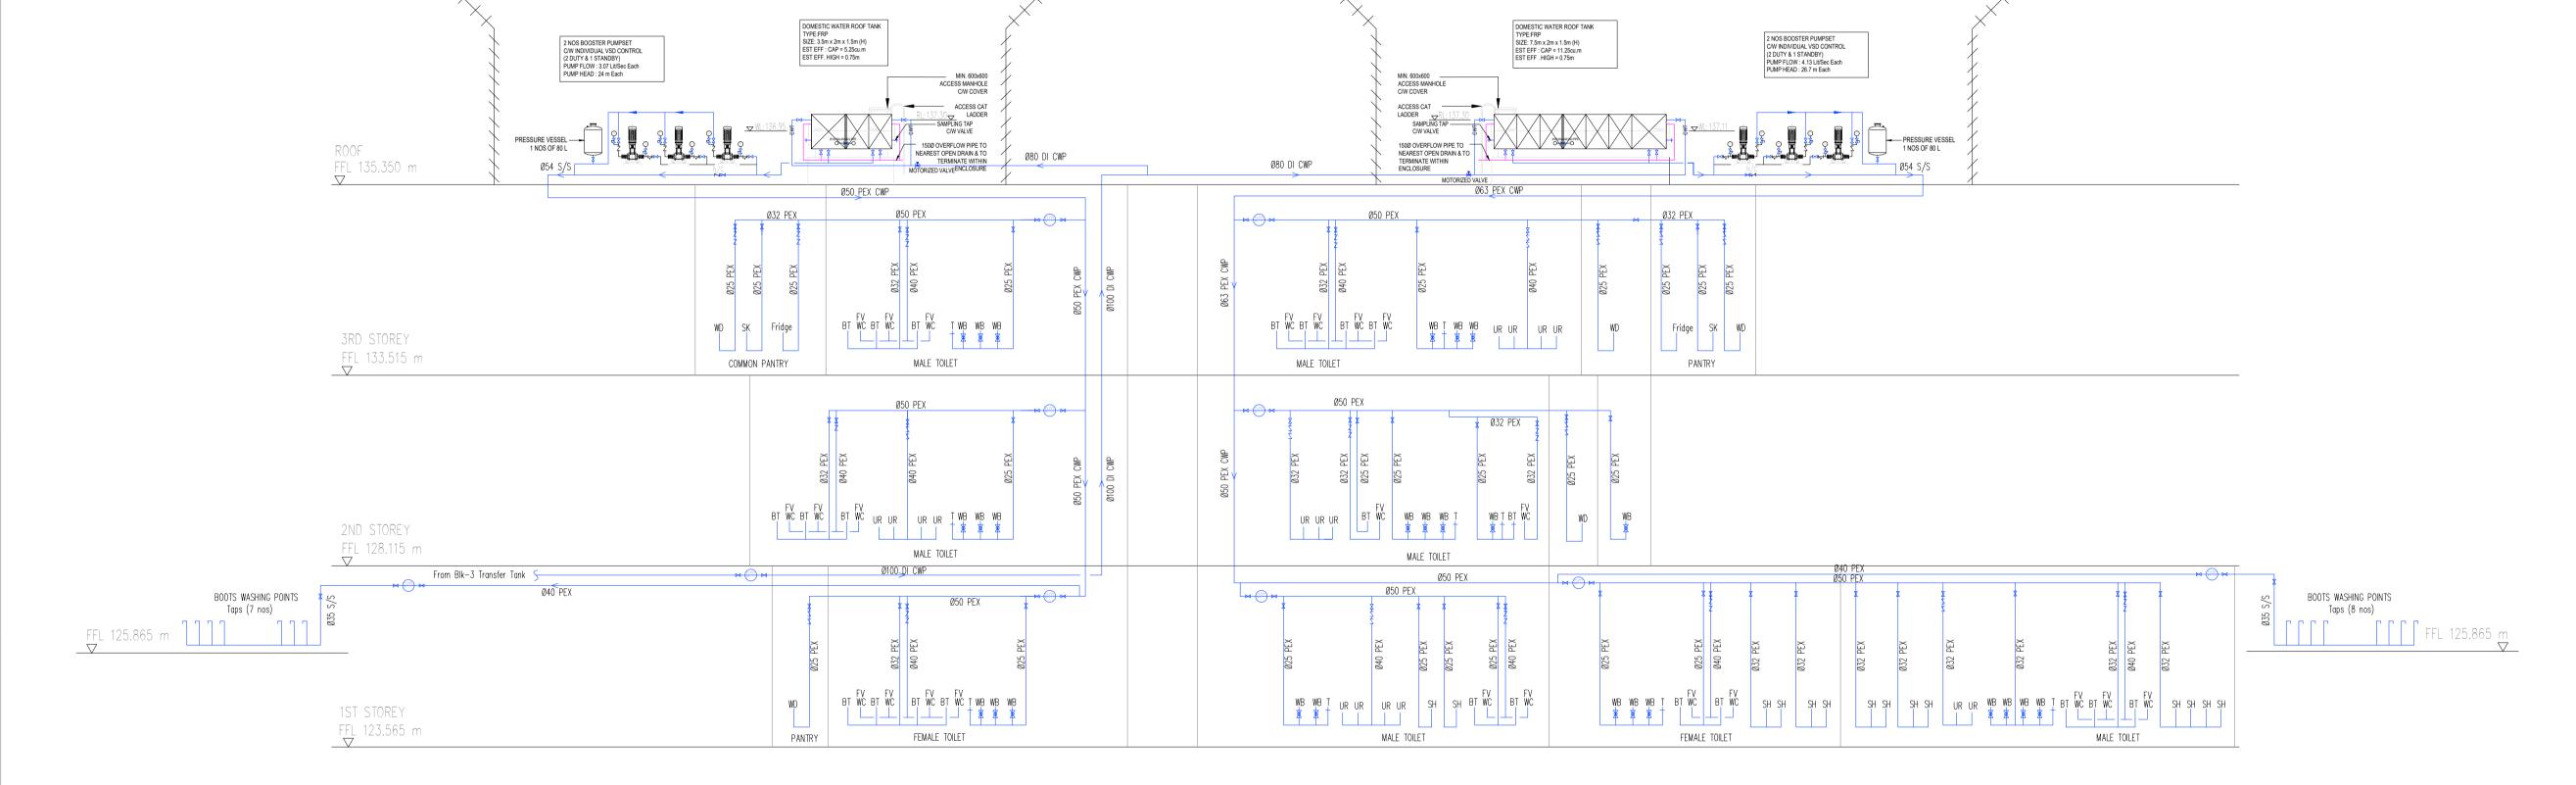

-ENCLOSURE C/W OUTRIGGER ALL ROUND PUMP & TANK-

PLUMBING SCHEMATIC DRAWING Scale-NTS

