

AS BUILT DRAWING

DEVELOPER:



VYNNA PEH
SEOH CHIN

HCD (Army Camps)

Edmund Teo
Kuan Wei

Senior Programme Manager

D&B MAIN CONTRACTOR:

DEENN ENGINEERING PTE LTD
29 Harrison Road, Lian Beng Building, Singapore 369648
TEL: No.6283 1468 FAX No. 6280 9360
e-mail : lianbengconstn@pacific.net.sg
Website: www.lianbeng.com.sg

ARCHITECT CONSULTANT:

ID ARCHITECTS PTE LTD
3 Harbourfront Place, #03-01
Harbourfront Tower Two
Singapore 099254
Tel: 6225 4011 Fax: 6225 4022
Email: general@idarchitects.com.sg
www.idarchitects.com.sg

STRUCTURE CONSULTANT:

TW-ASIA Consultants Pte Ltd

NO. 25, SIN MING LANE #04-137 MINDEN CITY
SINGAPORE 573972 TEL : 62916292 FAX : 629332 96

M&E Consultant:

PdcConsultants Pte Ltd
MECHANICAL + ELECTRICAL
23 New Industrial Road #06-03
Solstice Business Center
Singapore 536209
t : 6444 7748 f: 6444 7141
e: contact@pdcengrs.com

Sub Contractor:

CHIN SENG ENGINEERING (S) PTE LTD
33 Ubi Avenue 3, Vertex Tower B, #08-27, Singapore 408868
TEL: 6742 9392 FAX: 6742 9390

Project Title:


PROPOSED ADDITIONS OF 1 BLOCK OF 3-STOREY OFFICE
BUILDING BLK 2, 1 BLOCK OF 6-STOREY ACCOMMODATION
BUILDING BLK 3 (11), 1 BLOCK OF 4-STOREY ACCOMMODATION
BUILDING BLK 4 (10), 1 BLOCK OF 2-STOREY TRAINING MULTIPLEX
BLK 9 (6), 1 BLOCK OF MSVS BLK 10 (9), AND ANCILLARY
FACILITIES BLK 5, 6(4) & 8 TO EXISTING DIEPPE BARRACK ON LOT
05019M MK13 AT SEMBAWANG ROAD (MANDAI PLANNING AREA)

Drawing Title:

**BLOCK 2 - 3RD STOREY
LIGHTNING PROTECTION LAYOUT**

	Initial	Date	Job ref no.
Designed	JEFFREY	19/09/2024	
Checked	JEFFREY	19/09/2024	
Drawn	KHANG	19/09/2024	Filename
Software	CAD		
Scale	1:200	Sources	
Drawn no.	D2019-00162/ELECT/BLK2/LPS/03		

THIS DRAWING IS COPYRIGHT
THIS DRAWING IS THE PROPERTY OF DSTA. IF FOUND, PLEASE RETURN TO
DSTA BUILDING AND INFRASTRUCTURE PROGRAMME CENTRE,
1 DEPOT ROAD, SINGAPORE 106873.
REPRODUCTION OF DRAWING WITHOUT THE WRITTEN PERMISSION OF DSTA IS
STRICTLY PROHIBITED. ANY UNAUTHORIZED REPRODUCTION OR POSSESSION
SHALL BE DEALT WITH UNDER THE OFFICIAL SECRETS ACT.

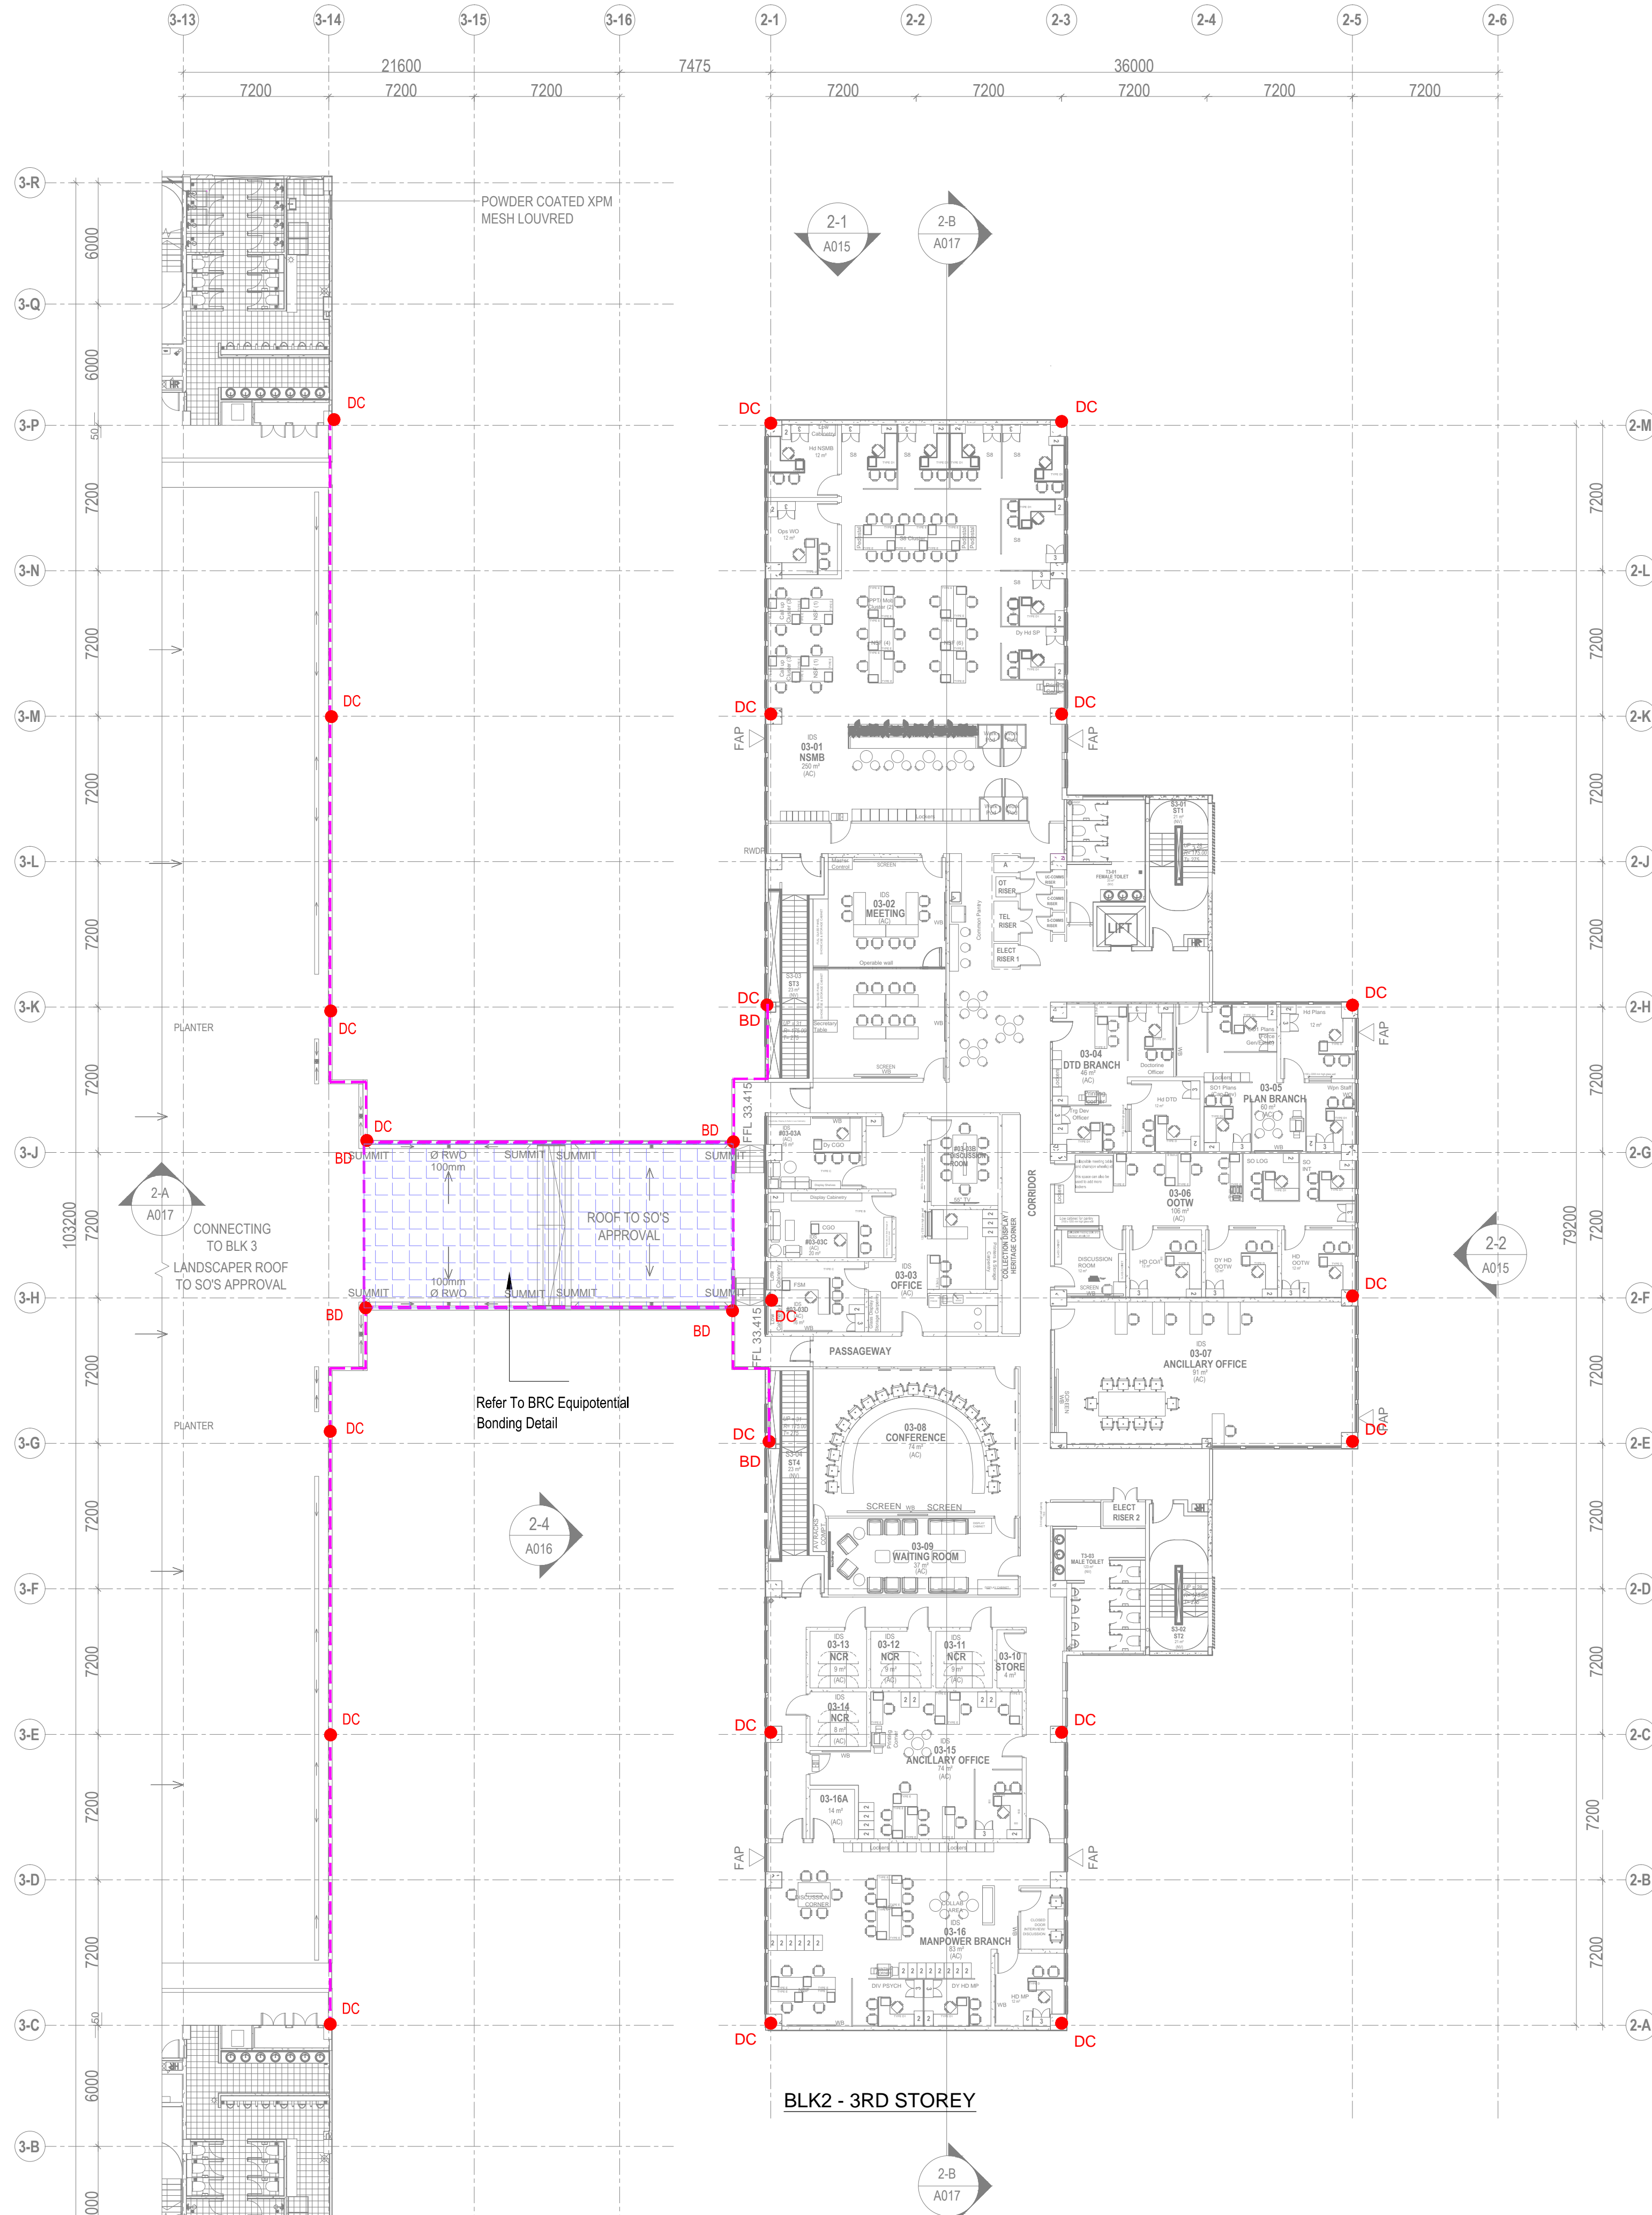

Legend	Description
●	Earth Pit (Pilecap) C/W Test Link Box
● DC	Down Conductor (T13 Dedicated Rebar)
● BD	BONDED
★	2.5m Air Terminal
★	300 mm Air Terminal
—	25mm x 3mm Aluminium Tape
---	T13 Dedicated Rebar

