



OFFICIAL (CLOSED)

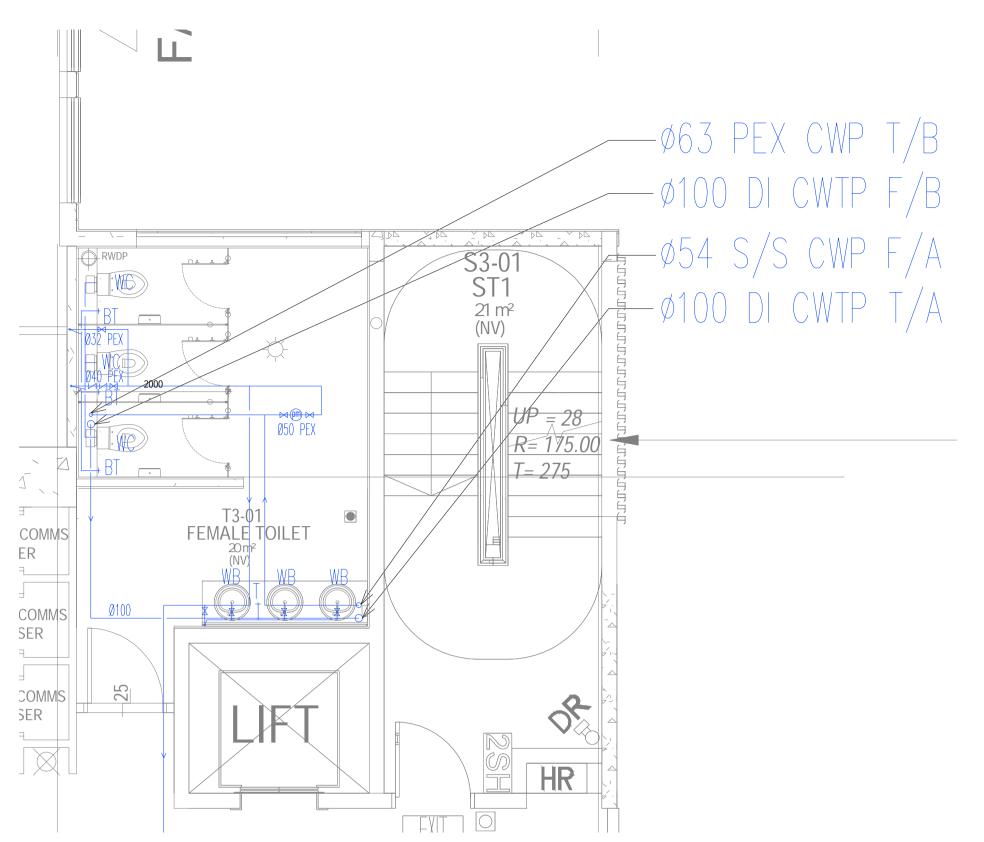

BLOW -UP PLAN 1-1

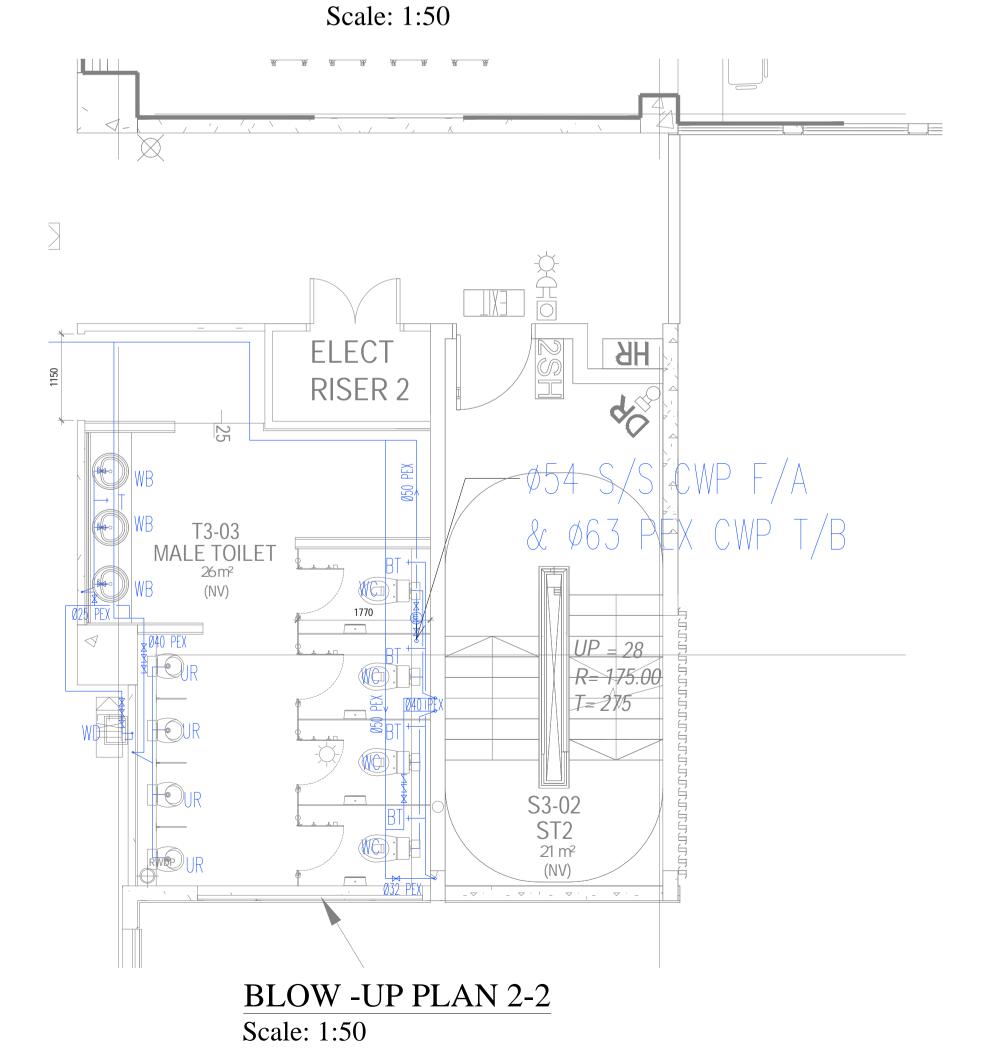

M&E CONSULTANTS

Pdc Consultants Pte Ltd

23 NEW INDUSTRIAL ROAD #06-03 TEL: 6444 77
SOLSTICE BUSINESS CENTER SINGAPORE 536209 FAX: 6444 71

DATE RECEIVED:

DATE RETURNED:

□ NO EXCEPTION TAKEN □ MAKE CORRECTIONS NOTED PRIOR TO GENERAL USE
□ TO REVISE & RESUBMIT □ REJECTED & RESUBMIT

SIGNATURE:

WHERE RESUBMISSION IS REQUIRED, SUBMIT REVISED DRAWINGS FOR REVIEW PRIOR TO PROCEEDING WITH WORK
 THIS REVIEW IS FOR GENERAL ARRANGEMENT ONLY AND DOES NOT EXTEND TO DIMENSIONS OF SETTING OUT OF THE WORKS AND DOES NOT RELEASE THE CONTRACTOR OF HIS RESPONSIBILITIES TO ENSURE FULL COMPLIANCE
 THIS REVIEW DOES NOT RELEASE THE CONTRACTOR OF HIS RESPONSIBILITIES TO ENSURE WORKS IN COMPLIANCE TO CONTRACT SPECIFICATION, OTHER DRAWINGS AND STATUTORY REQUIREMENT HAVING JURISDICTION OVER THE INSTALLATION.

'AS-BUILT'

Project Ref. No. : A2105-00599-2022





PEH SEOH CHIN HCD (Army Camps)

D&B Main Contractor:

e-mail: lianbengconstn@pacific.net.sg Website: www.lianbeng.com.sg

DEENN ENGINEERING PTE LTD

29 Harrison Road, Lian Beng Building , Singapore 369648

TEL. No.6283 1468 FAX No. 6280 9360

Architect:

general@idarchitects.com.sg www.idarchitects.com.sg

ID ARCHITECTS PTE LTD

3 HarbourFront Place, #03-01,
HarbourFront Tower Two,
Singapore 099254
Tel:6225 6011
Fax:6225 6022



EDMUND TEO KUAN WEI

Senior Programme Manager

Structure:

TW- ASIA Consultants Pte Ltd

NO. 28 SIN MING LANE #04-137 MIDVIEW CITY

SINGAPORE 573972 TEL : 62916292 FAX : 62932196

1&E Consultant:



Pdc Consultants Pte Ltd

MECHANICAL + ELECTRICAL

Paya Lebar Square

#10-17/18 (Office Lobby 1)

60 Paya Lebar Road Singapore 409051 t:6444 7748 f:6444 7141 e:contact@pdcengrs.com

Sub Contractor:

WATERTECH PLUMBING & CONSTRUCTION PTE LTD 30 Kaki Bukit Rd 3 #04-02 Empire TechnoCentre Singapore 417819

Tel:6444 6855 FAX : 6444 7378

Project N

D2019-00162

Project Title:

PROPOSED ADDITIONS OF 1 BLOCK OF 3-STOREY OFFICE BUILDING (BLK 2), 1 BLOCK OF 6-STOREY ACCOMMODATION BUILDING (BLK 3), 1 BLOCK OF 4-STOREY ACCOMMODATION BUILDING (BLK 4), 1 BLOCK OF 2-STOREY TRAINING MULTIPLEX (BLK 9), 1 BLOCK OF MSVS (BLK 10), AND ANCILLARY FACILITIES (BLK 5, 6 & 8) TO EXISTING DIEPPE BARRACK ON LOT 05019M MK13 AT SEMBAWANG ROAD (MANDAI PLANNING AREA)

Drawing title:

BLK 2 3RD STOREY PLUMBING DRAWING

	Initial	Date		
Drawn	SAN	15.08.2024	Scale	AS SHOWN
Checked	TOMMY	15.08.2024	Software	CAD
Drawing no.:				Revision no.:
D2019-00162/BLK 2/P 03				

THIS DRAWING IS COPYRIGHT

THIS DRAWING IS THE PROPERTY OF DSTA. IF FOUND, PLEASE RETURN TO DSTA BUILDING AND INFRASTRUCTURE PROGRAMME CENTRE, 1 DEPOT ROAD, SINGAPORE 109679.
REPRODUCTION OF DRAWING WITHOUT THE WRITTEN PERMISSION OF DSTA BI IS

STRICTLY PROHIBITED. ANY UNAUTHORIZED REPRODUCTION OR POSSESSION

SHALL BE DEALT WITH UNDER THE OFFICIAL SECRETS ACT.

OFFICIAL (CLOSED)