









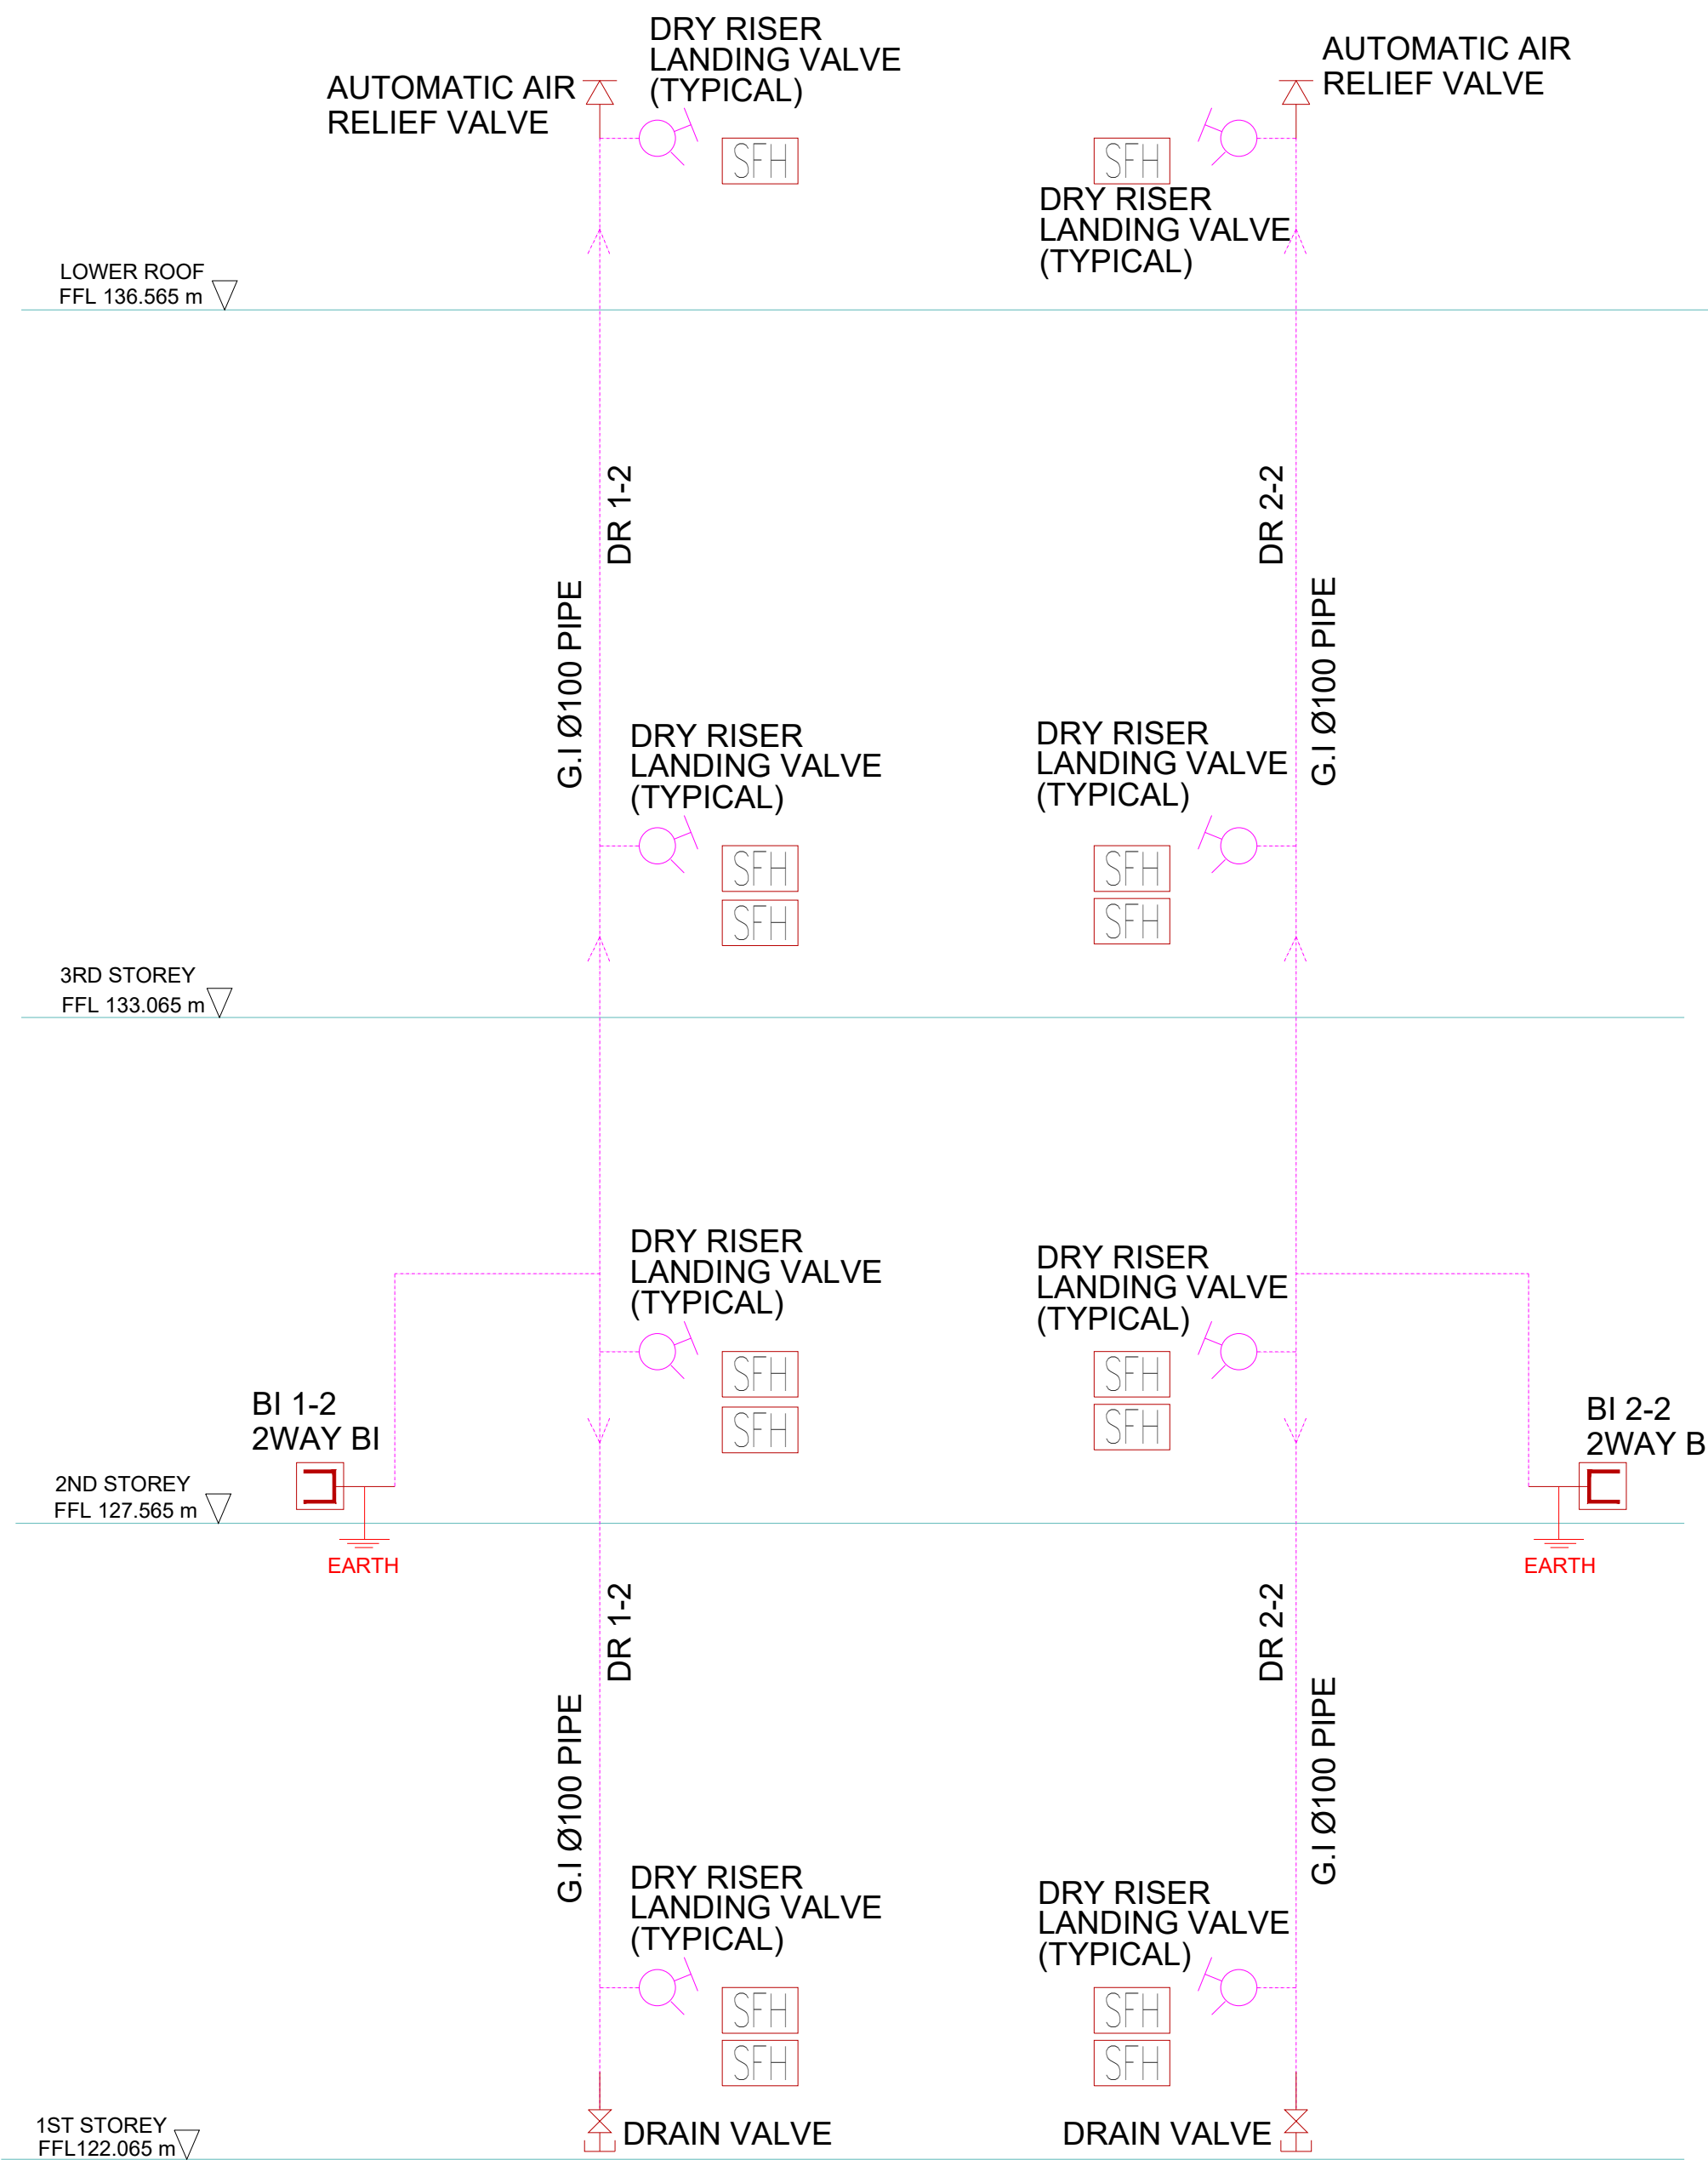
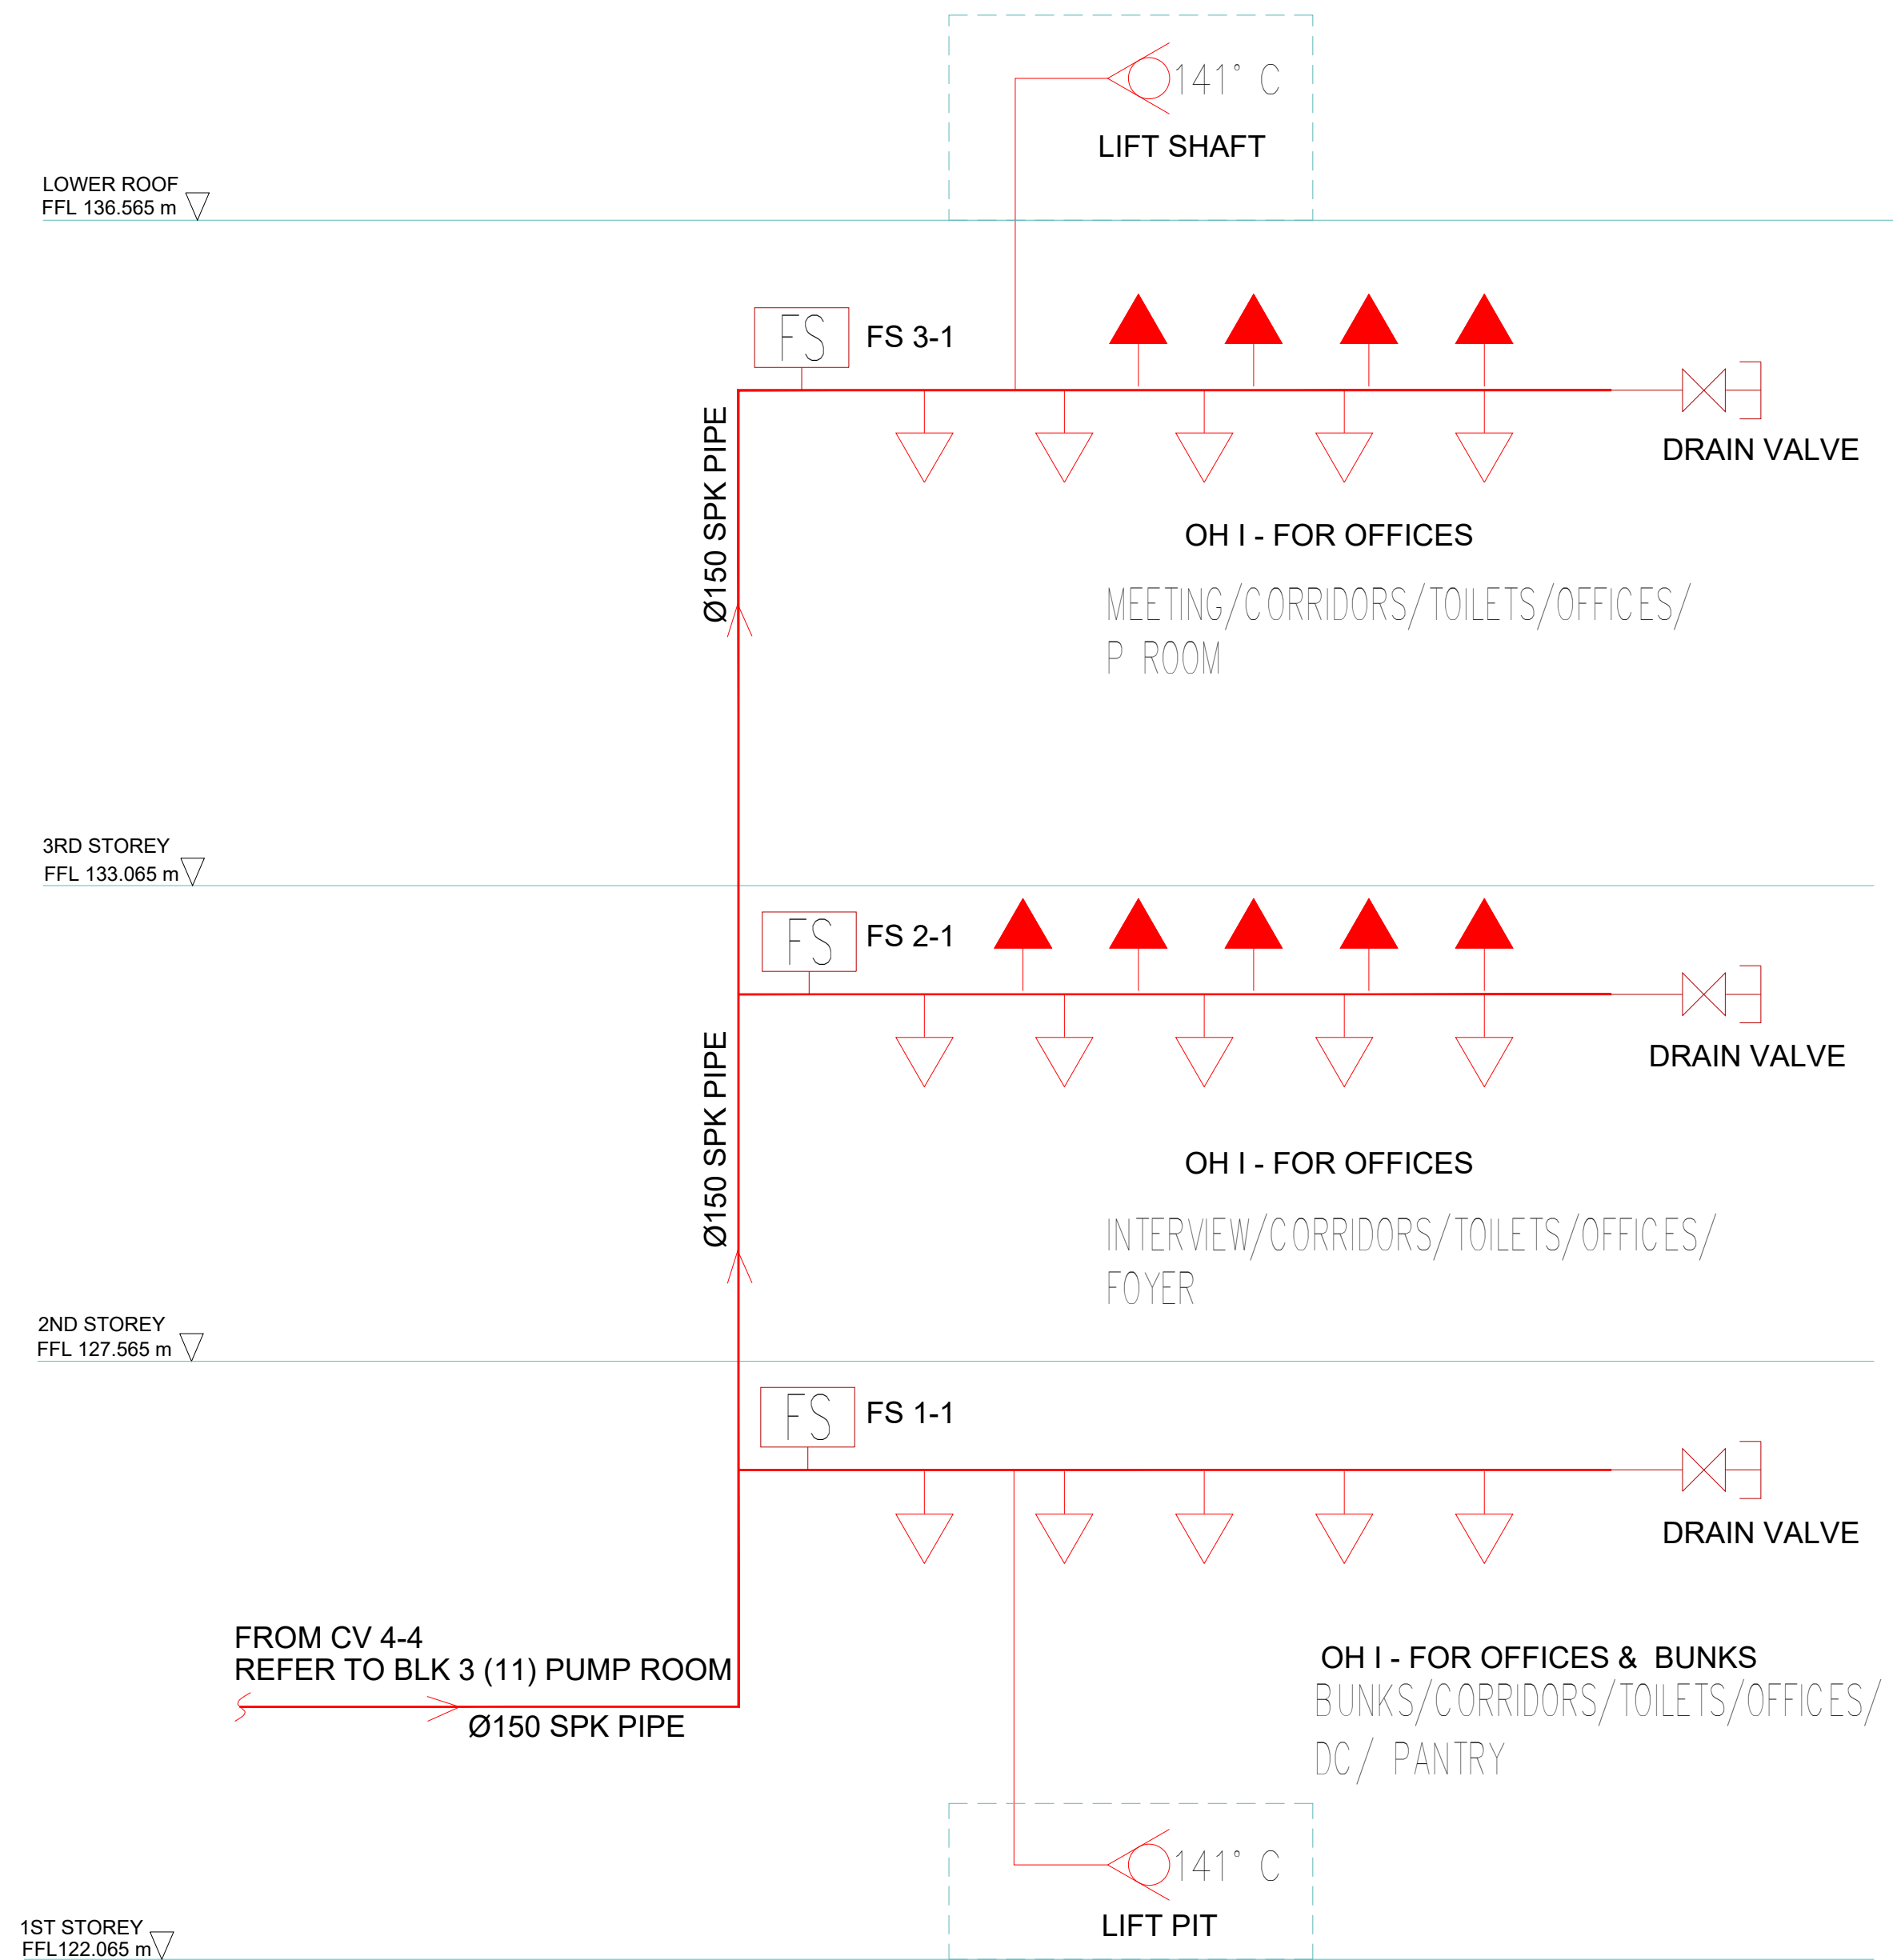


LEGEND

-  EXPOSED SPK HEAD
-  CONCEALED SPK HEAD
-  SIDEWALL SPK
-  SPRINKLER MAIN PIPE
-  FLOW SWITCH
-  DRAIN OFF VALVE
-  DRY RISER LANDING VALVE
-  DRY RISER PIPE
-  STANDBY FIRE HOSE
-  2WAY BREECHING INLET C/W CABINET



STAIRCASE-1 STAIRCASE-2

BLK 2- SPRINKLER & DRY RISER SCHEMATIC DIAGRAM

SCALE: N.T.S

AS-BUILT DRAWING

Project Ref. No. : A2105-00599-2022

M&E CONSULTANTS

PdcConsultants Pte Ltd
23 NEW INDUSTRIAL ROAD #06-03
SOLISTICE BUSINESS CENTER SINGAPORE 536209

TEL: 6444 7748
FAX: 6444 7141

DATE RECEIVED:
DATE RETURNED:

RECEIVED BY:

☐ NO EXCEPTION TAKEN
☐ TO REVISE & RESUBMIT

☐ MAKE CORRECTIONS NOTED PRIOR TO GENERAL USE
☐ REJECTED & RESUBMIT


SIGNATURE:

- WHERE RESUBMISSION IS REQUIRED, SUBMIT REVISED DRAWINGS FOR REVIEW PRIOR TO PROCEEDING WITH WORK
- THIS REVIEW IS FOR GENERAL ARRANGEMENT ONLY AND DOES NOT EXTEND TO DIMENSIONS OF SETTING OUT OF THE WORKS AND DOES NOT RELEASE THE CONTRACTOR OF HIS RESPONSIBILITIES TO ENSURE FULL COMPLIANCE
- THIS REVIEW DOES NOT RELEASE THE CONTRACTOR OF HIS RESPONSIBILITIES TO ENSURE WORKS IN COMPLIANCE TO CONTRACT SPECIFICATION, OTHER DRAWINGS AND STATUTORY REQUIREMENT HAVING JURISDICTION OVER THE INSTALLATION.

PEH SEOH CHIN
iECB (Army Camps)

EDMUND TEO KUAN WEI
Senior Programme Manager


D&B Main Contractor:

**DEENN ENGINEERING PTE LTD**
29 Harrison Road, Lian Beng Building, Singapore 369648
TEL No 6283 1468 FAX No 6280 9360
e-mail : lianbengconstrn@pacific.net.sg
Website: www.lianbeng.com.sg


Structure:

TW-ASIA Consultants Pte Ltd
NO. 28 SIN MING LANE #04-137 MIDVIEW CITY
SINGAPORE 573972 TEL : 62916292 FAX : 62932196

M&E Consultant:

**PdcConsultants Pte Ltd**
MECHANICAL - ELECTRICAL
23 New Industrial Road #06-03
Solistice Business Center
Singapore 536209
t : 6444 7748 f: 6444 7141
e: contact@pdcengrs.com

Sub Contractor:

**NORTHWAY FIRE PROTECTION PTE LTD**
BLK 2 DEFU LANE 10, #04-523
SINGAPORE 539183
TEL : 6285 2846 FAX : 6285 3409
EMAIL : northway_fire@singnet.com.sg

Project No.:

D2019-00162

Project Title:

PROPOSED ADDITIONS OF 1 BLOCK OF 3-STOREY OFFICE BUILDING (BLK 2), 1 BLOCK OF 6-STOREY ACCOMMODATION BUILDING (BLK 3), 1 BLOCK OF 4-STOREY ACCOMMODATION BUILDING (BLK 4), 1 BLOCK OF 2-STOREY TRAINING MULTIPLEX (BLK 9), 1 BLOCK OF MSVS (BLK 10), AND ANCILLARY FACILITIES (BLK 5, 6 & 8) TO EXISTING DIEPPE BARRACK ON LOT 05019M MK13 AT SEMBAWANG ROAD (MANDAI PLANNING AREA)

Drawing title:

**FIRE PROTECTION SERVICES
BLK 2
SPRINKLER & DRY RISER SCHEMATIC
DIAGRAM**

	initial	Date	Scale	
Drawn	THU ZAR	28/OCT/2024	Scale	N.T.S
Checked	ZIN KO	28/OCT/2024	Software	AUTOCAD
Drawing no.:	D2019-00162/NWFP-02-06			Revision no.:
				0