


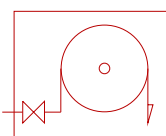


LEGEND

 HOSEREEL C/W STAINLESS STEEL CABINET


 DRAIN OFF VALVE

 HOSE REEL PIPE

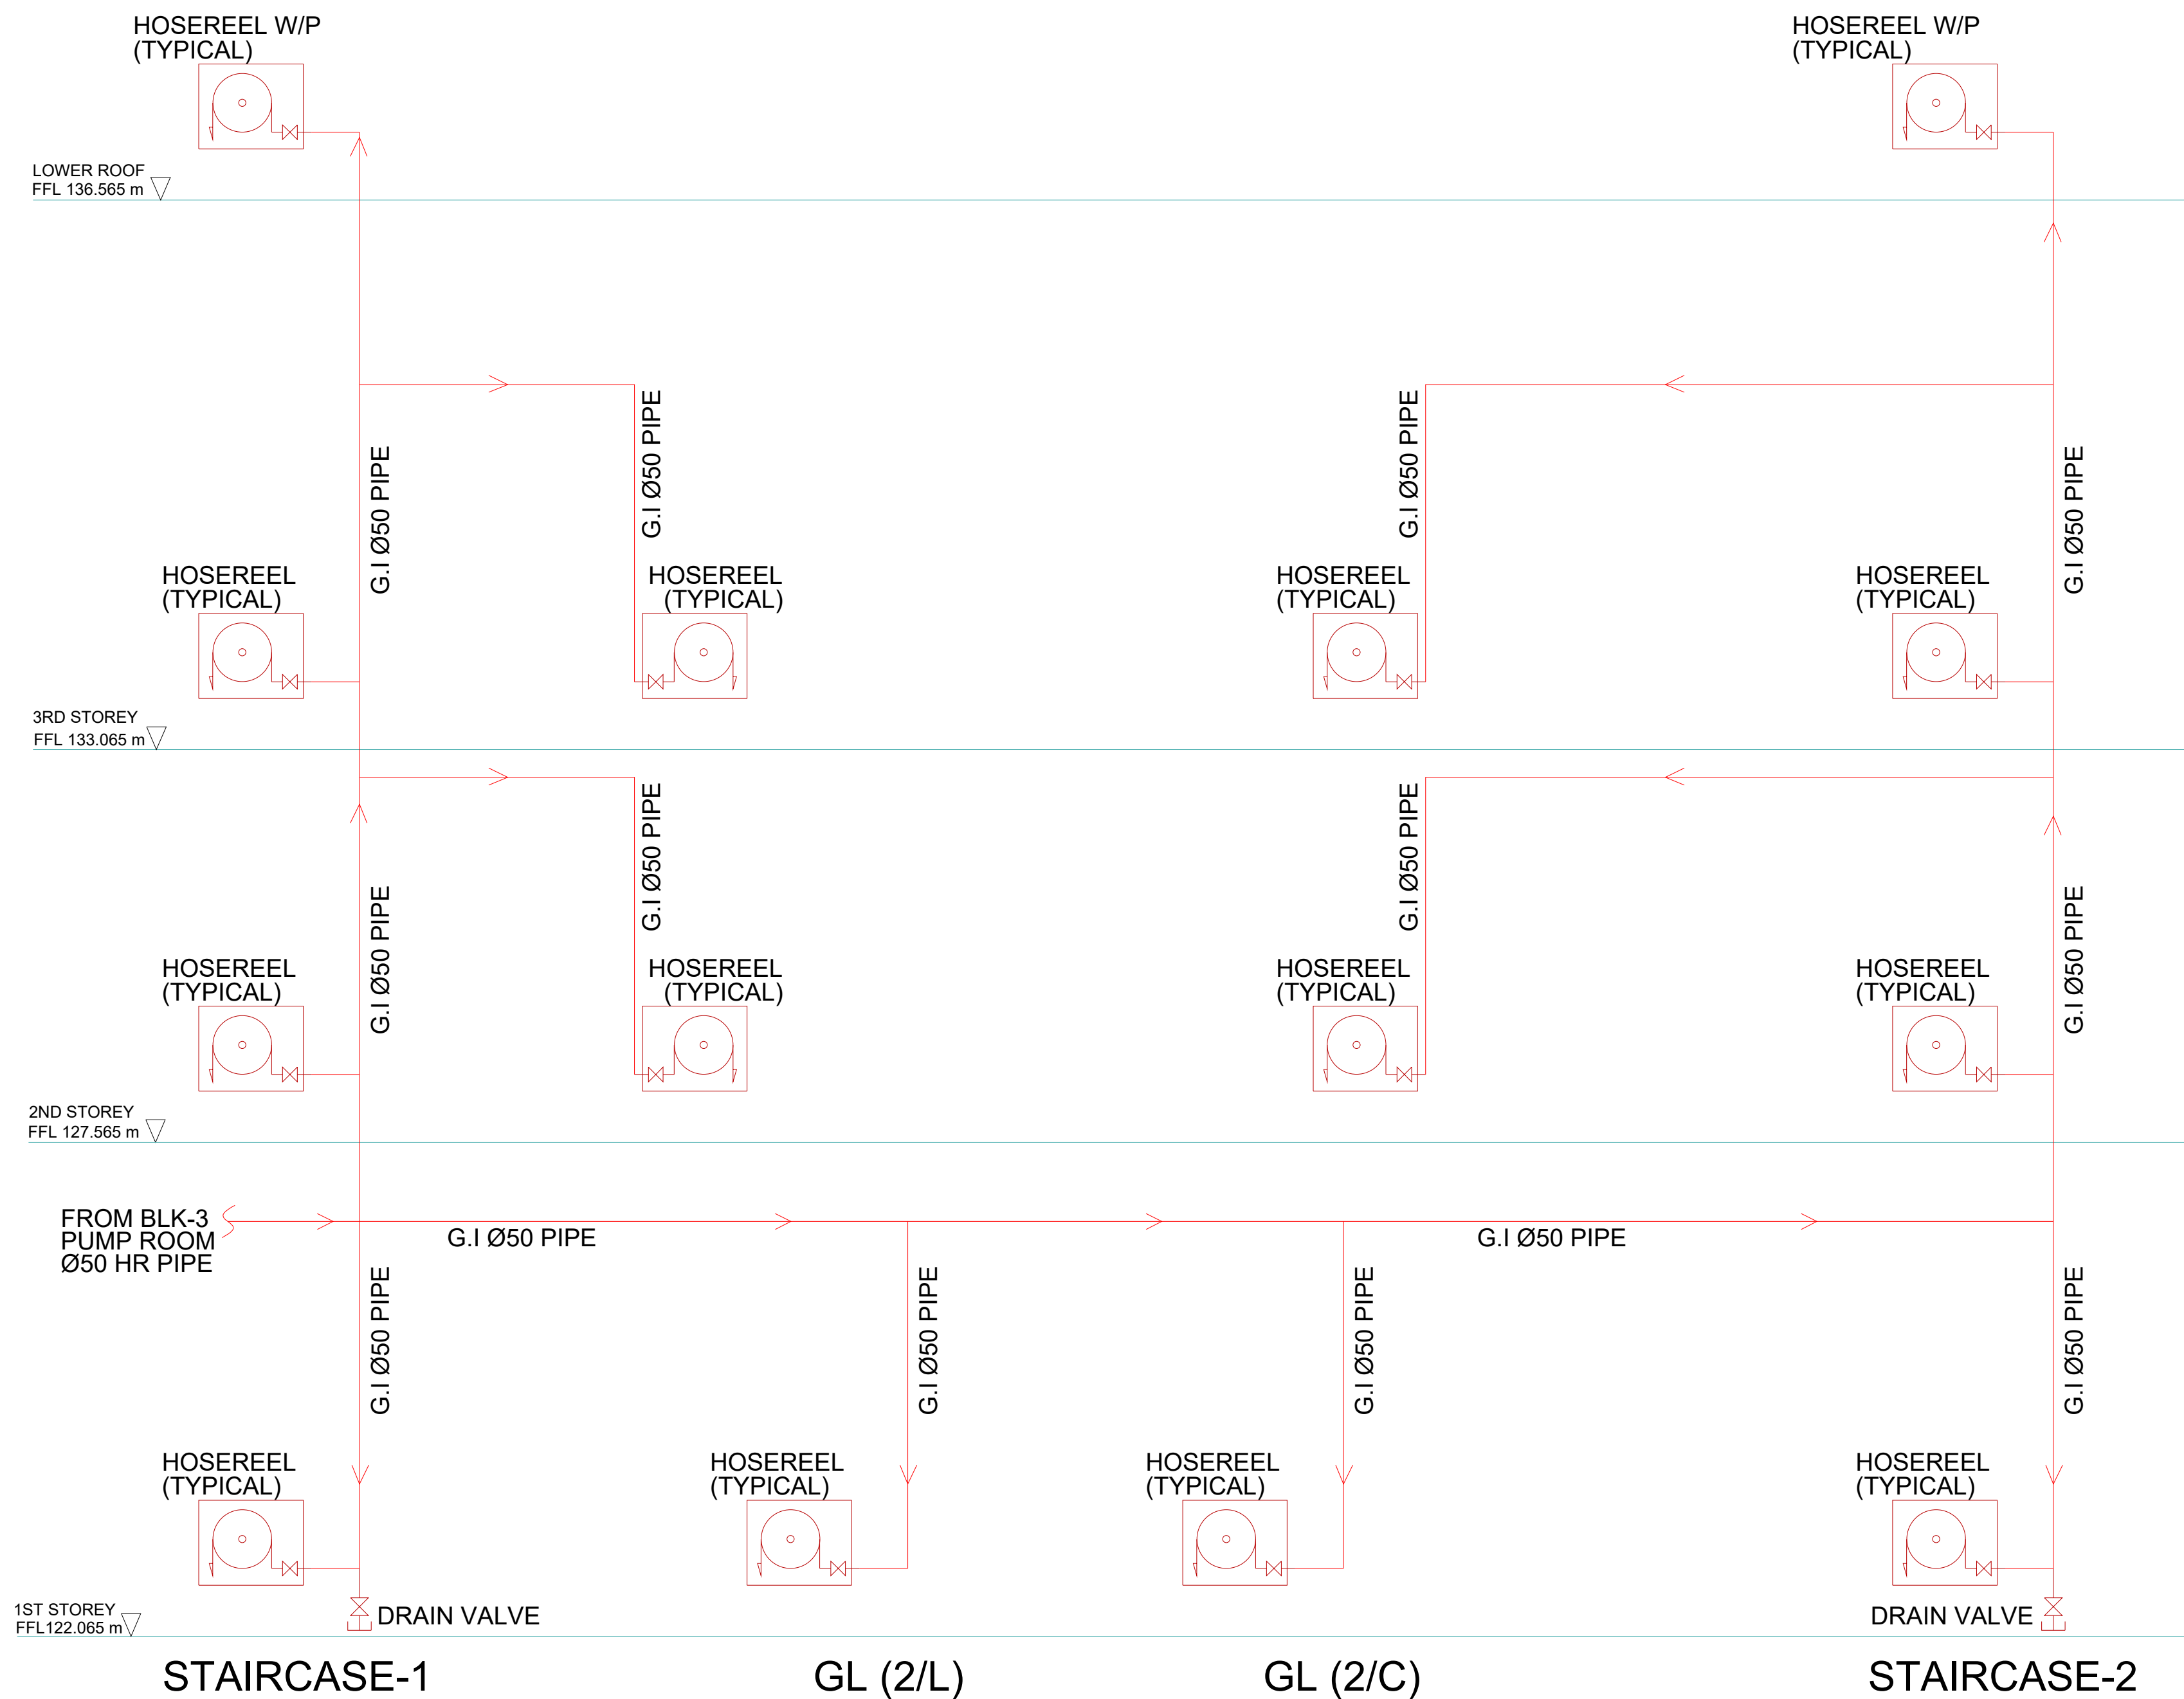

BLK 2- HOSEREEL SCHEMATIC DIAGRAM

SCALE: N.T.S

AS-BUILT DRAWING			
Project Ref. No. : A2105-00599-2022			
PEH SEOH CHIN HCB (Army Camp)		EDMUND TEO KUAN WEI Senior Programme Manager	
D&B Main Contractor:			
<div><div></div><div>DEENN ENGINEERING PTE LTD 29 Harrison Road, Lian Beng Building, Singapore 369648 TEL. No 6283 1468 FAX No. 6280 9360 e-mail : lianbengconstr@pacific.net.sg Website: www.lianbeng.com.sg</div></div>			
Structure:			
<div><div>TW-ASIA Consultants Pte Ltd</div><div>NO. 28 SIN MING LANE #04-137 MIDVIEW CITY SINGAPORE 573972 TEL : 62916292 FAX : 62932196</div></div>			
M&E Consultant:			
<div><div></div><div>PdcConsultants Pte Ltd MECHANICAL + ELECTRICAL 23 New Industrial Road #06-03 Solstice Business Center Singapore 536299 t : 6444 7748 f: 6444 7141 e: contact@pdcengrs.com</div></div>			
Sub Contractor:			
<div><div></div><div>NORTHWAY FIRE PROTECTION PTE LTD BLK 2 DEFU LANE 10, #04-523 SINGAPORE 539183 TEL : 6285 2846 FAX : 6285 3409 EMAIL : northway_fire@singnet.com.sg</div></div>			
Project No.:			
D2019-00162			
Project Title:			
PROPOSED ADDITIONS OF 1 BLOCK OF 3-STOREY OFFICE BUILDING (BLK 2), 1 BLOCK OF 6-STOREY ACCOMMODATION BUILDING (BLK 3), 1 BLOCK OF 4-STOREY ACCOMMODATION BUILDING (BLK 4), 1 BLOCK OF 2-STOREY TRAINING MULTIPLEX (BLK 9), 1 BLOCK OF MSVS (BLK 10), AND ANCILLARY FACILITIES (BLK 5, 6 & 8) TO EXISTING DIEPPE BARRACK ON LOT 05019M MK13 AT SEMBAWANG ROAD (MANDAI PLANNING AREA)			
Drawing title:			
FIRE PROTECTION SERVICES BLK 2 HOSEREEL & SCHEMATIC DIAGRAM			
	Initial	Date	Scale
Drawn	THU ZAR	18/12/24	N.T.S
Checked	ZIN KO	18/12/24	Software
			AUTOD CAD
Drawing no.:		Revision no.:	
D2019-00162/NWFP-02-04		0	