
Scale: 1:250

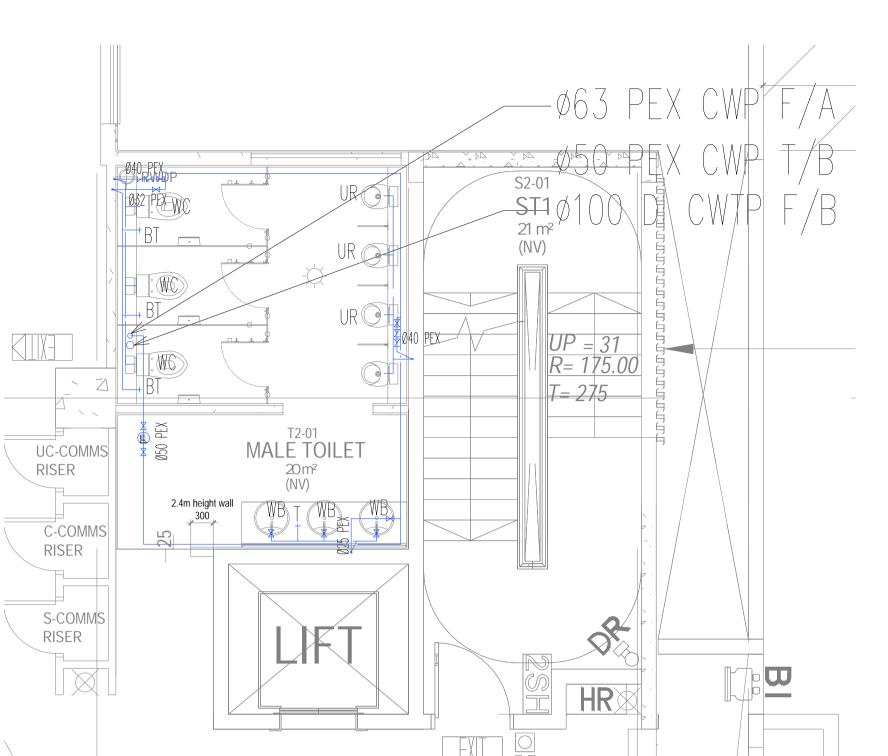

BLOW -UP PLAN 1-1 Scale: 1:50

T2-02
FEMALE TOILET RISER 2

6m
(MV)
ST T2-04
MALE
TOILET
WD
WD
SZ-02
ST2
21 m
(NV)
RND
PROPOSED POWDER

BLOW -UP PLAN 2-2 Scale: 1:50 'AS-BUILT'

Project Ref. No.: A2105-00599-2022

TOKE.

M&E CONSULTANTS

DATE RECEIVED:

DATE RETURNED:

PdcConsultants Pte Ltd
23 NEW INDUSTRIAL ROAD #06-03
SOLSTICE BUSINESS CENTER SINGAPORE 536209

WHERE RESUBMISSION IS REQUIRED, SUBMIT REVISED DRAWINGS FOR REVIEW PRIOR TO PROCEEDING WITH WORK
 THIS REVIEW IS FOR GENERAL ARRANGEMENT ONLY AND DOES NOT EXTEND TO DIMENSIONS OF SETTING OUT OF
 THE WORKS AND DOES NOT RELEASE THE CONTRACTOR OF HIS RESPONSIBILITIES TO ENSURE FULL COMPLIANCE
 THIS REVIEW DOES NOT RELEASE THE CONTRACTOR OF HIS RESPONSIBILITIES TO ENSURE WORKS IN COMPLIANCE
 TO CONTRACT SPECIFICATION, OTHER DRAWINGS AND STATUTORY REQUIREMENT HAVING JURISDICTION OVER THE
 INSTALLATION.

 $\ \square$  NO EXCEPTION TAKEN  $\ \square$  MAKE CORRECTIONS NOTED PRIOR TO GENERAL USE

RECEIVED BY:

☐ TO REVISE & RESUBMIT ☐ REJECTED & RESUBMIT





PEH SEOH CHIN HCD (Army Camps)

Senior Programme Manager

EDMUND TEO KUAN WEI

D&B Main Contractor:

DEENN I

DEENN ENGINEERING PTE LTD

29 Harrison Road, Lian Beng Building, Singapore 369648

TEL. No.6283 1468 FAX No. 6280 9360
e-mail: lianbengconstn@pacific.net.sg
Website: www.lianbeng.com.sg

Architect:

ID ARCHITECTS PTE LTD

3 HarbourFront Place, #03-01.

3 HarbourFront Place, #03-01, HarbourFront Tower Two, Singapore 099254 Tel:6225 6011 Fax:6225 6022 general@idarchitects.com.sg www.idarchitects.com.sg



Structure:

TW- ASIA Consultants Pte Ltd

NO. 28 SIN MING LANE #04-137 MIDVIEW CITY

SINGAPORE 573972 TEL : 62916292 FAX : 62932196

M&E Consultant:



Pdc Consultants Pte Ltd
MECHANICAL + ELECTRICAL
Paya Lebar Square

#10-17/18 (Office Lobby 1)

60 Paya Lebar Road Singapore 409051 t:6444 7748 f:6444 7141 e:contact@pdcengrs.com

Sub Contractor:



WATERTECH PLUMBING & CONSTRUCTION PTE LTD
30 Kaki Bukit Rd 3 #04-02
Empire TechnoCentre
Singapore 417819
Tel:6444 6855 FAX: 6444 7378

Project No.:

D2019-00162

Project Title:

PROPOSED ADDITIONS OF 1 BLOCK OF 3-STOREY OFFICE BUILDING (BLK 2), 1 BLOCK OF 6-STOREY ACCOMMODATION BUILDING (BLK 3), 1 BLOCK OF 4-STOREY ACCOMMODATION BUILDING (BLK 4), 1 BLOCK OF 2-STOREY TRAINING MULTIPLEX (BLK 9), 1 BLOCK OF MSVS (BLK 10), AND ANCILLARY FACILITIES (BLK 5, 6 & 8) TO EXISTING DIEPPE BARRACK ON LOT 05019M MK13 AT SEMBAWANG ROAD (MANDAI PLANNING AREA)

Drawing title:

BLK 2 2ND STOREY PLUMBING DRAWING

	Initial	Date		
Drawn	SAN	15.08.2024	Scale	AS SHOWN
Checked	TOMMY	15.08.2024	Software	CAD
Drawing no.:				Revision no.:
D2019-00162/BLK 2/P 02				

THIS DRAWING IS COPYRIGHT

THIS DRAWING IS THE PROPERTY OF DSTA. IF FOUND, PLEASE RETURN TO DSTA BUILDING AND INFRASTRUCTURE PROGRAMME CENTRE, 1 DEPOT ROAD, SINGAPORE 109679.

REPRODUCTION OF DRAWING WITHOUT THE WRITTEN PERMISSION OF DSTA BI IS STRICTLY PROHIBITED. ANY UNAUTHORIZED REPRODUCTION OR POSSESSION SHALL BE DEALT WITH UNDER THE OFFICIAL SECRETS ACT.

OFFICIAL (CLOSED)