

PEH SEOH CHIN  
HCO (Army Camps)

EDMUND TEO KUAN WEI  
Senior Programme Manager

DAB Main Contractor:

**DEENN ENGINEERING PTE LTD**  
29 Harrison Road, Lian Beng Building, Singapore 369648  
TEL: No. 6283 1468 FAX: No. 6280 9360  
e-mail: lianbengconstr@pacific.net.sg  
Website: www.lianbeng.com.sg

Architect:

**ID ARCHITECTS PTE LTD**  
3 HarbourFront Place, #03-01,  
HarbourFront Tower Two,  
Singapore 099254  
Tel: 6225 6011  
Fax: 6225 6022  
general@idarchitects.com.sg  
www.idarchitects.com.sg

Structure:

**TW-ASIA Consultants Pte Ltd**  
No. 28 Sin Ming Lane #04-137 Midview City  
Singapore 573972  
Tel: 62916232 Fax: 62932196

MEP Consultant:

**Pdc Consultants Pte Ltd**  
MECHANICAL - ELECTRICAL  
23 New Industrial Road #06-03  
Solstice Business Center  
Singapore 536209  
t: 6444 7748 f: 6444 7141  
e: contact@pdcengrs.com

Sub Contractor:

Project No.:  
D2019-00162


Project Title:  
PROPOSED ADDITIONS OF 1 BLOCK OF 3-STORY OFFICE BUILDING BLK 2, 1 BLOCK OF 6-STORY ACCOMMODATION BUILDING BLK 3 (11), 1 BLOCK OF 4-STORY ACCOMMODATION BUILDING BLK 4 (10), 1 BLOCK OF 2-STORY TRAINING MULTIPLEX BLK 9 (6), 1 BLOCK OF MSVS BLK 10 (9), AND ANCILLARY FACILITIES BLK 5, 6(4) & 8 TO EXISTING DIEPPE BARRACK ON LOT 06019M MK13 AT SEMBAWANG ROAD (MANDAI PLANNING AREA)

Drawing title:  
Block 2  
1st & 2nd Storey Plan


Drawn	Initial	Date	Scale
SM/JV		15/01/2025	
Checked	Initial	Date	Software
RONY		15/01/2025	
Drawing no.:	Revision no.:		
D2019-00162/	-		

THIS DRAWING IS THE PROPERTY OF DSTA. IF FOUND, PLEASE RETURN TO DSTA BUILDING AND INFRASTRUCTURE PROGRAMME CENTRE, 1 DEPOT ROAD, SINGAPORE 109679. REPRODUCTION OF DRAWING WITHOUT THE WRITTEN PERMISSION OF DSTA IS STRICTLY PROHIBITED. ANY UNAUTHORIZED REPRODUCTION OR POSSESSION SHALL BE DEALT WITH UNDER THE OFFICIAL SECRETS ACT.



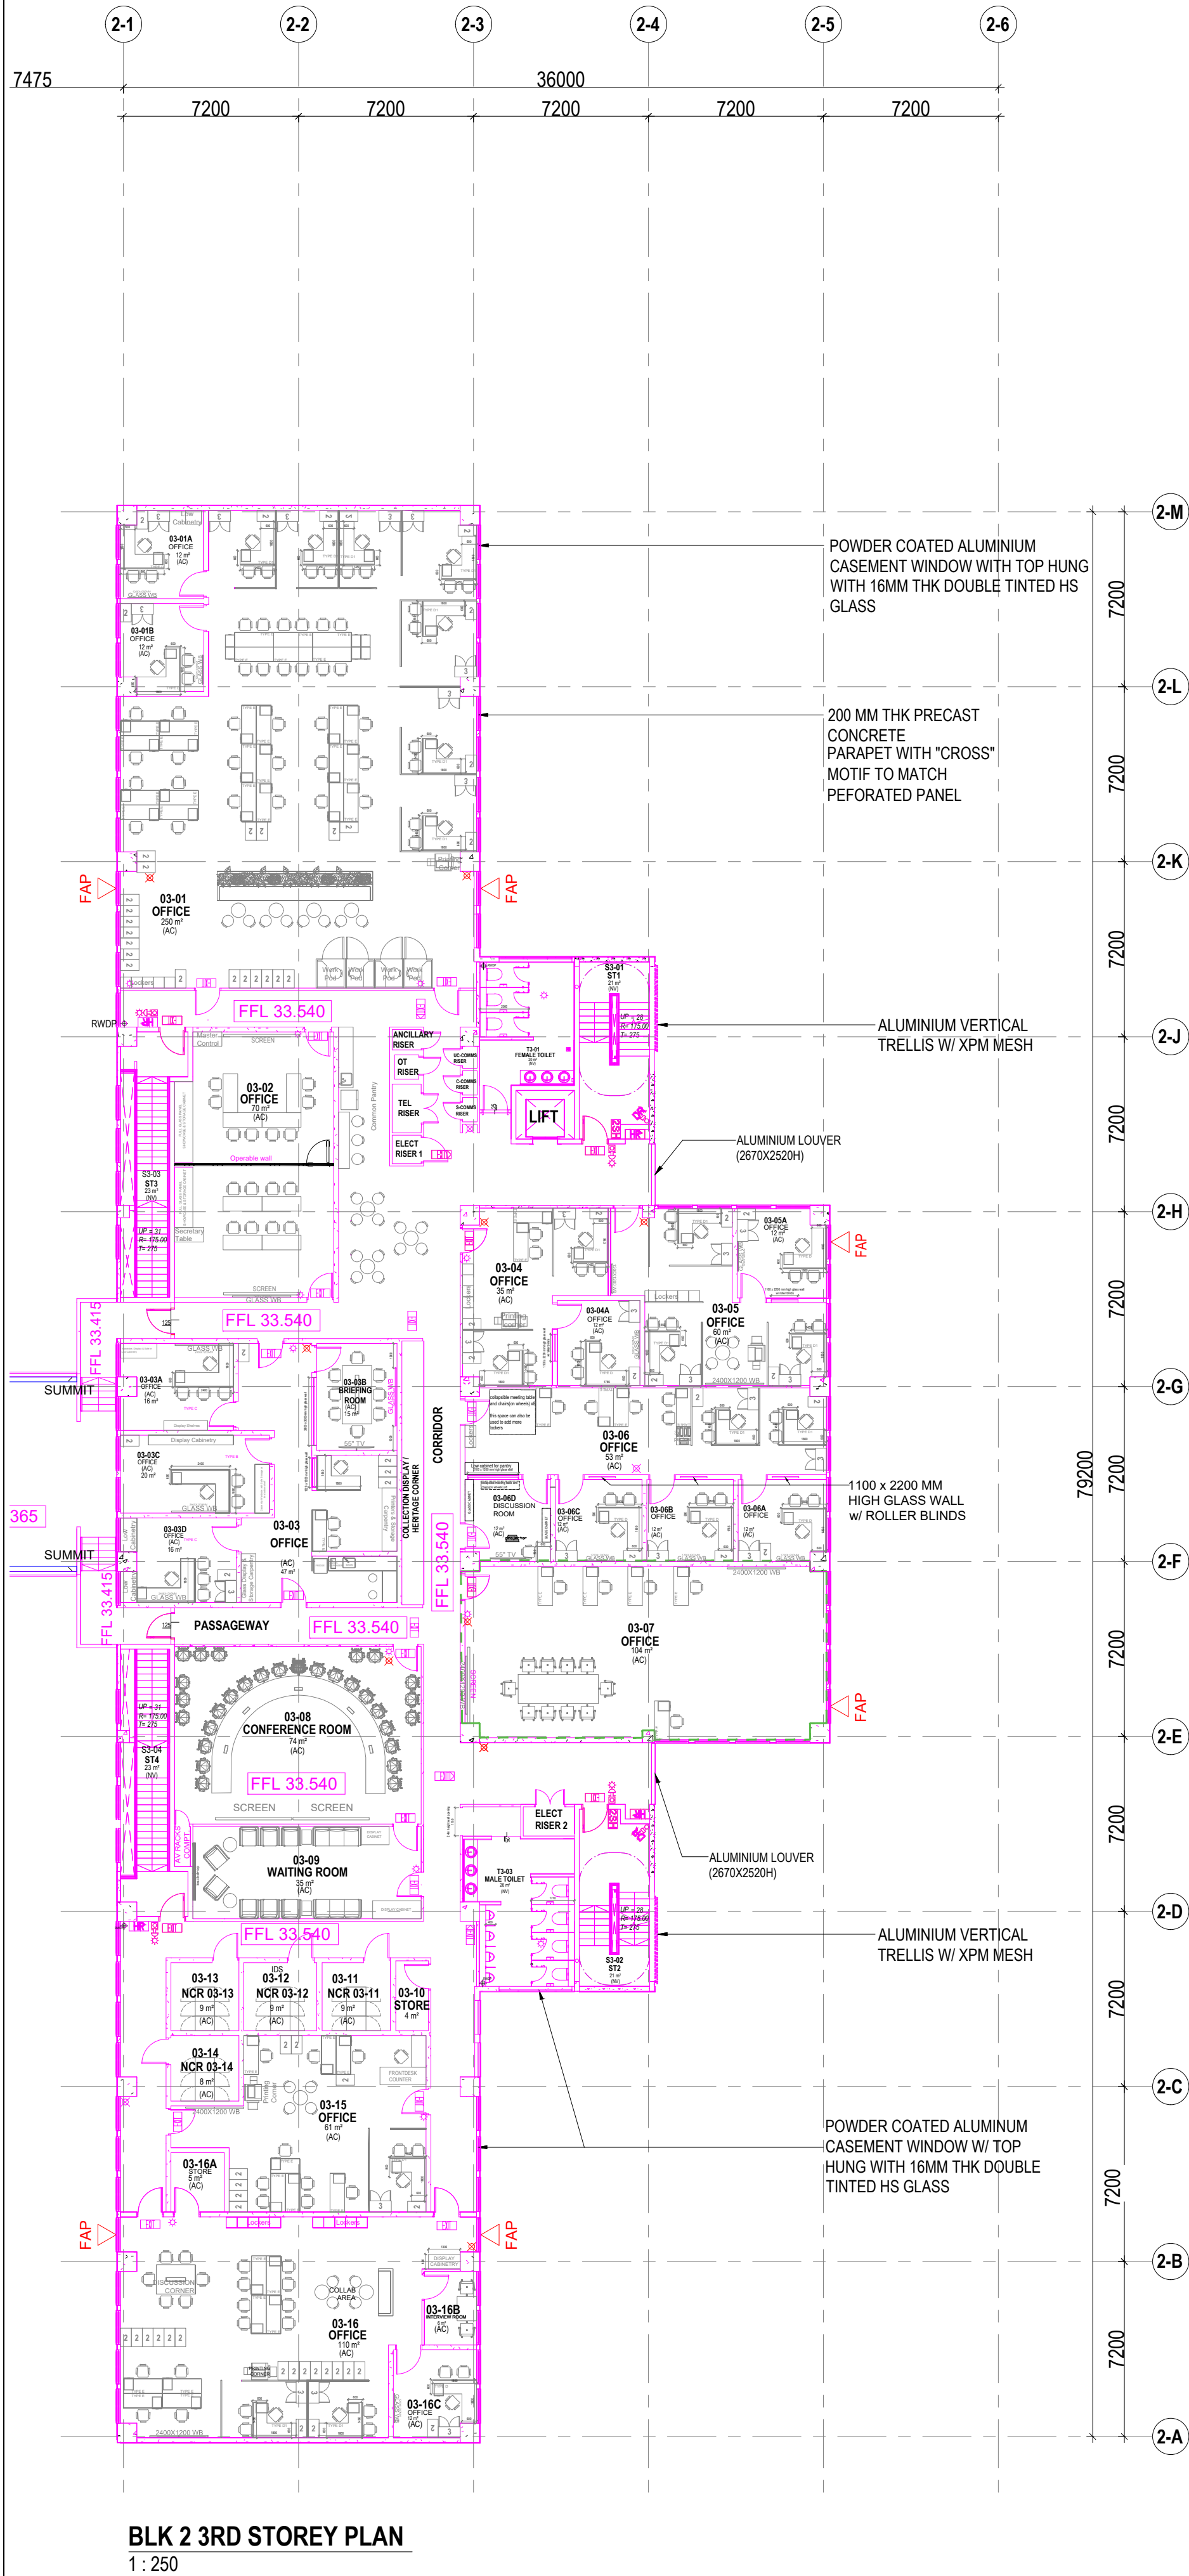

BLK 2 3RD STOREY PLAN  
1:250

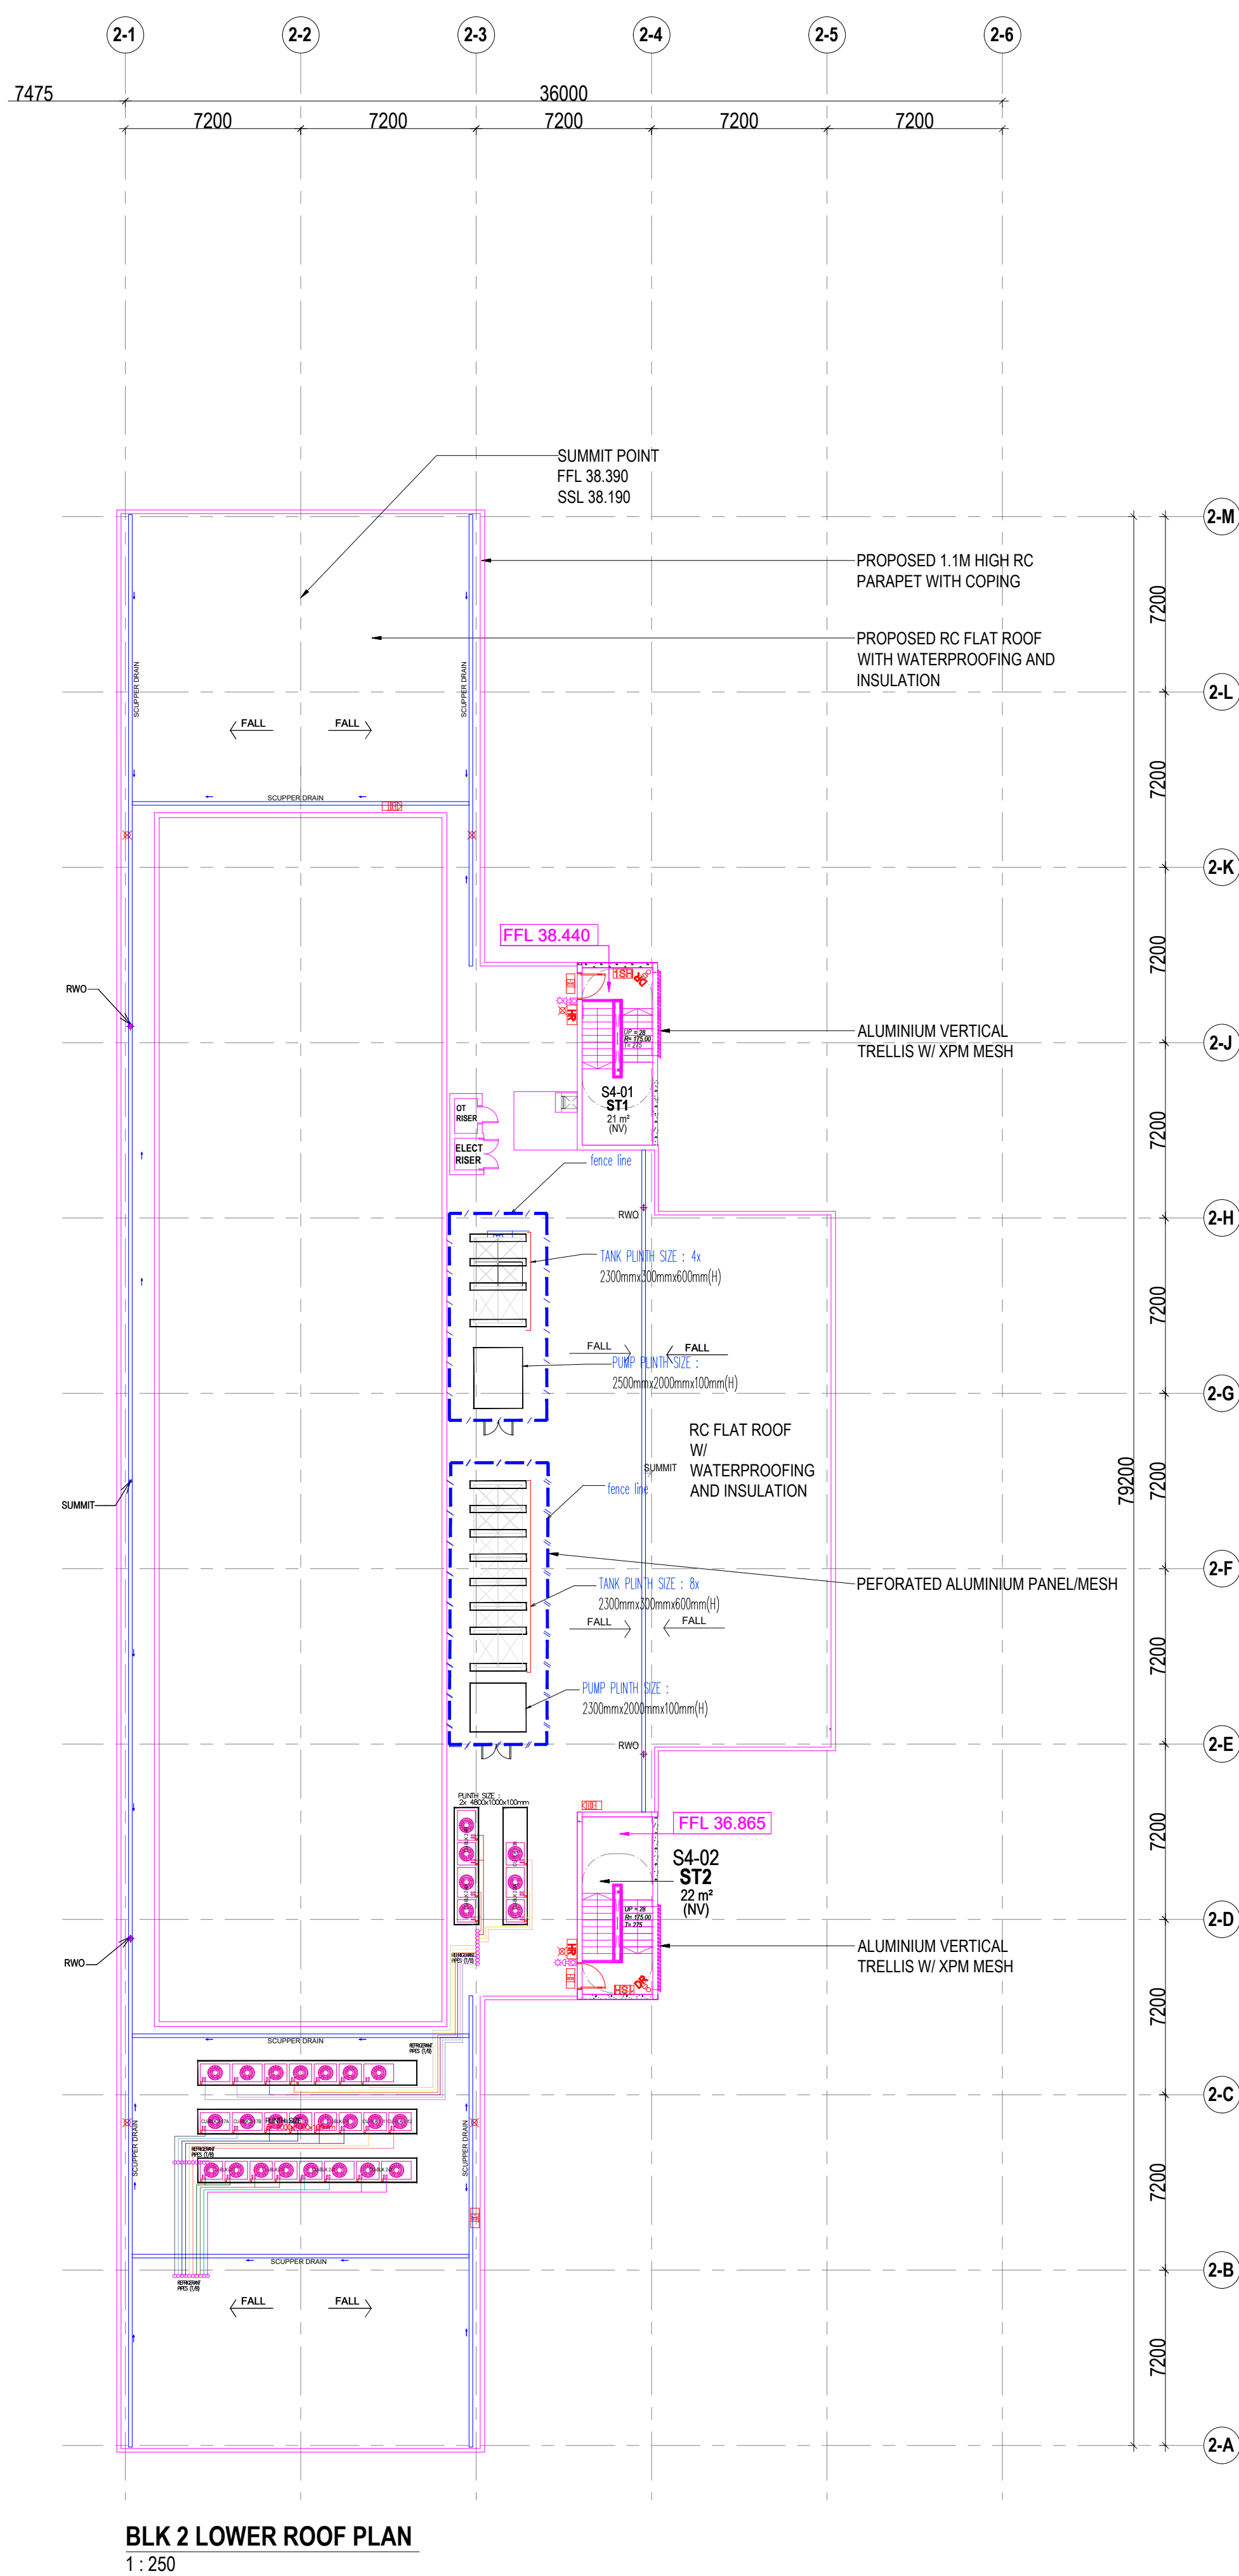

BLK 2 LOWER ROOF PLAN  
1:250



PEH SEOH CHIN  
MCD (Army Corps)

EDMUND TEO KUAN WEI  
Senior Programme Manager

DAB Main Contractor:

**DEENN ENGINEERING PTE LTD**  
29 Harrison Road, Lian Beng Building, Singapore 369648  
TEL No 6283 1468 FAX No 6280 9360  
e-mail : lianbengconstrn@pacific.net.sg  
Website: www.lianbeng.com.sg

Architect:

**ID ARCHITECTS PTE LTD**  
3 HarbourFront Place, #03-01,  
HarbourFront Tower Two,  
Singapore 099254  
Tel 6225 6011  
Fax 6225 6022  
general@idarchitects.com.sg  
www.idarchitects.com.sg

Structure:

**TW-ASIA Consultants Pte Ltd**  
No 28 Sin Ming Lane #04-137 Midview City  
Singapore 573972  
Tel : 62916232 Fax: 62932196

M&E Consultant:

**Pdc Consultants Pte Ltd**  
MECHANICAL & ELECTRICAL  
23 New Industrial Road #06-03  
Solstice Business Center  
Singapore 536209  
t: 6444 7748 f: 6444 7141  
e: contact@pdcengrs.com

Sub Contractor:


Project No.:  
D2019-00162

Project Title:  
PROPOSED ADDITIONS OF 1 BLOCK OF 3-STOREY OFFICE BUILDING BLK 2, 1 BLOCK OF 6-STOREY ACCOMMODATION BUILDING BLK 3 (11), 1 BLOCK OF 4-STOREY ACCOMMODATION BUILDING BLK 4 (10), 1 BLOCK OF 2-STOREY TRAINING MULTIPLEX BLK 9 (6), 1 BLOCK OF MSVS BLK 10 (9), AND ANCILLARY FACILITIES BLK 5, 6(4) & 8 TO EXISTING DIEPPE BARRACK ON LOT 06019M MK13 AT SEMBANG ROAD (MANDAI PLANNING AREA)

Drawing title:  
Block 2  
3RD STY PLAN & LWR ROOF PLAN

Drawn	Initial	Date	Scale
Checked	SM/JN	22/02/2025	
Checked	RONY	22/02/2025	Software
Drawing no.:	Revision no.:		
D2019-00162/	-		

THIS DRAWING IS THE PROPERTY OF DSTA. IF FOUND, PLEASE RETURN TO  
DSTA BUILDING AND INFRASTRUCTURE PROGRAMME  
CENTRE, 1 DEPOT ROAD, SINGAPORE 109679.  
REPRODUCTION OF DRAWING WITHOUT THE WRITTEN PERMISSION OF DSTA  
IS STRICTLY PROHIBITED. ANY UNAUTHORIZED  
REPRODUCTION OR POSSESSION SHALL BE DEALT WITH UNDER THE  
OFFICIAL SECRETS ACT.

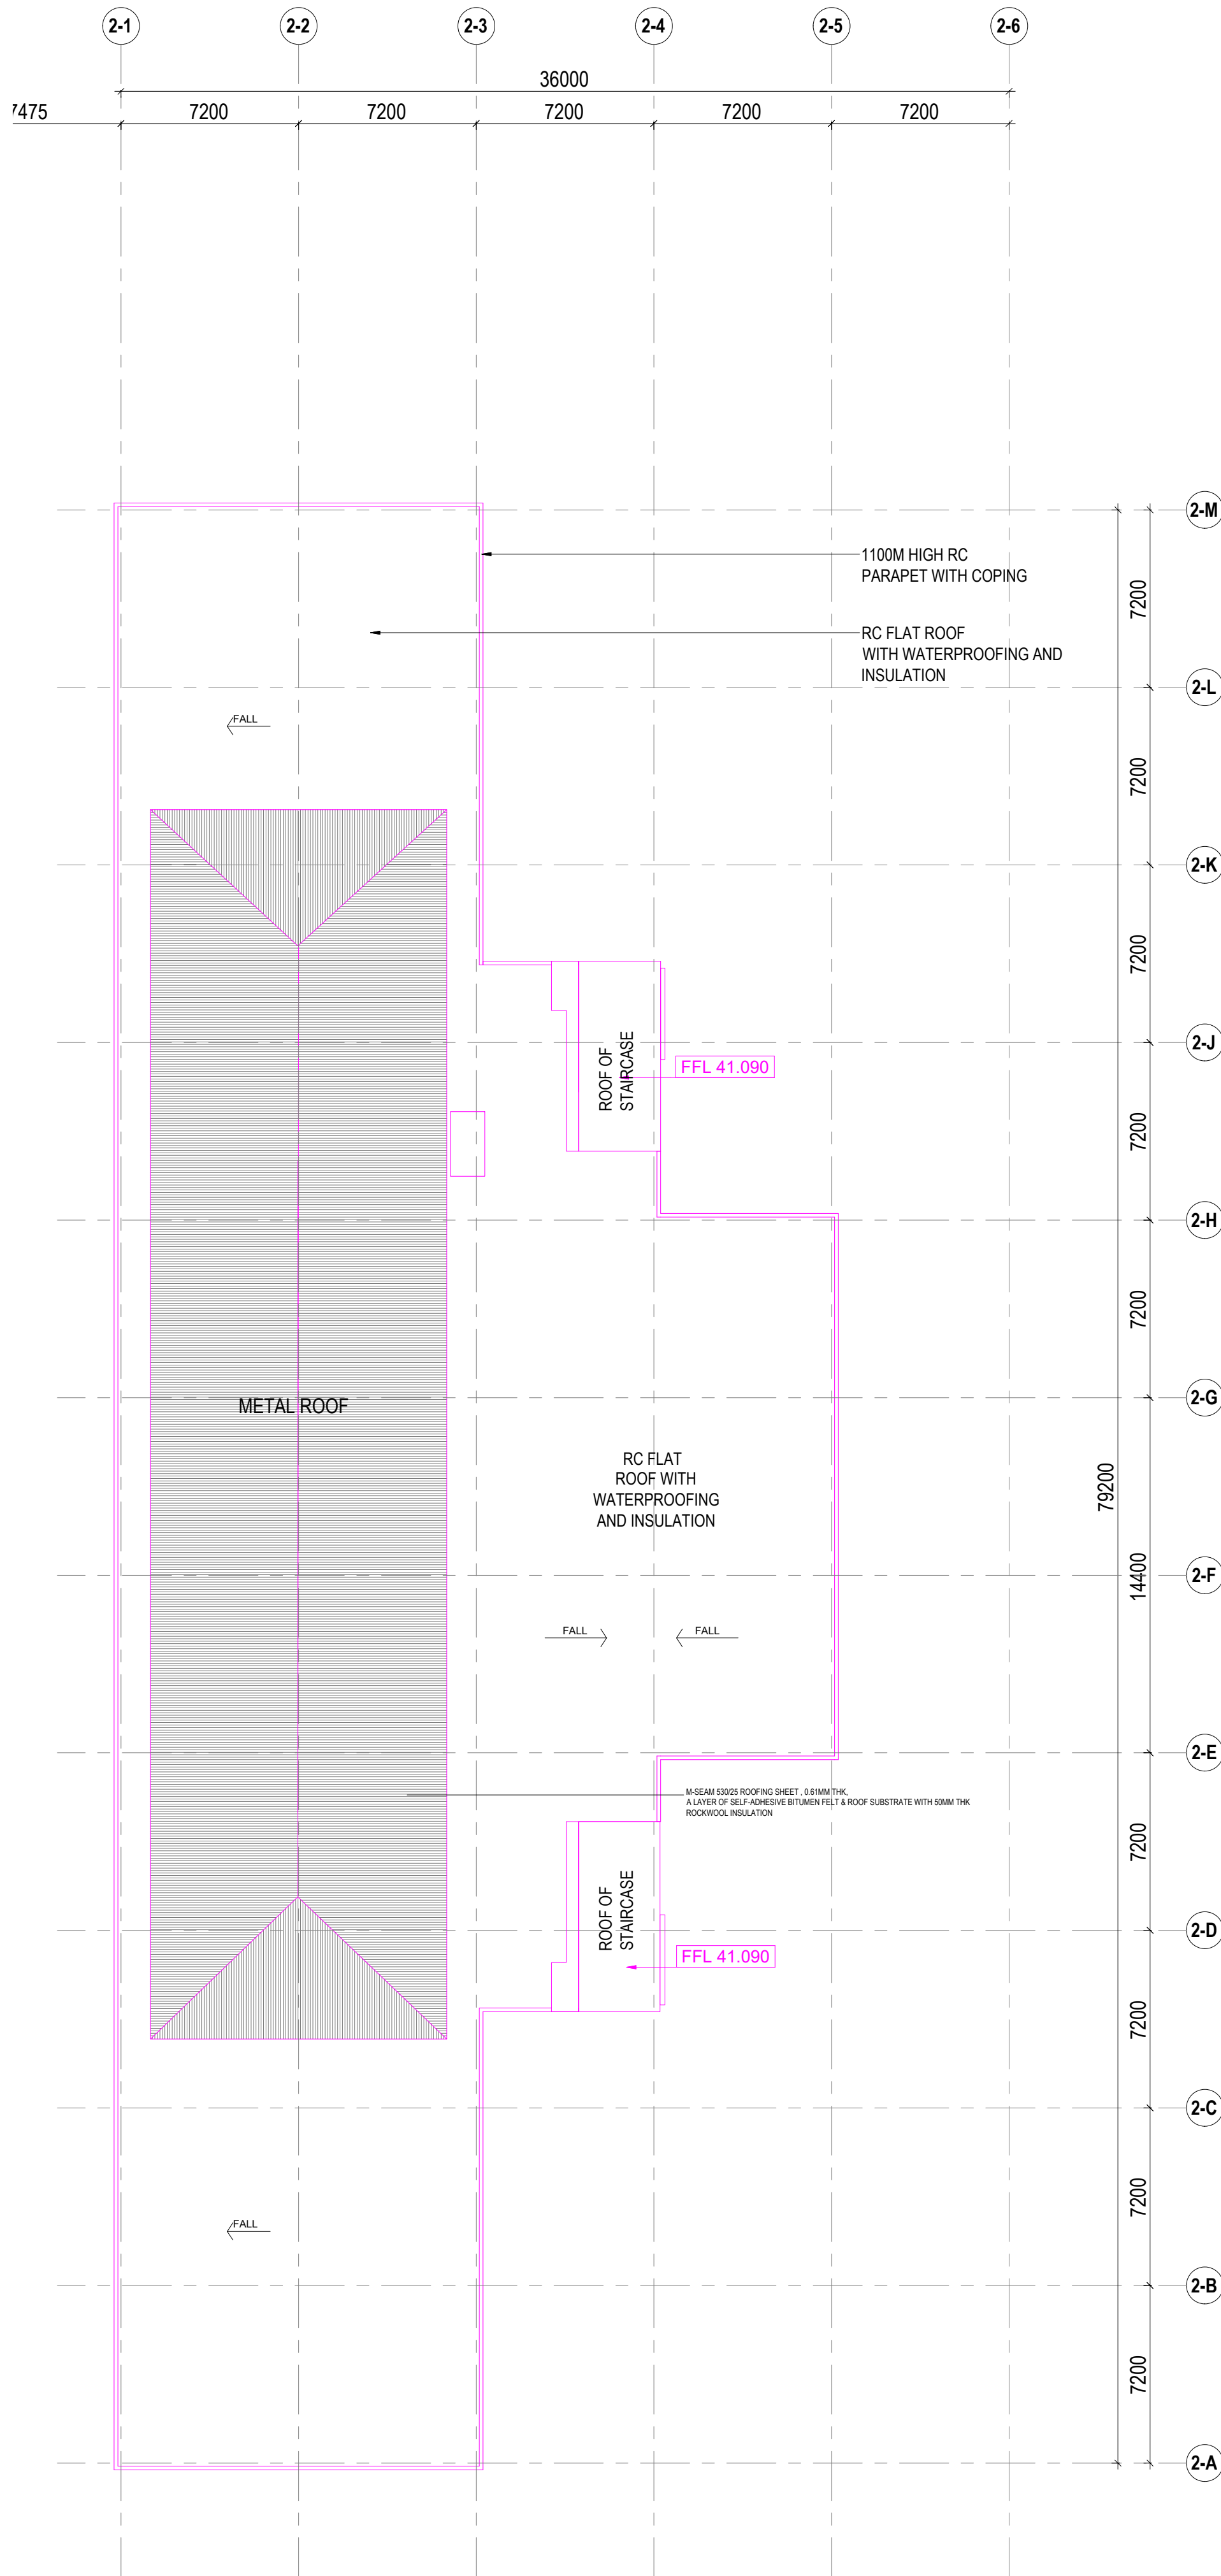

BLK 2 UPPER ROOF PLAN  
1 : 250

AS-BUILT DRAWING

Project Ref. No. : A2105-00599-2022



PEH SEOH CHIN  
WCO (Army Corps)

EDMUND TEO KUAN WEI  
Senior Programme Manager

DAB Main Contractor:

**DEENN ENGINEERING PTE LTD**  
29 Harrison Road, Lian Beng Building, Singapore 369648  
TEL No. 6283 1468 FAX No. 6280 9360  
e-mail : lianbengconstrn@pacific.net.sg  
Website: www.lianbeng.com.sg

Architect:  
**ID ARCHITECTS PTE LTD**  
3 HarbourFront Place, #03-01,  
HarbourFront Tower Two,  
Singapore 099254  
Tel 6225 6011  
Fax 6225 6022  
general@idarchitects.com.sg  
www.idarchitects.com.sg

Structure:  
**TW-ASIA Consultants Pte Ltd**  
No.28 Sin Ming Lane #04-137 Midview City  
Singapore 573972  
Tel : 62916292 Fax: 62932196

M&E Consultant:  
**PdcConsultants Pte Ltd**  
MECHANICAL ELECTRICAL  
23 New Industrial Road #06-03  
Solstice Business Center  
Singapore 536209  
t : 6444 7748 f: 6444 7141  
e: contact@pdcengrs.com

Sub Contractor:

Project No.:  
D2019-00162


Project Title:  
PROPOSED ADDITIONS OF 1 BLOCK OF 3-STOREY OFFICE BUILDING BLK 2, 1 BLOCK OF 6-STOREY ACCOMMODATION BUILDING BLK 3 (11), 1 BLOCK OF 4-STOREY ACCOMMODATION BUILDING BLK 4 (10), 1 BLOCK OF 2-STOREY TRAINING MULTIPLEX BLK 9 (6), 1 BLOCK OF MSVS BLK 10 (9), AND ANCILLARY FACILITIES BLK 5, 6(4) & 8 TO EXISTING DIEPPE BARRACK ON LOT 06019M MK13 AT SEMBAWANG ROAD (MANDAI PLANNING AREA)

Drawing title:  
Block 2  
UPPER ROOF PLAN


	Initial	Date	Scale	
Drawn	SM/JV	22/02/2025	Scale	
Checked	RONY	22/02/2025	Software	
Drawing no.:	D2019-00162/			Revision no.:
				-

THIS DRAWING IS THE PROPERTY OF DSTA. IF FOUND, PLEASE RETURN TO  
DSTA BUILDING AND INFRASTRUCTURE PROGRAMME  
CENTRE, 1 DEPOT ROAD, SINGAPORE 109679.  
REPRODUCTION OF DRAWING WITHOUT THE WRITTEN PERMISSION OF DSTA  
IS STRICTLY PROHIBITED. ANY UNAUTHORIZED  
REPRODUCTION OR POSSESSION SHALL BE DEALT WITH UNDER THE  
OFFICIAL SECRETS ACT.



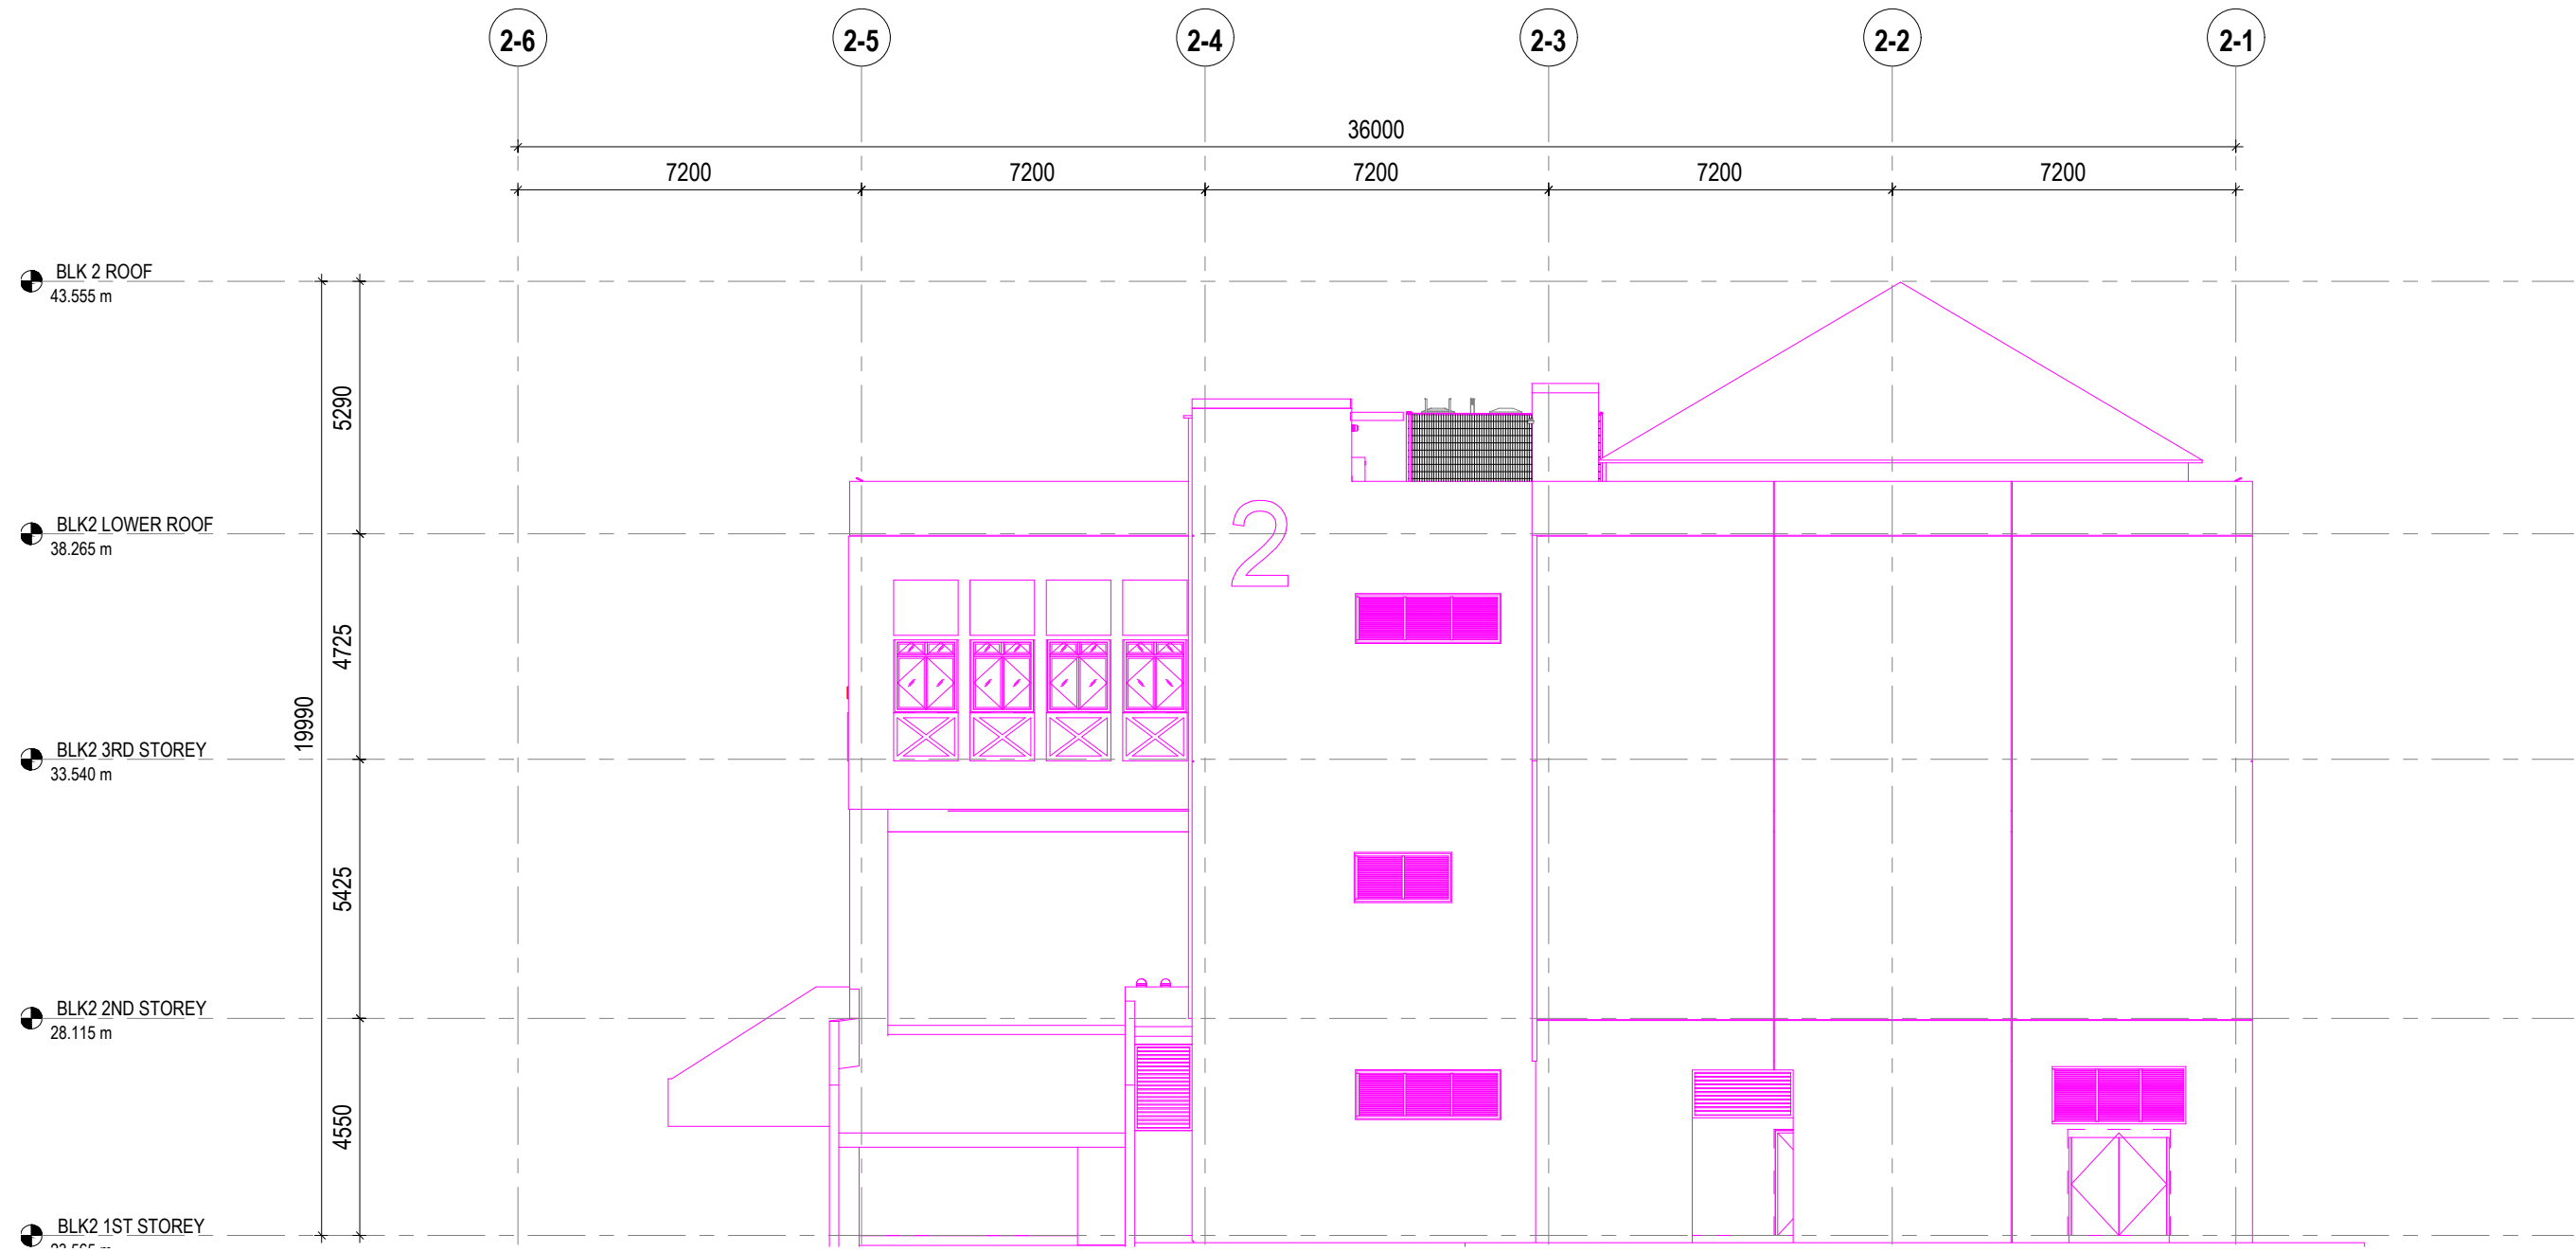

1 ELEVATION 1  
1 : 150

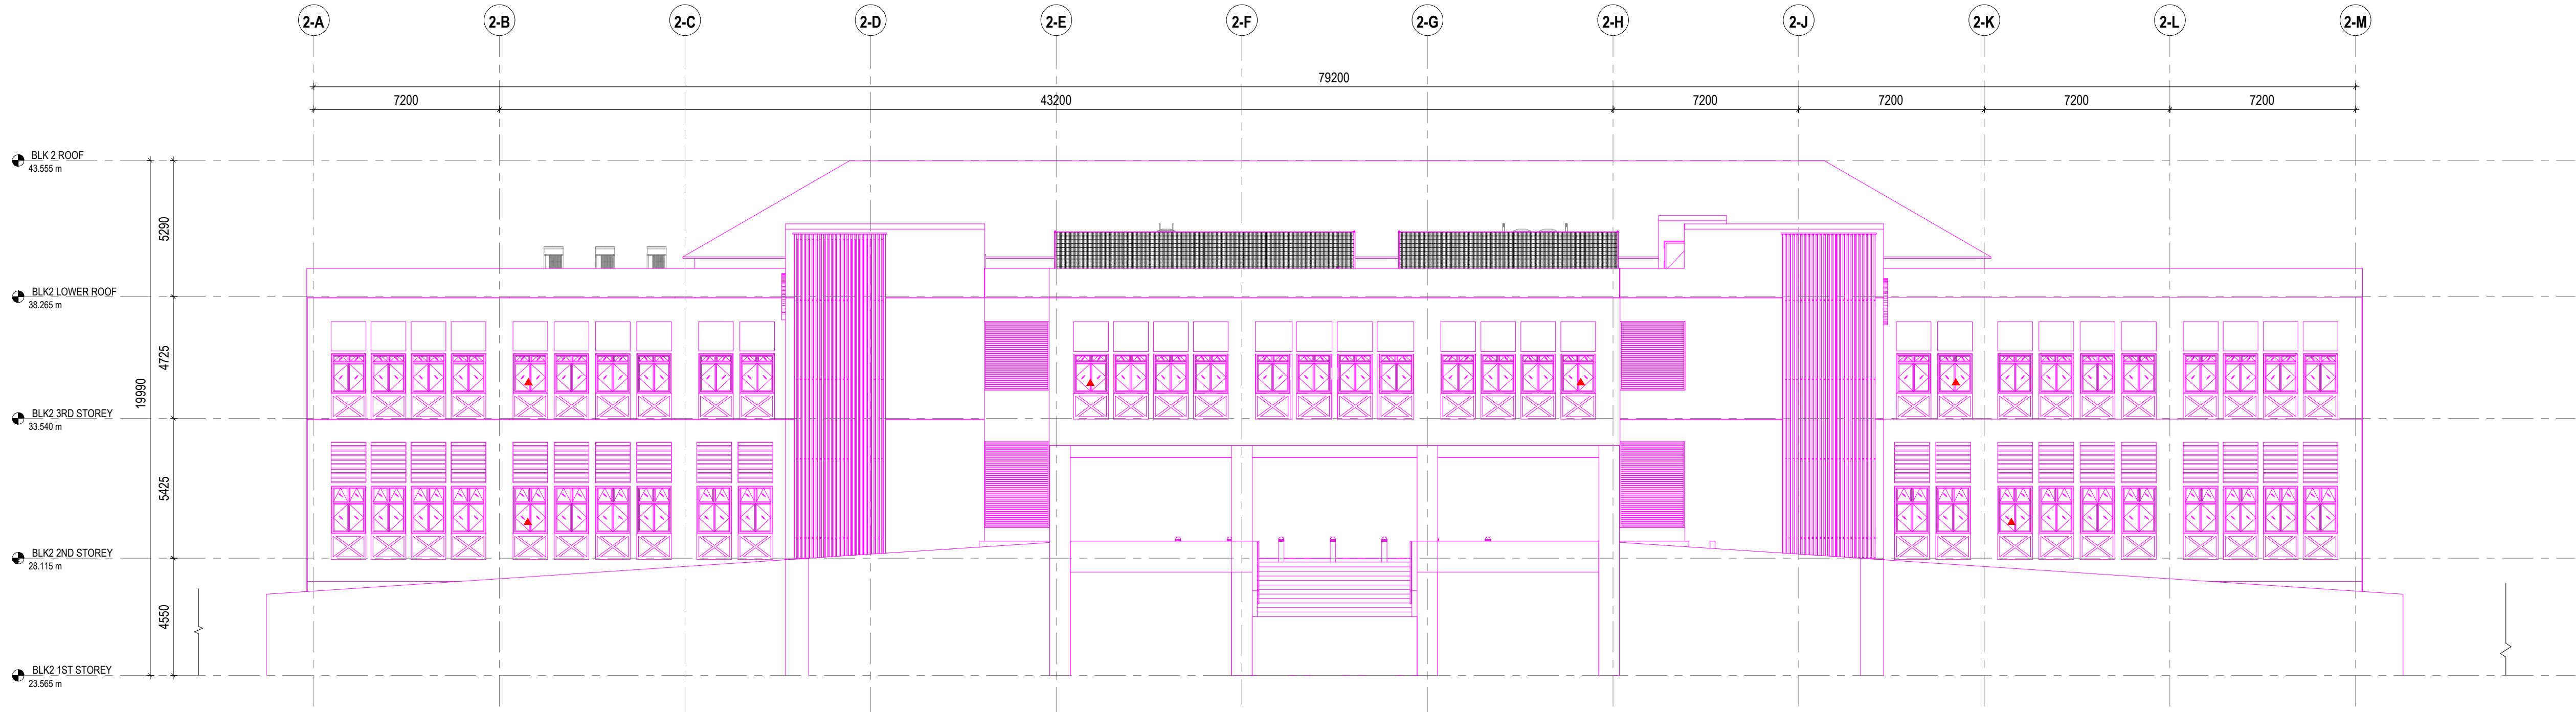

2 ELEVATION 2  
1 : 150

AS-BUILT DRAWING

Project Ref. No. : A2105-00599-2022



PEH SEOH CHIN  
WCD (Army Corps)

EDMUND TEO KUAN WEI  
Senior Programme Manager

DAB Main Contractor:

**DEENN ENGINEERING PTE LTD**  
29 Harrison Road, Lian Beng Building, Singapore 369648  
TEL No. 6283 1468 FAX No. 6280 9360  
e-mail : lianbengconstrn@pacific.net.sg  
Website: www.lianbeng.com.sg

Architect:  
**ID ARCHITECTS PTE LTD**  
3 HarbourFront Place, #03-01,  
HarbourFront Tower Two,  
Singapore 099254  
Tel 6225 6011  
Fax 6225 6022  
general@idarchitects.com.sg  
www.idarchitects.com.sg



Structure:  
**TW-ASIA Consultants Pte Ltd**  
No.28 Sin Ming Lane #04-137 Midview City  
Singapore 573972  
Tel : 62916292 Fax: 62932196

MAE Consultant:  
**PdcConsultants Pte Ltd**  
23 New Industrial Road #06-03  
Solstice Business Center  
Singapore 536209  
t: 6444 7748 f: 6444 7141  
e: contact@pdcengrs.com

Sub Contractor:


Project No.:  
D2019-00162

Project Title:  
PROPOSED ADDITIONS OF 1 BLOCK OF 3-STOREY OFFICE BUILDING BLK 2, 1 BLOCK OF 6-STOREY ACCOMMODATION BUILDING BLK 3 (11), 1 BLOCK OF 4-STOREY ACCOMMODATION BUILDING BLK 4 (10), 1 BLOCK OF 2-STOREY TRAINING MULTIPLEX BLK 9 (6), 1 BLOCK OF MSVS BLK 10 (9), AND ANCILLARY FACILITIES BLK 5, 6(4) & 8 TO EXISTING DIEPPE BARRACK ON LOT 05019M MK13 AT SEMBAWANG ROAD (MANDAI PLANNING AREA)

Drawing title:  
Block 2  
ELEVATION 1 & 2

Drawn	Initial	Date	Scale	1:150
Checked	RONY	15/01/2025	Software	
Drawing no.:	D2019-00162/			Revision no.: -

THIS DRAWING IS THE PROPERTY OF DSTA. IF FOUND, PLEASE RETURN TO DSTA BUILDING AND INFRASTRUCTURE PROGRAMME CENTRE, 1 DEPOT ROAD, SINGAPORE 109679. REPRODUCTION OF DRAWING WITHOUT THE WRITTEN PERMISSION OF DSTA IS STRICTLY PROHIBITED. ANY UNAUTHORIZED REPRODUCTION OR POSSESSION SHALL BE DEALT WITH UNDER THE OFFICIAL SECRETS ACT.

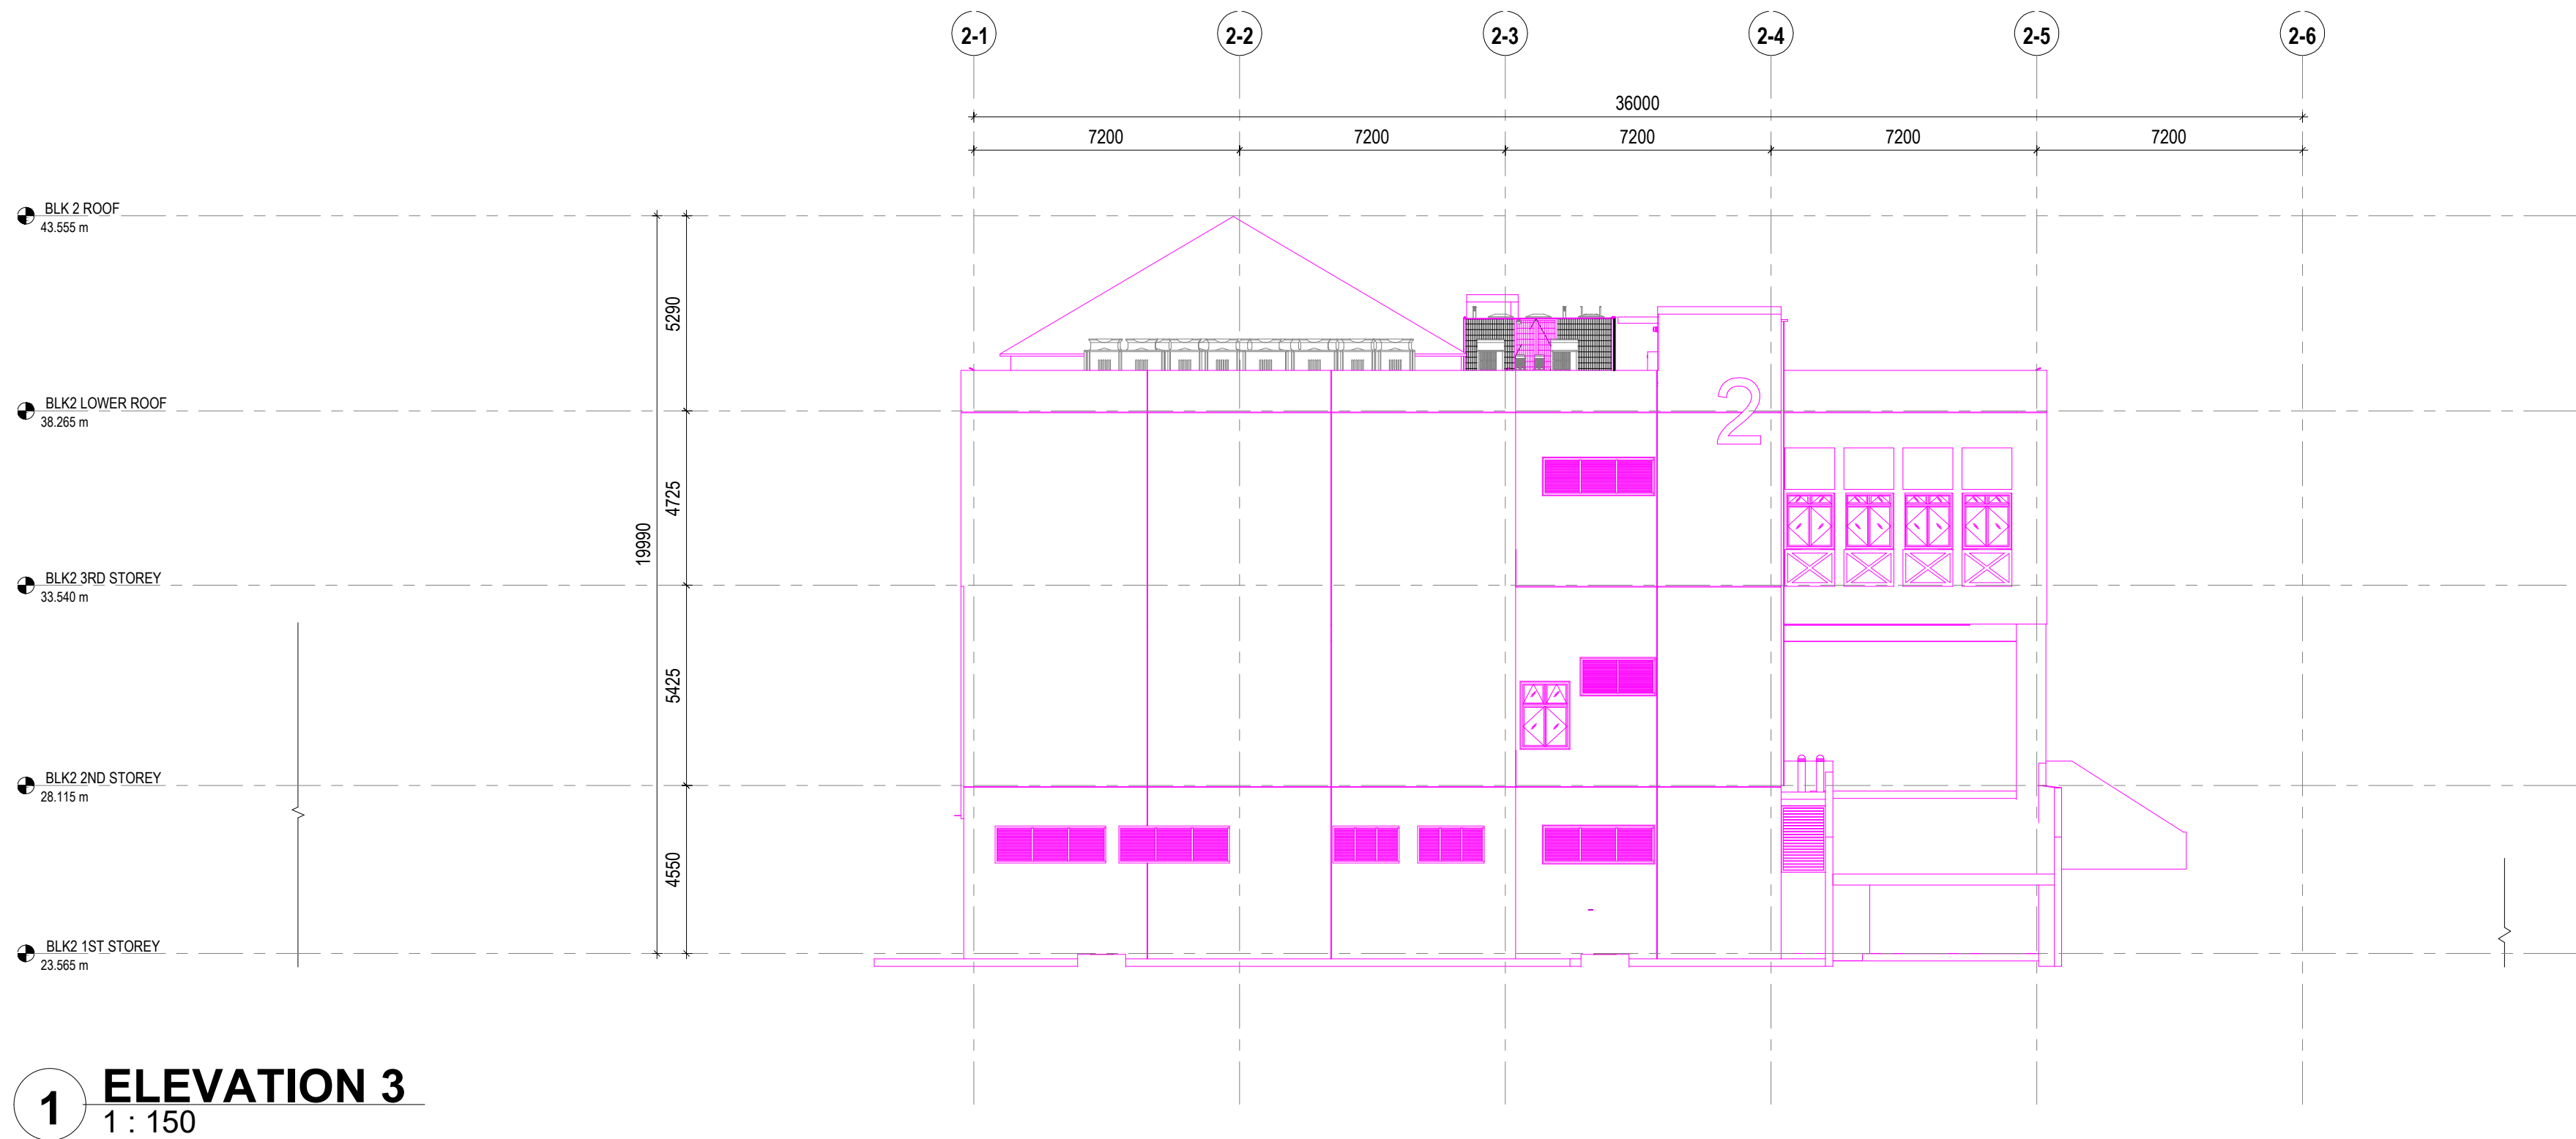

PEH SEOH CHIN  
MCD (Army Corps)

EDMUND TEO KUAN WEI  
Senior Programme Manager

DAB Main Contractor:

**DEENN ENGINEERING PTE LTD**  
29 Harrison Road, Lian Beng Building, Singapore 369648  
TEL No. 6283 1468 FAX No. 6280 9360  
e-mail : lianbengconstrn@pacific.net.sg  
Website: www.lianbeng.com.sg

Architect:

**ID ARCHITECTS PTE LTD**  
3 HarbourFront Place, #03-01,  
HarbourFront Tower Two,  
Singapore 099254  
Tel 6225 6011  
Fax 6225 6022  
general@idarchitects.com.sg  
www.idarchitects.com.sg

**ida**

Structure:

**TW-ASIA Consultants Pte Ltd**  
No.28 Sin Ming Lane #04-137 Midview City  
Singapore 573972  
Tel : 62916292 Fax: 62932196

MAE Consultant:

**PdcConsultants Pte Ltd**  
ELECTRICAL  
23 New Industrial Road #06-03  
Solstice Business Center  
Singapore 536209  
t: 6444 7748 f: 6444 7141  
e: contact@pdcengrs.com

Sub Contractor:

Project No.:  
D2019-00162

Project Title:  
PROPOSED ADDITIONS OF 1 BLOCK OF 3-STOREY OFFICE BUILDING BLK 2, 1 BLOCK OF 6-STOREY ACCOMMODATION BUILDING BLK 3 (11), 1 BLOCK OF 4-STOREY ACCOMMODATION BUILDING BLK 4 (10), 1 BLOCK OF 2-STOREY TRAINING MULTIPLEX BLK 9 (6), 1 BLOCK OF MSVS BLK 10 (9), AND ANCILLARY FACILITIES BLK 5, 6(4) & 8 TO EXISTING DIEPPE BARRACK ON LOT 05019M MK13 AT SEMBAWANG ROAD (MANDAI PLANNING AREA)

Drawing title:  
Block 2  
ELEVATION 3 & 4

Drawn	Initial	Date	Scale
SM/JV		15/01/2025	1:150
Checked	Initial	Date	Software
RONY		15/01/2025	
Drawing no.:	Revision no.:		
D2019-00162/	-		

THIS DRAWING IS THE PROPERTY OF DSTA. IF FOUND, PLEASE RETURN TO DSTA BUILDING AND INFRASTRUCTURE PROGRAMME CENTRE, 1 DEPOT ROAD, SINGAPORE 109679. REPRODUCTION OF DRAWING WITHOUT THE WRITTEN PERMISSION OF DSTA IS STRICTLY PROHIBITED. ANY UNAUTHORIZED REPRODUCTION OR POSSESSION SHALL BE DEALT WITH UNDER THE OFFICIAL SECRETS ACT.





PEH SEOH CHIN  
MCD (Army Corps)

EDMUND TEO KUAN WEI  
Senior Programme Manager

DAB Main Contractor:

**DEENN ENGINEERING PTE LTD**  
29 Harrison Road, Lian Beng Building, Singapore 369648  
TEL No.6283 1468 FAX No. 6280 9360  
e-mail : lianbengconstrn@pacific.net.sg  
Website: www.lianbeng.com.sg

Architect:

**ID ARCHITECTS PTE LTD**  
3 HarbourFront Place, #03-01,  
HarbourFront Tower Two,  
Singapore 099254  
Tel 6225 6011  
Fax 6225 6022  
general@idarchitects.com.sg  
www.idarchitects.com.sg

Structure:

**TW-ASIA Consultants Pte Ltd**  
No.28 Sin Ming Lane #04-137 Midview City  
Singapore 573972  
Tel : 62916292 Fax: 62932196

MAE Consultant:

**Pdc Consultants Pte Ltd**  
MECHANICAL ELECTRICAL  
23 New Industrial Road #06-03  
Solstice Business Center  
Singapore 536209  
t : 6444 7748 f: 6444 7141  
e: contact@pdcengrs.com

Sub Contractor:

Project No.:  
D2019-00162


Project Title:

PROPOSED ADDITIONS OF 1 BLOCK OF 3-STOREY OFFICE BUILDING BLK 2, 1 BLOCK OF 6-STOREY ACCOMMODATION BUILDING BLK 3 (11), 1 BLOCK OF 4-STOREY ACCOMMODATION BUILDING BLK 4 (10), 1 BLOCK OF 2-STOREY TRAINING MULTIPLEX BLK 9 (6), 1 BLOCK OF MSVS BLK 10 (9), AND ANCILLARY FACILITIES BLK 5, 6(4) & 8 TO EXISTING DIEPPE BARRACK ON LOT 05019M MK13 AT SEMBAWANG ROAD (MANDAI PLANNING AREA)


Drawing title:  
Block 2  
SECTION 1 & 2

	Initial	Date	Scale	
Drawn	SM/JV	15/01/2025	Scale	1:150
Checked	RONY	15/01/2025	Software	
Drawing no.:	D2019-00162/			Revision no.:
				-

THIS DRAWING IS THE PROPERTY OF DSTA. IF FOUND, PLEASE RETURN TO DSTA BUILDING AND INFRASTRUCTURE PROGRAMME CENTRE, 1 DEPOT ROAD, SINGAPORE 109679. REPRODUCTION OF DRAWING WITHOUT THE WRITTEN PERMISSION OF DSTA IS STRICTLY PROHIBITED. ANY UNAUTHORIZED REPRODUCTION OR POSSESSION SHALL BE DEALT WITH UNDER THE OFFICIAL SECRETS ACT.

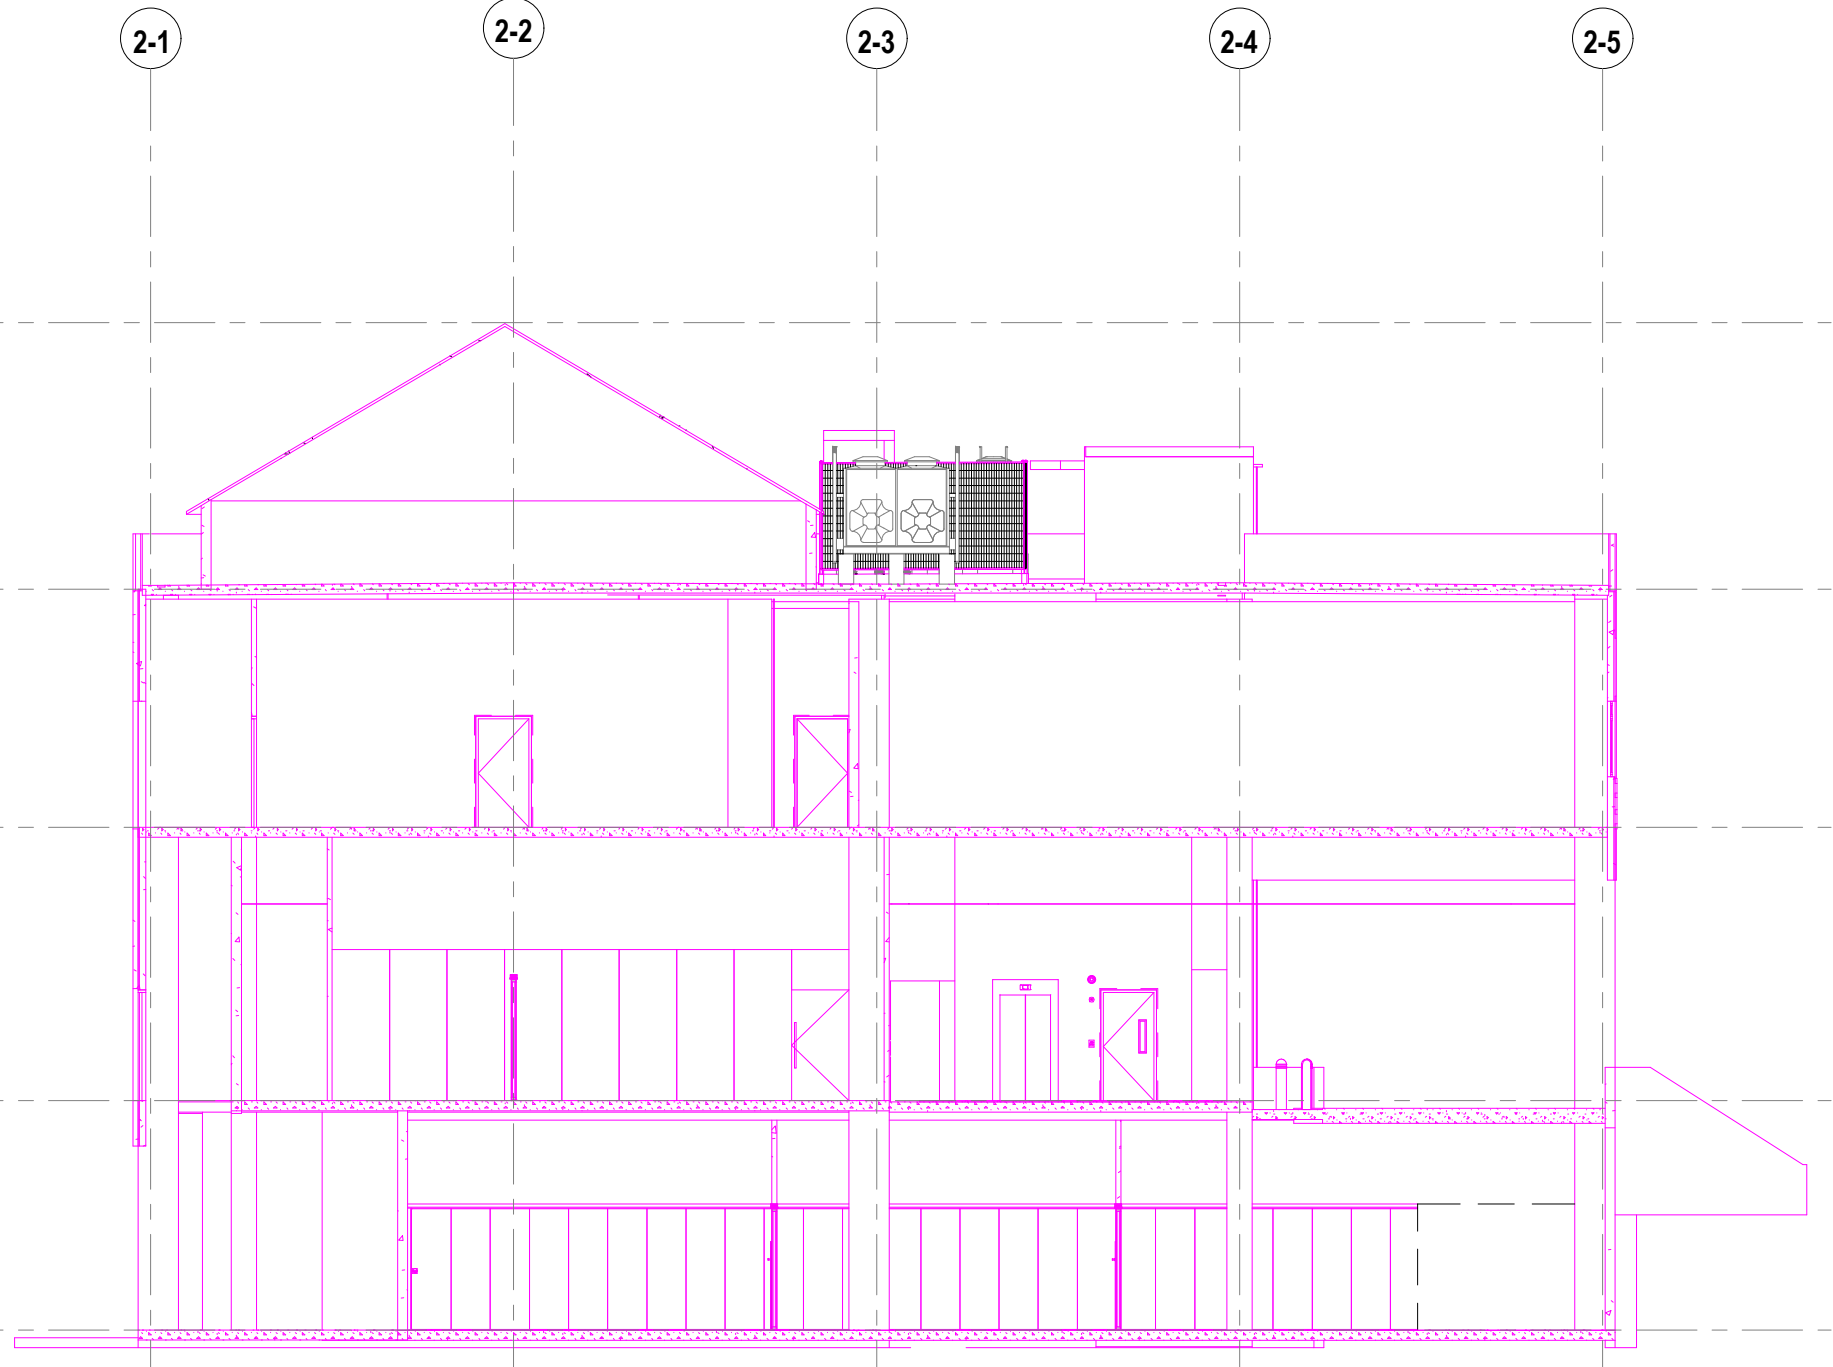

1 Section 1  
1 : 150

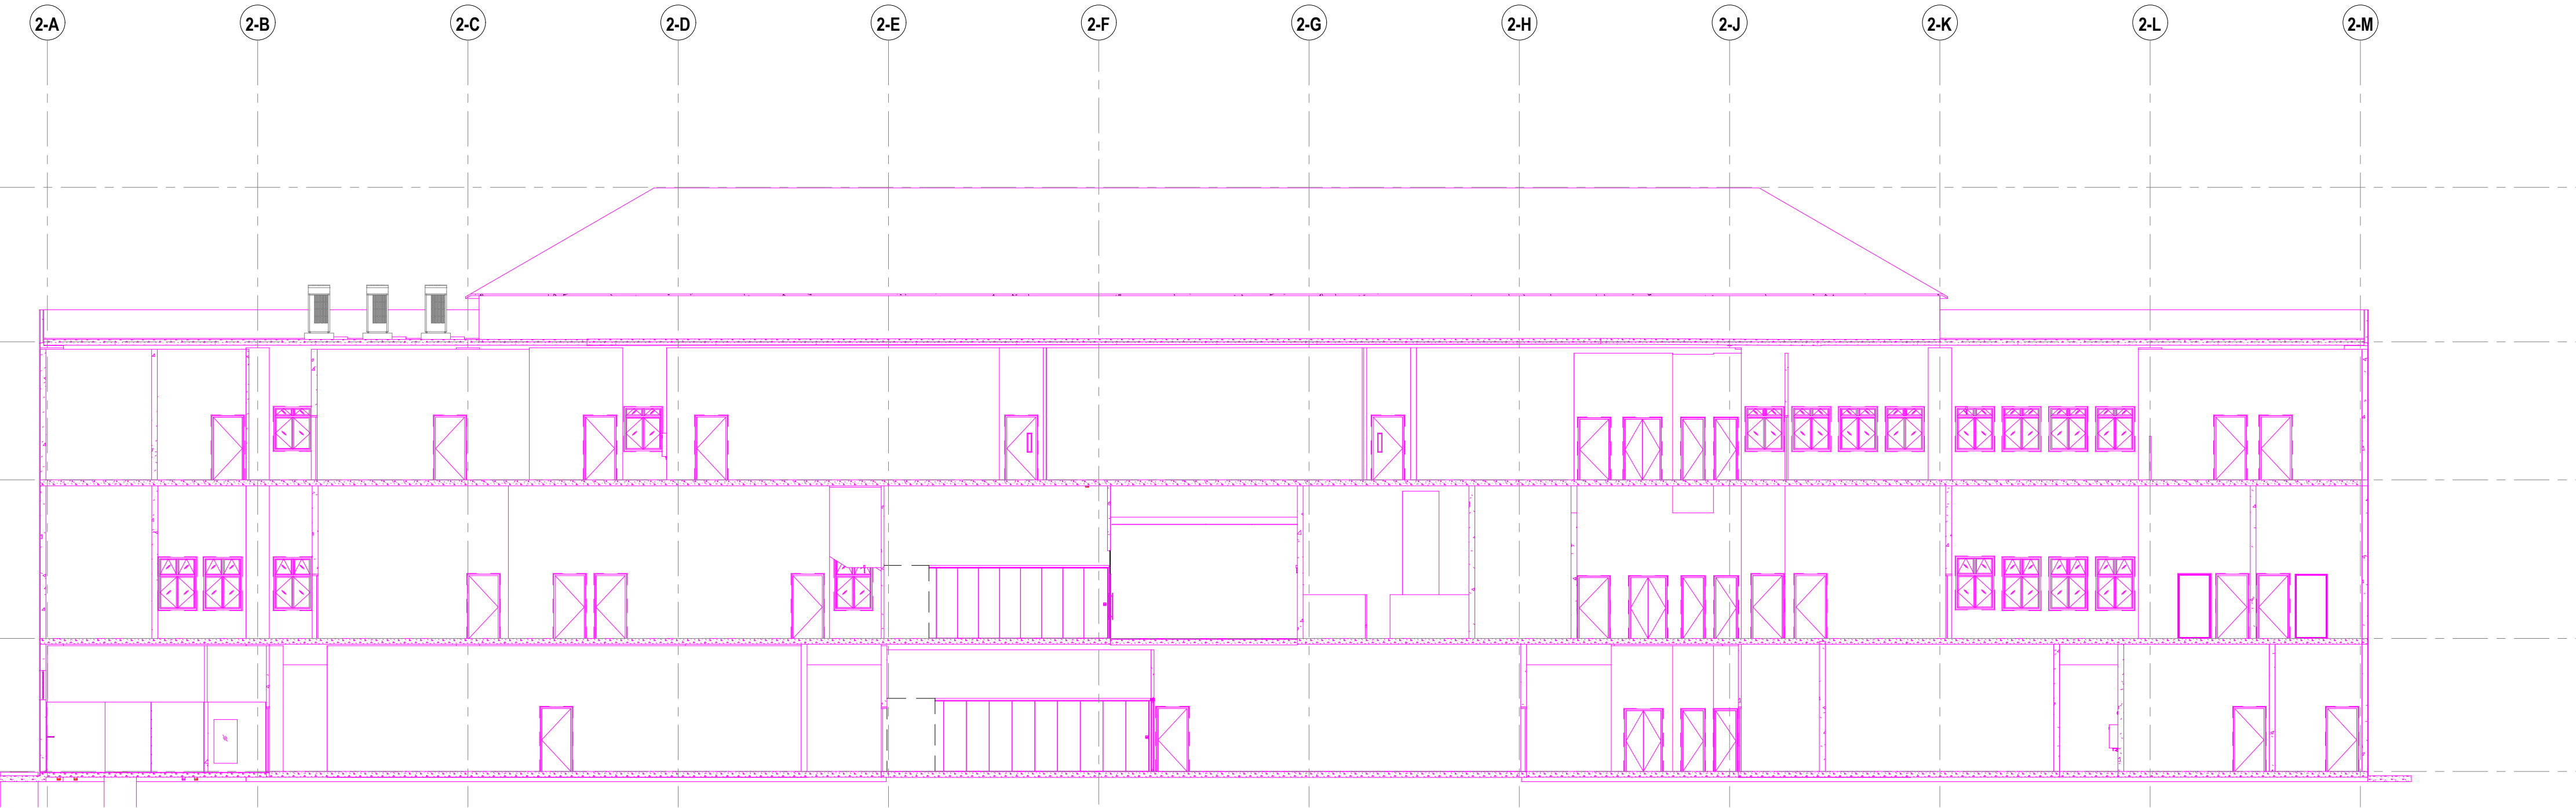

2 Section 2  
1 : 150