



BLK 2 - LEVEL 2 TRAINING ROOM 02-03


SCALE 1:100

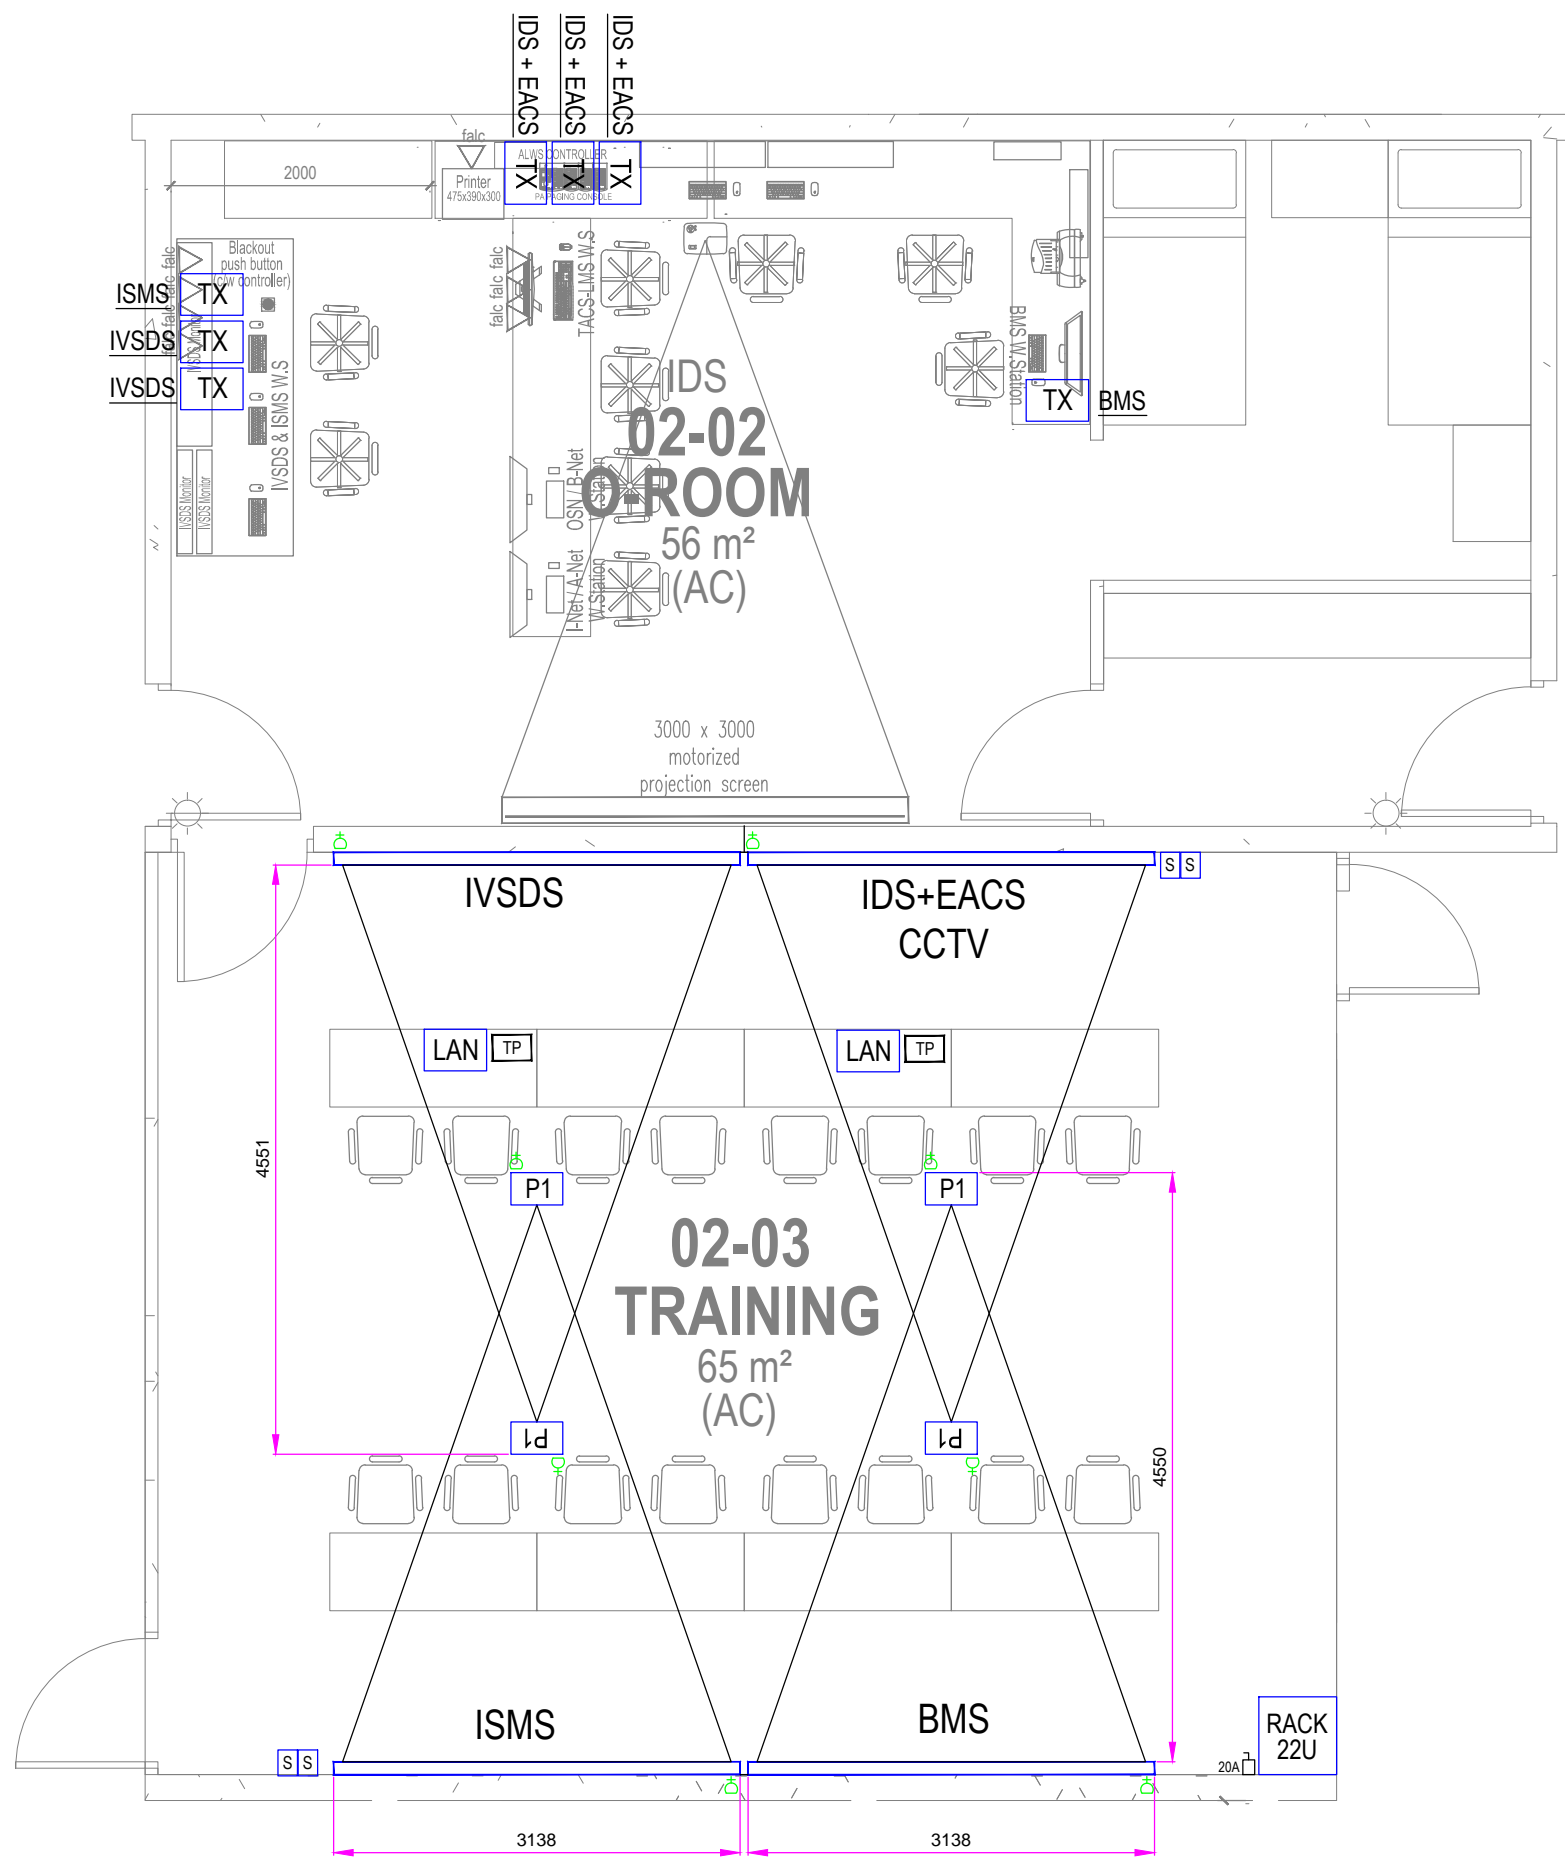


FOR ISMS

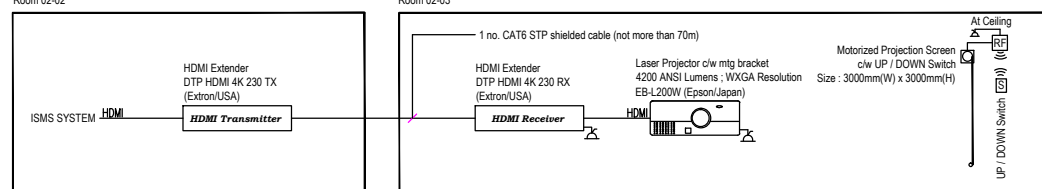


FOR BMS

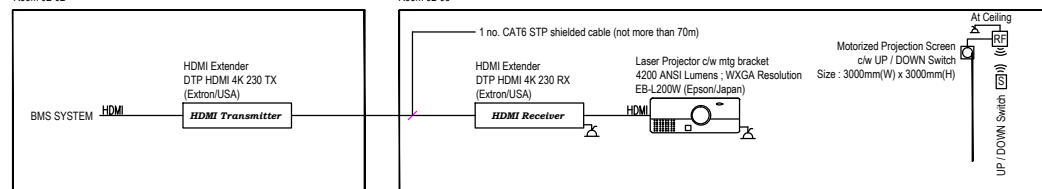

FOR IVSDS

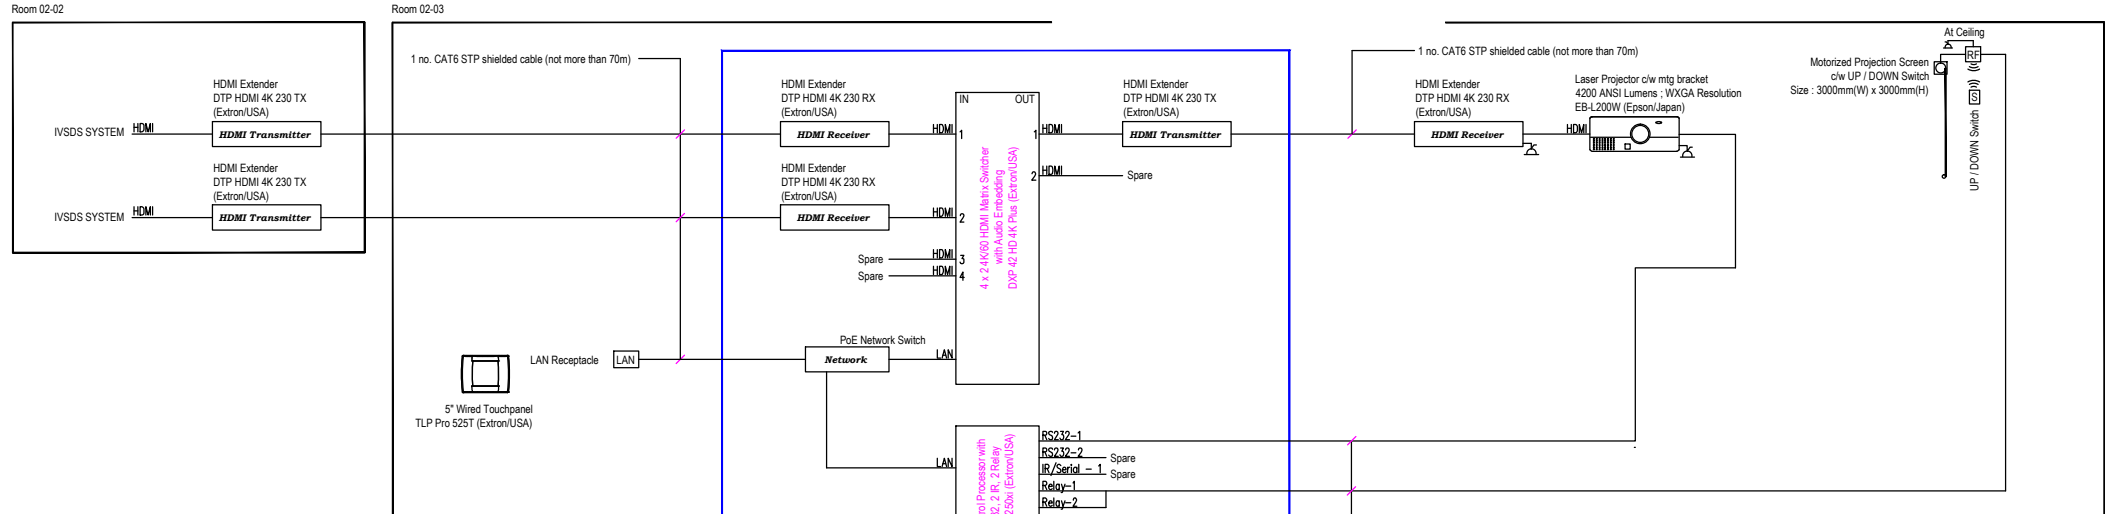

FOR IDS+EACS CCTV

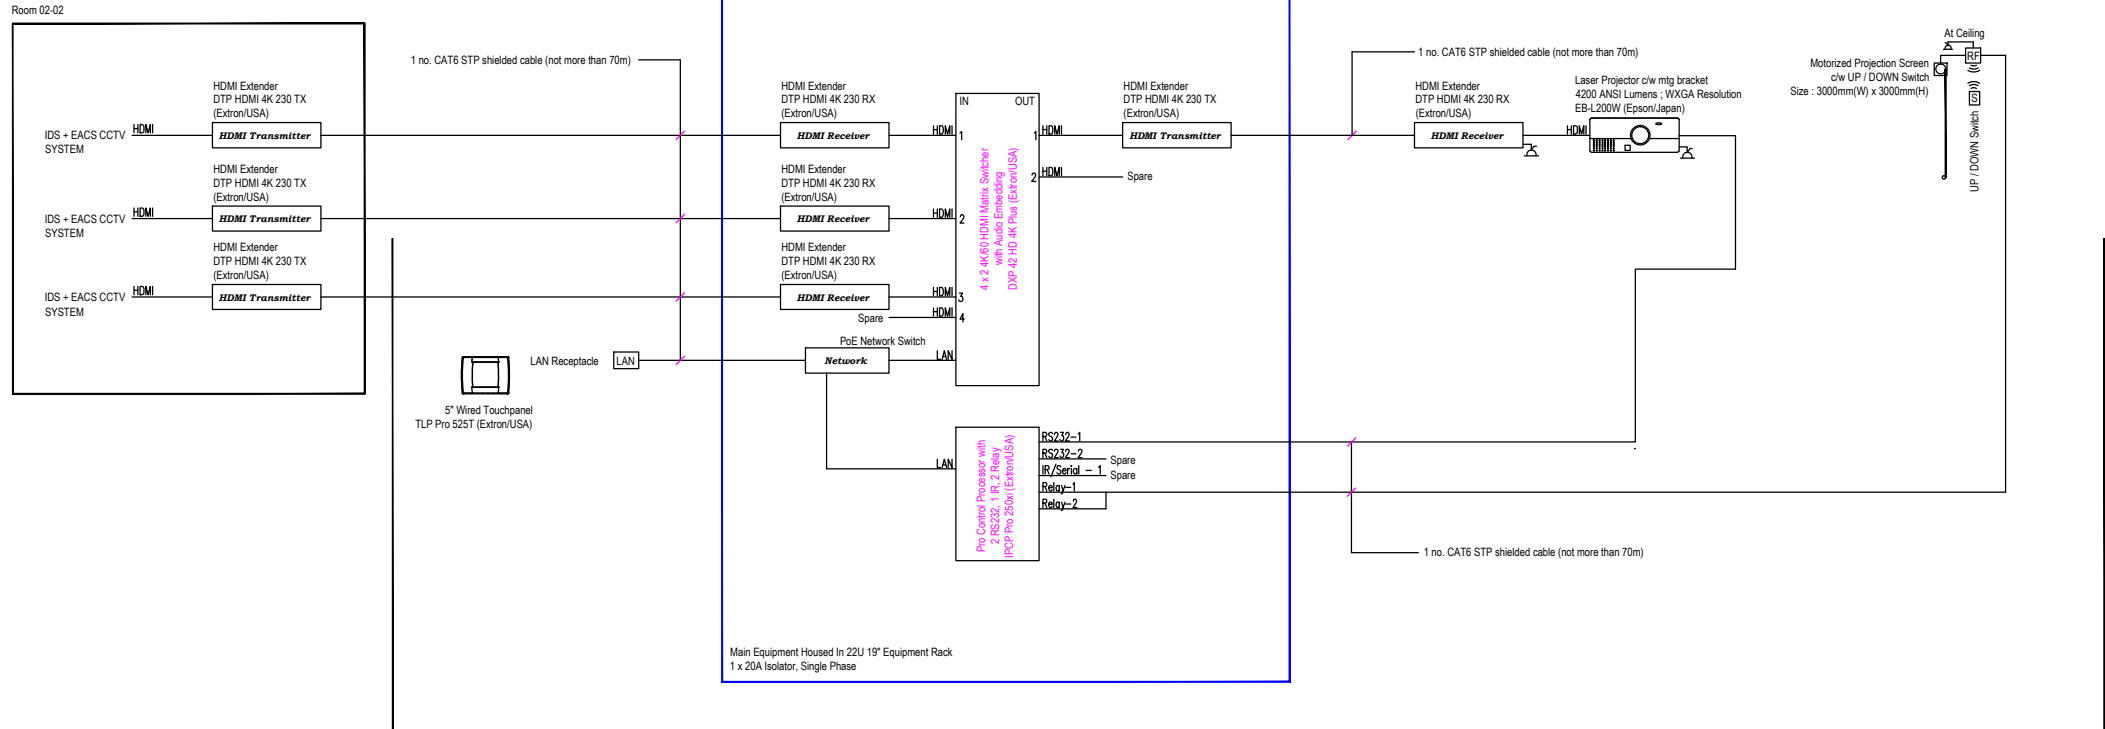

LEGEND & SYMBOL

	LASER PROJECTOR C/W MTG BRACKET 4200 ANSI LUMENS ; WXGA RESOLUTION EB-L200W (EPSON/JAPAN) DIM : 325(W) x 90(H) x 299(D)mm
	MOTORISED SCREEN - 3000(W) X 3000(H) IMAGE SIZE : 3000(W) X 1685(H), 16:9 CLASS 10 (LAV/SINGAPORE) CASING DIM : 3138(W) x 156(H) x 134(D)mm
	5\"/>
	TWO INPUT DTP TRANSMITTER FOR HDMI & VGA DTP T UWP 4K 230 D (EXTRON/USA) DIM : 89(W) x 107(H) x 48(D)mm
	LAN RECEPTACLE SINGLE GANG SIZE
	UP/DOWN SWITCH SINGLE GANG SIZE
	DTP RECEIVER FOR HDMI DTP HDMI 4K 230 RX (EXTRON/USA) DIM : 109(W) x 25(H) x 152(D)mm
	DTP TRANSMITTER FOR HDMI DTP HDMI 4K 230 TX (EXTRON/USA) DIM : 109(W) x 25(H) x 76(D)mm
	19\"/>
	13A 1-GANG SWITCH SOCKET OUTLET
	20A ISOLATOR

AUDIO VISUAL SYSTEM

BLK 2 - LEVEL 2 TRAINING ROOM 02-03

AS BUILT DRAWING

DEVELOPER:



YVYNN PEH SEOH  
CHIN

HCD (Army Camps)

Edmund Teo  
Kuan Wei

Senior Programme Manager

Project No.:  
D2019-00162

D&B MAIN CONTRACTOR:

**DEENN ENGINEERING PTE LTD**  
29 Harrison Road, Lian Beng Building, Singapore 369648  
TEL. No. 6283 1468 FAX No. 6280 9360  
e-mail : lianbengconstn@pacific.net.sg  
Website: www.lianbeng.com.sg

ARCHITECT CONSULTANT:

**ID ARCHITECTS PTE LTD**  
3 Harbourfront Place, #03-01  
Harbourfront Tower Two  
Singapore 099254  
Tel: 6225 4011 Fax: 6225 4022  
Email: general@idarchitects.com.sg  
www.idarchitects.com.sg

STRUCTURE CONSULTANT:

TW-ASIA Consultants Pte Ltd

NO. 25, SUN MING LANE #04-137 MINDEN CITY  
SINGAPORE 573972 TEL : 62916292 FAX : 62932195

M&E Consultant:

**PdcConsultants Pte Ltd**  
MECHANICAL + ELECTRICAL  
23 New Industrial Road #06-03  
Solstice Business Center  
Singapore 536209  
t : 6444 7745 f: 6444 7141  
e: contact@pdcengrs.com

Sub Contractor:

CHIN SENG ENGINEERING (S) PTE LTD

33 Ubi Avenue 3, Vertex Tower B, #08-27, Singapore 408668  
TEL: 6742 9392 FAX: 6742 9390

Project Title:

PROPOSED ADDITIONS OF 1 BLOCK OF 3-STOREY OFFICE  
BUILDING BLK 2, 1 BLOCK OF 6-STOREY ACCOMMODATION  
BUILDING BLK 3 (11), 1 BLOCK OF 4-STOREY ACCOMMODATION  
BUILDING BLK 4 (10), 1 BLOCK OF 2-STOREY TRAINING  
MULTIPLEX BLK 9 (6), 1 BLOCK OF MSVS BLK 10 (9),  
AND ANCILLARY FACILITIES BLK 5, 6(4) & 8 TO EXISTING DIEPPE  
BARRACK ON LOT 05019M MK13 AT SEMBAWANG ROAD (MANDAI  
PLANNING AREA)

Drawing Title:

AUDIO VISUAL SYSTEM  
BLOCK 2 - LEVEL 2 TRAINING ROOM 02-03

	Initial	Date	Job ref no.
Designed	JEFFREY	08/09/2023	
Checked	JEFFREY	08/09/2023	
Drawn	KHANG	08/09/2023	Filename
Software	CAD		
Scale	1:300	Sources	
Drawing no.	D2019-00162/ELECT/BLK2/AV/04		

THIS DRAWING IS COPYRIGHT  
THIS DRAWING IS THE PROPERTY OF DSTA. IF FOUND, PLEASE RETURN TO  
DSTA BUILDING AND INFRASTRUCTURE PROGRAMME CENTRE,  
1 DEPOT ROAD, SINGAPORE 109679.  
REPRODUCTION OF DRAWING WITHOUT THE WRITTEN PERMISSION OF DSTA IS  
STRICTLY PROHIBITED. ANY UNAUTHORIZED REPRODUCTION OR POSSESSION  
SHALL BE DEALT WITH UNDER THE OFFICIAL SECRETS ACT.