


OFFICAL (CLOSED)

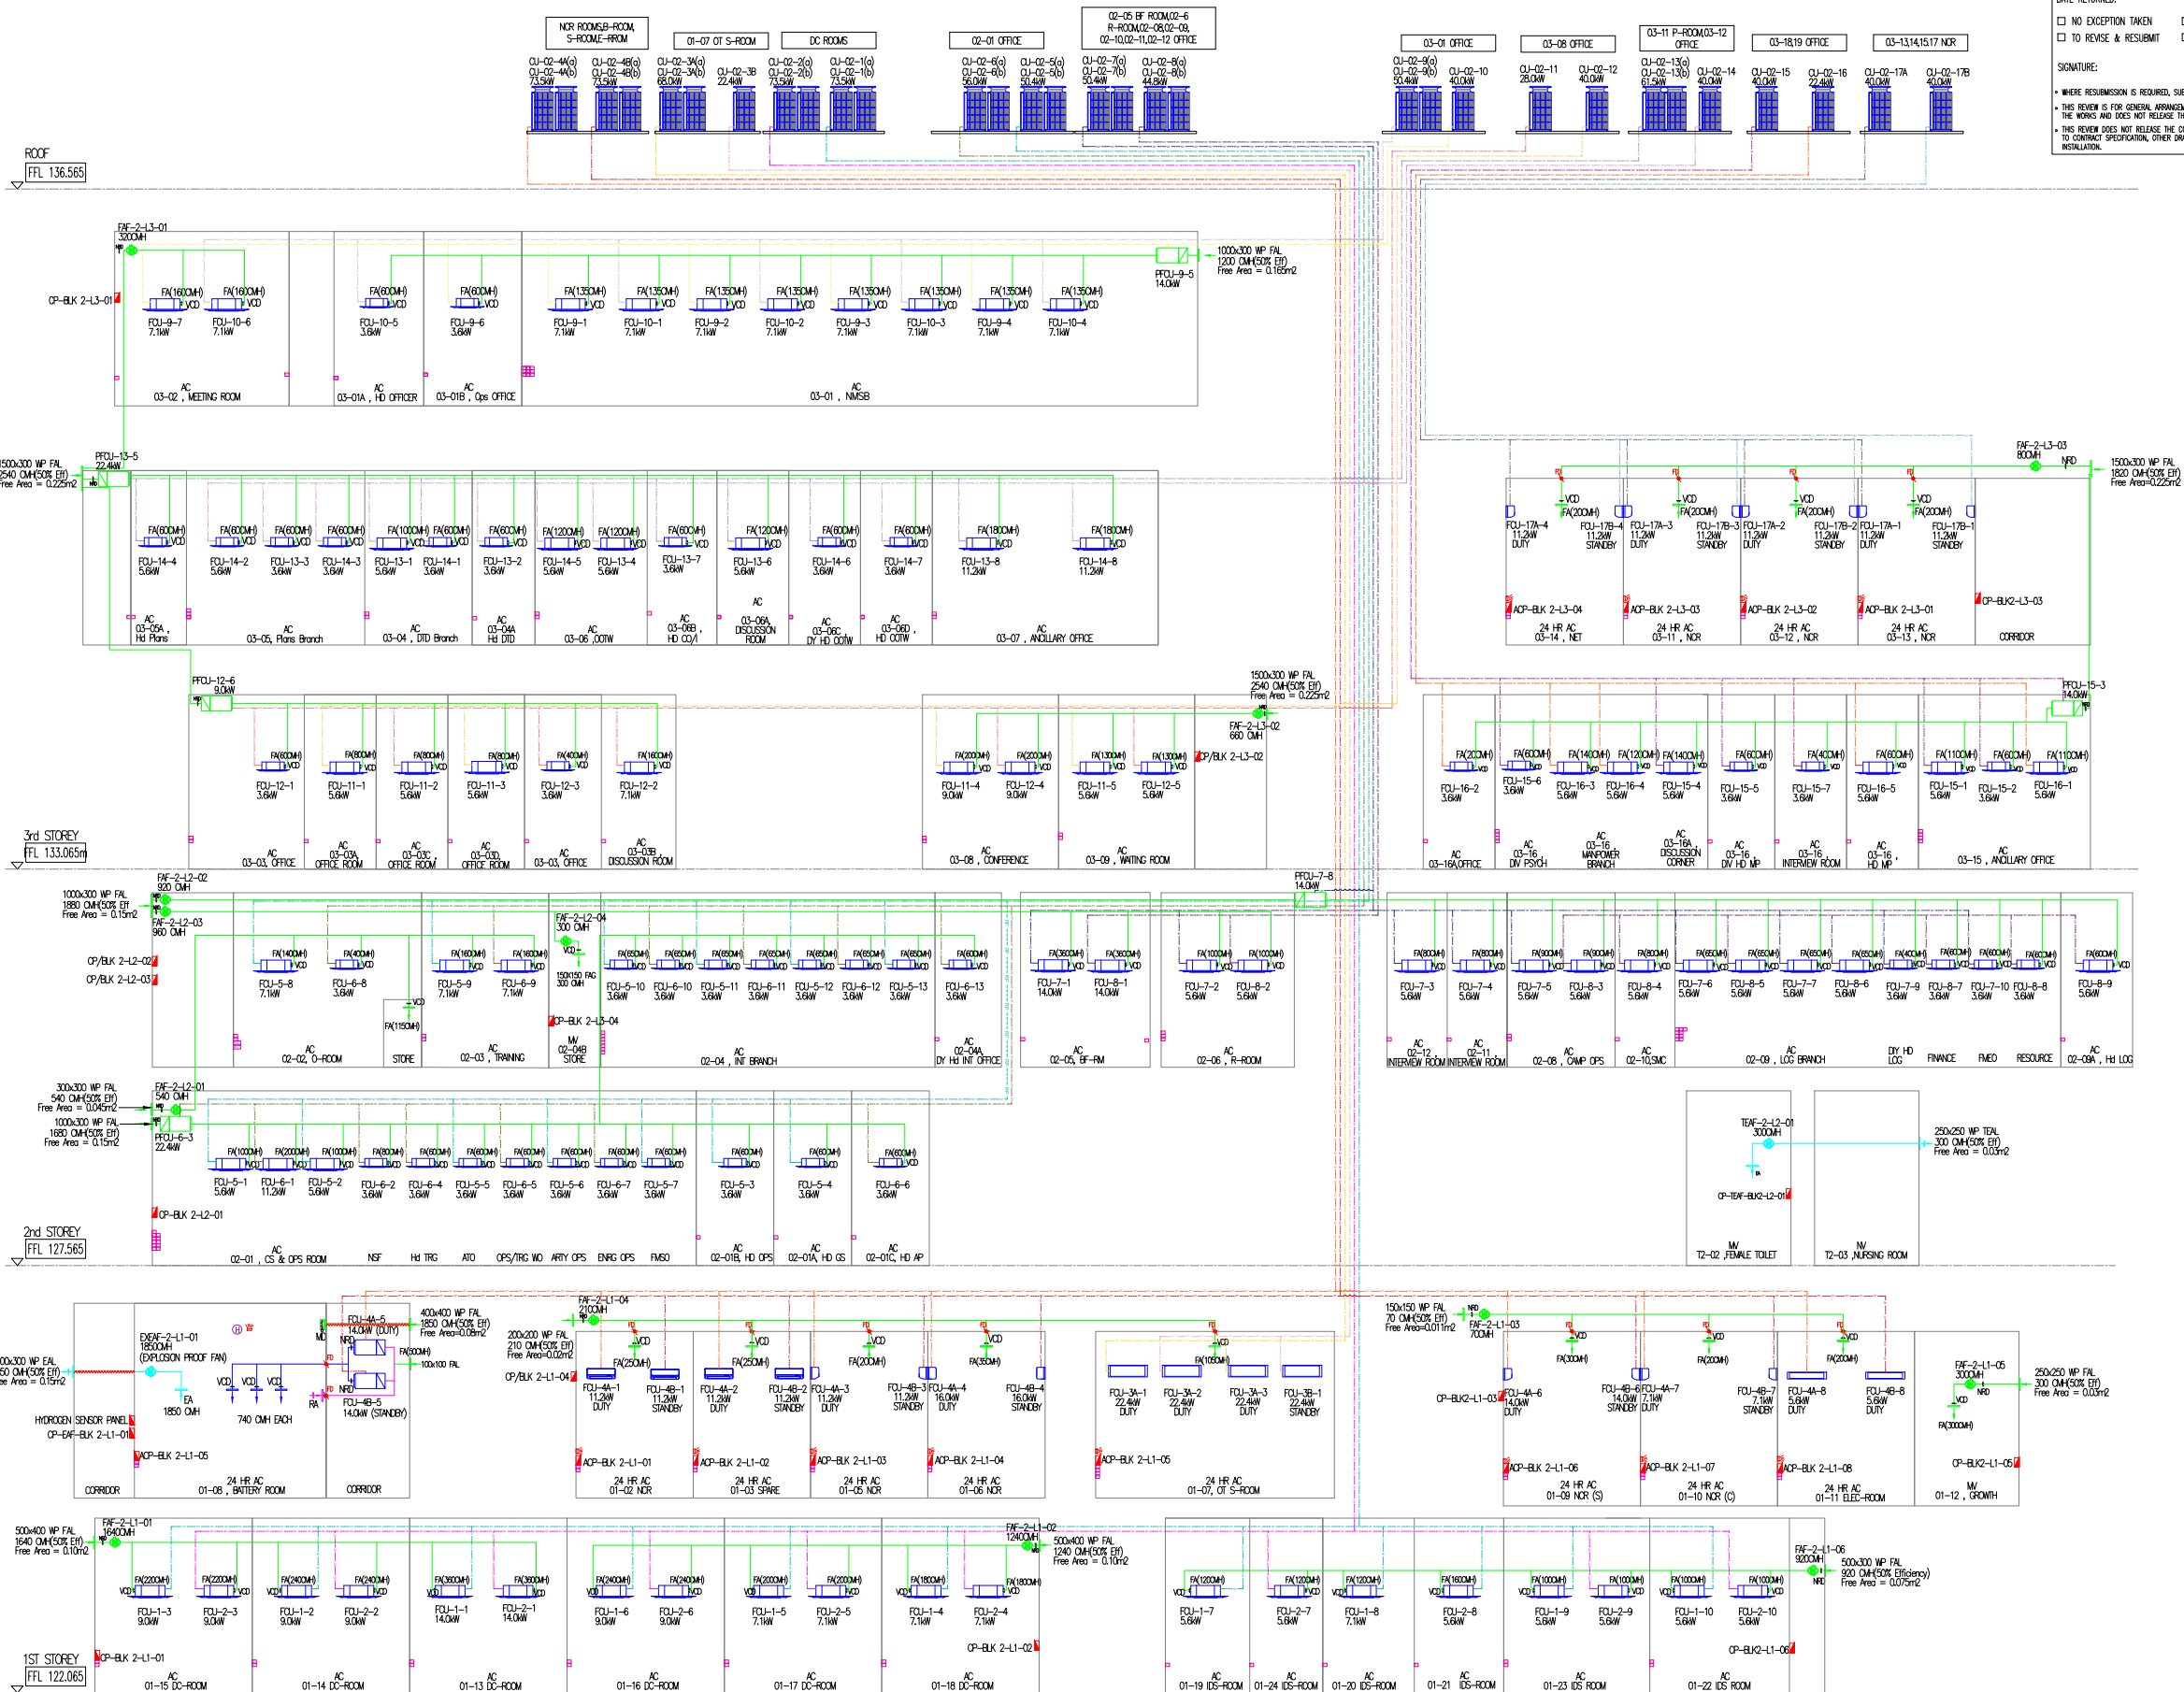

# ACMV SCHEMATIC DIAGRAM

OFFICAL (CLOSED)

M&E CONSULTANTS  
**Pdc Consultants Pte Ltd**  
23 NEW INDUSTRIAL ROAD #06-03  
SOLISTICE BUSINESS CENTRE SINGAPORE 536209  
TEL: 6444 7748  
FAX: 6444 7141

DATE RECEIVED: \_\_\_\_\_  
DATE RETURNED: \_\_\_\_\_  
RECEIVED BY: \_\_\_\_\_

☐ NO EXCEPTION TAKEN  
☐ MAKE CORRECTIONS NOTED PRIOR TO GENERAL USE  
☐ TO REVERSE & RESUBMIT  
☐ REJECTED & RESUBMIT

SIGNATURE: \_\_\_\_\_

• WHERE RESUBMISSION IS REQUIRED, SUBMIT REVISED DRAWINGS FOR REVIEW PRIOR TO PROCEEDING WITH WORK  
• THIS REVIEW IS FOR GENERAL ARRANGEMENT ONLY AND DOES NOT EXTEND TO DIMENSIONS OF SETTING OUT OF THE WORKS AND DOES NOT RELEASE THE CONTRACTOR OF HIS RESPONSIBILITIES TO ENSURE FULL COMPLIANCE  
• THIS REVIEW DOES NOT RELEASE THE CONTRACTOR OF HIS RESPONSIBILITIES TO ENSURE WORKS IN COMPLIANCE TO CONTRACT SPECIFICATION, OTHER DRAWINGS AND STATUTORY REQUIREMENT HAVING JURISDICTION OVER THE INSTALLATION.

AS-BUILT DRAWING  
Project Ref. No. : A2105-00599-2022

**DSTA**  
Defence Science & Technology Agency

PCB: SEOW CHIN  
H&D (Army Camps)

EDMUND TEO KUAN WEI  
Senior Programme Manager

D&B Main Contractor:  
**DEENN ENGINEERING PTE LTD**  
29 Harrison Road, Lian Beng Building, Singapore 369648  
TEL: No. 6283 1468 FAX: No. 6280 9360  
e-mail: lianbengconstn@pacific.net.sg  
Website: www.lianbeng.com.sg

Architect:  
**ID ARCHITECTS PTE LTD**  
3 HarbourFront Place, #03-01,  
HarbourFront Tower Two,  
Singapore 099254  
Tel: 6225 6011  
Fax: 6225 6022  
general@idarchitects.com.sg  
www.idarchitects.com.sg

Structure:  
**TW-ASIA Consultants Pte Ltd**  
NO. 28 SIN MING LANE #04-137 MIDVIEW CITY  
SINGAPORE 573972 TEL : 62916292 FAX : 62932196

M&E Consultant:  
**Pdc Consultants Pte Ltd**  
23 New Industrial Road #06-03  
Solstice Business Center  
Singapore 536209  
t: 6444 7748 f: 6444 7141  
e: contact@pdcengs.com

Sub Contractor:  
**INTAC SYSTEMS SOLUTION PTE LTD**  
BLOCK 1 KAO BUKIT AVENUE 3  
#04-03 K3-1, SINGAPORE 416087  
Tel: +65 6862 7318 Fax: +65 6862 7319  
Email: intac@intacsol.com.sg

Project No.:  
D2019-00162

Project Title:  
PROPOSED ADDITIONS OF 1 BLOCK OF 3-STOREY OFFICE BUILDING (BLK 2), 1 BLOCK OF 6-STOREY ACCOMMODATION BUILDING (BLK 3), 1 BLOCK OF 4-STOREY ACCOMMODATION BUILDING (BLK 4), 1 BLOCK OF 2-STOREY TRAINING MULTIPLEX (BLK 9), 1 BLOCK OF MSVS (BLK 10), AND ANCILLARY FACILITIES (BLK 5, 6 & 8) TO EXISTING DIEPPE BARRACK ON LOT 05019M MK13 AT SEMBAWANG ROAD (MANDAI PLANNING AREA)

Drawing Title:  
BLOCK 2 - ACMV SCHEMATIC DIAGRAM

Drawn	Initial	Date	Scale	NTS
Checked	MS	30/12/2024	Software	CAD

Drawing no.:  
D2019-00162/BLK 2/ACMV 09

Revision no.:  
00

THIS DRAWING IS COPYRIGHT  
THIS DRAWING IS THE PROPERTY OF DSTA. IF FOUND, PLEASE RETURN TO DSTA  
BUILDING AND INFRASTRUCTURE PROGRAMME CENTRE, 1 DEPOT ROAD,  
SINGAPORE 106679.  
REPRODUCTION OF DRAWING WITHOUT THE WRITTEN PERMISSION OF DSTA IS  
STRICTLY PROHIBITED. ANY UNAUTHORIZED REPRODUCTION OR POSSESSION  
SHALL BE DEALT WITH UNDER THE OFFICIAL SECRETS ACT.