


OFFICAL (CLOSED)

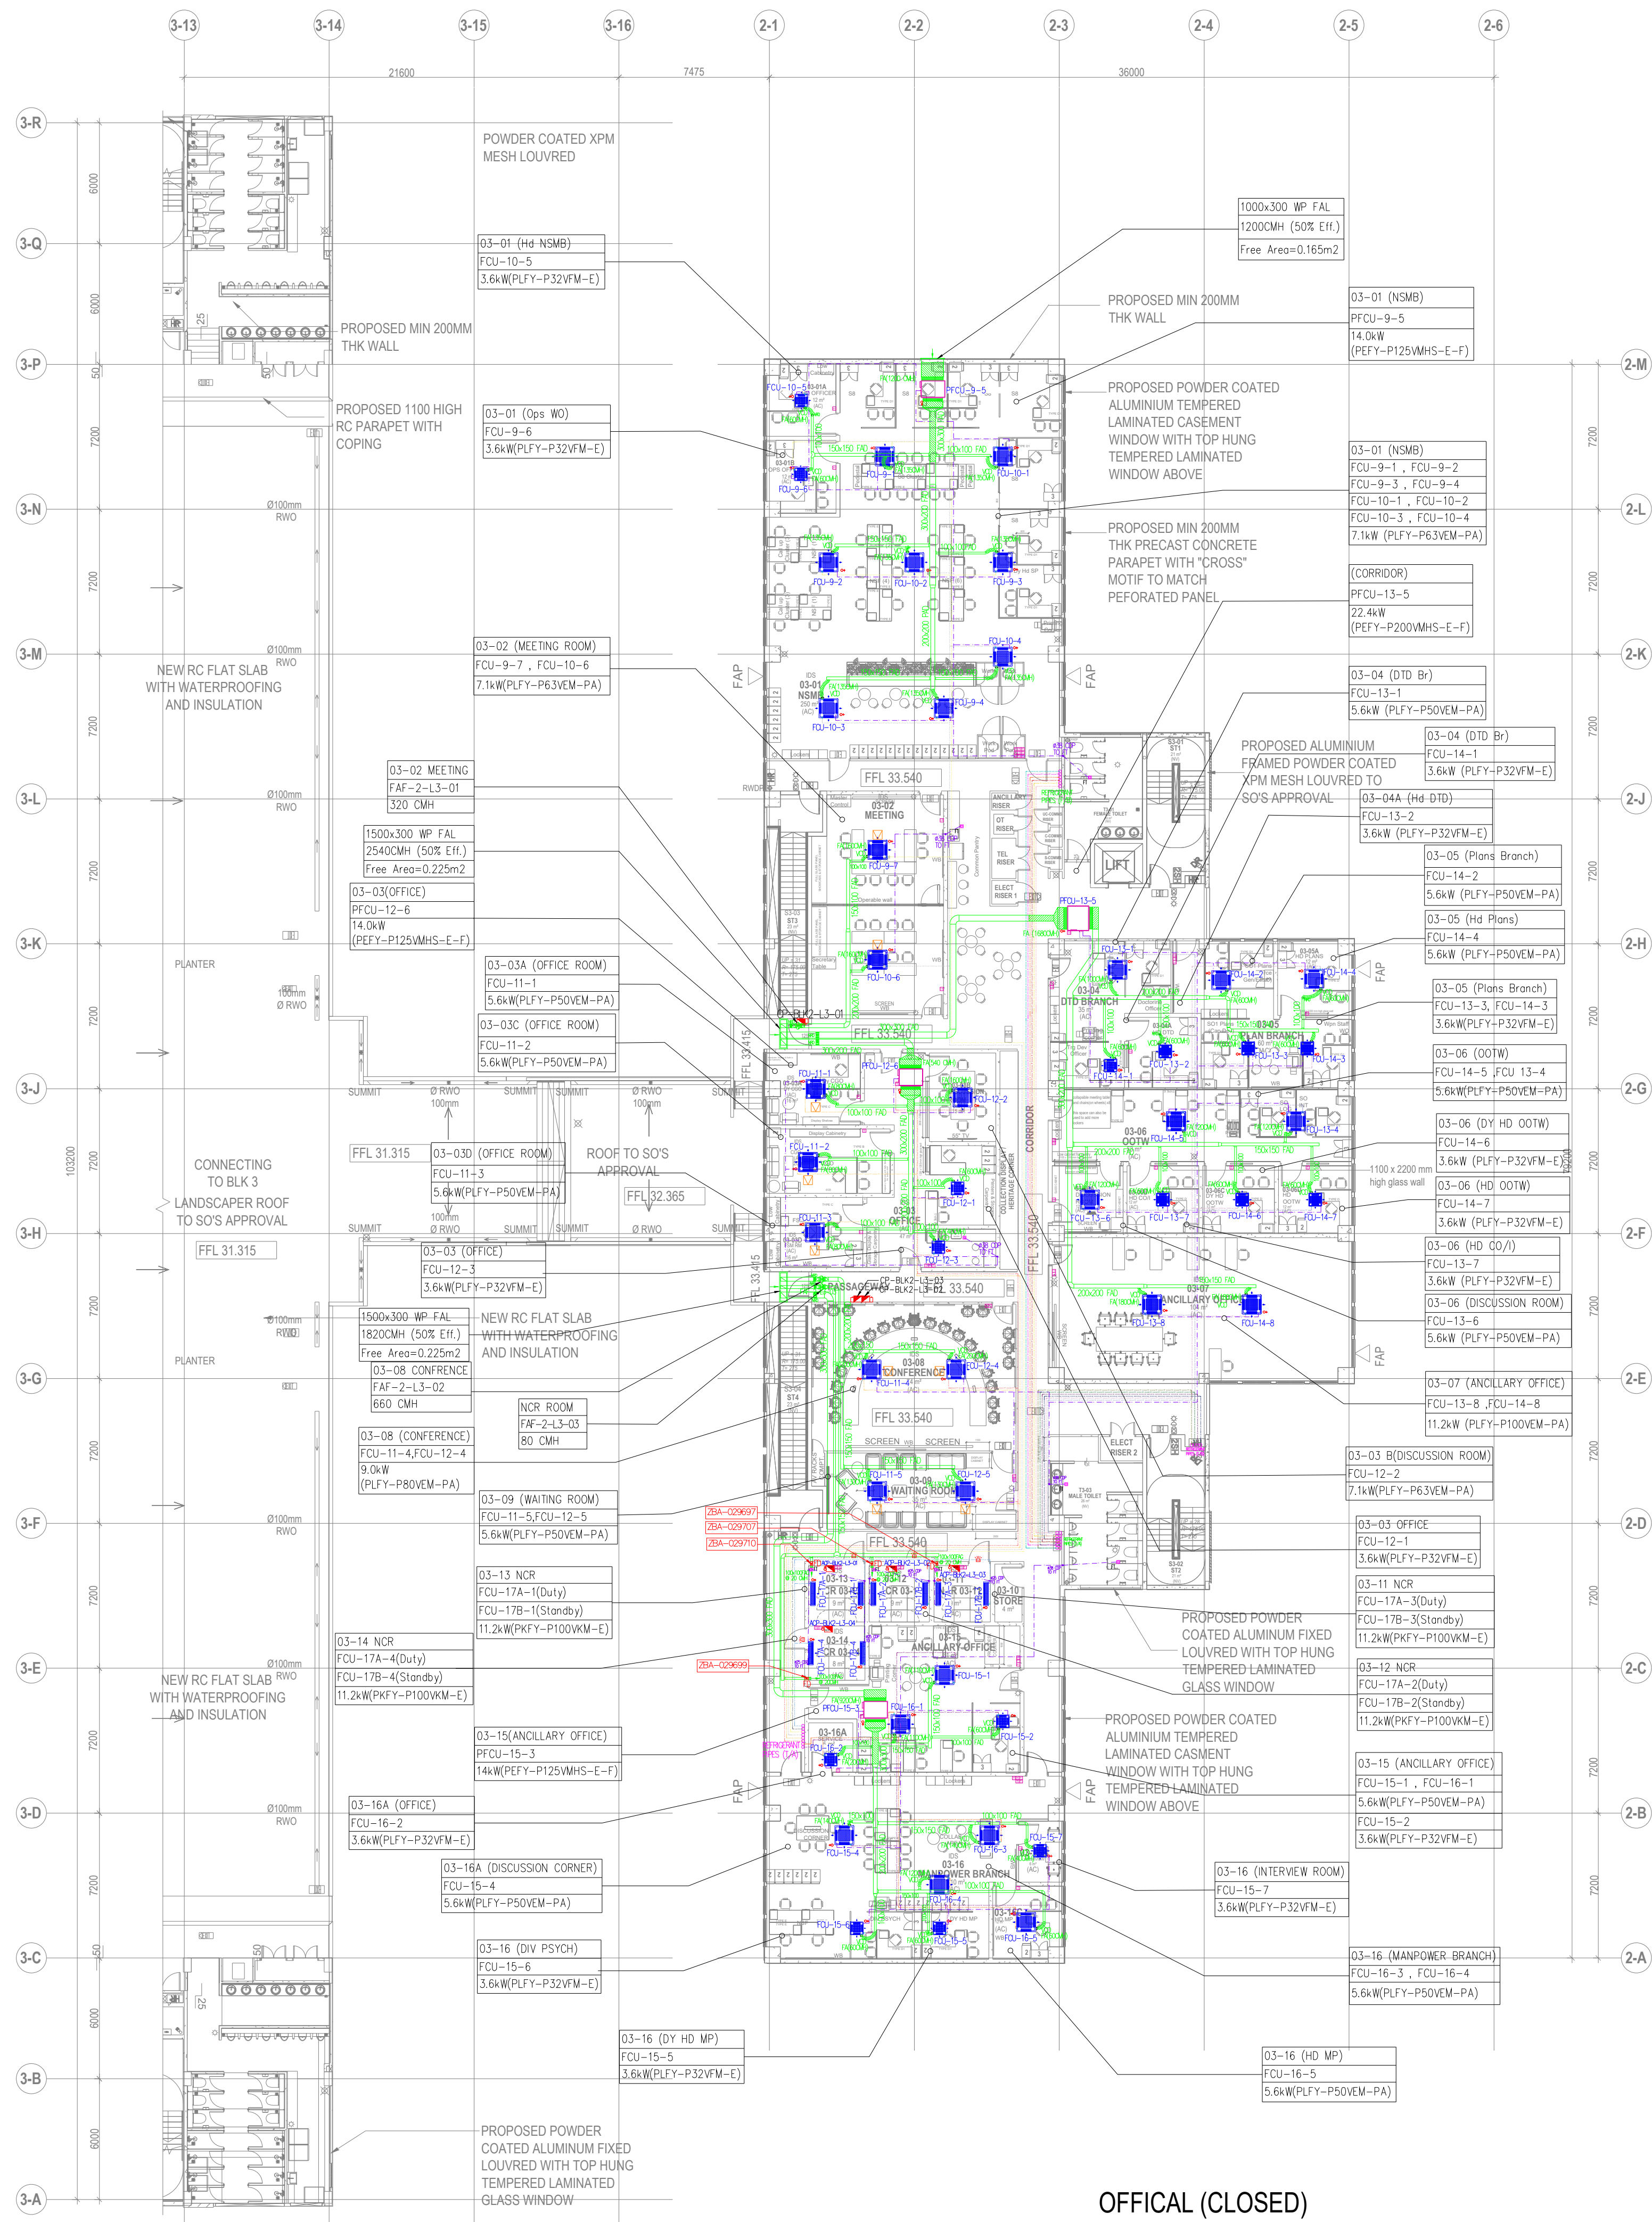

OFFICAL (CLOSED)

M&E CONSULTANTS  
**PdcConsultants Pte Ltd**  
23 NEW INDUSTRIAL ROAD #06-03  
SOLISTICE BUSINESS CENTER SINGAPORE 536209  
TEL: 6444 7748  
FAX: 6444 7141

DATE RECEIVED: \_\_\_\_\_ RECEIVED BY: \_\_\_\_\_  
DATE RETURNED: \_\_\_\_\_

☐ NO EXCEPTION TAKEN ☐ MAKE CORRECTIONS NOTED PRIOR TO GENERAL USE  
☐ TO REVISE & RESUBMIT ☐ REJECTED & RESUBMIT

SIGNATURE: \_\_\_\_\_

• WHERE RESUBMISSION IS REQUIRED, SUBMIT REVISED DRAWINGS FOR REVIEW PRIOR TO PROCEEDING WITH WORK  
• THIS REVIEW IS FOR GENERAL ARRANGEMENT ONLY AND DOES NOT EXTEND TO DIMENSIONS OF SETTING OUT OF THE WORKS AND DOES NOT RELEASE THE CONTRACTOR OF HIS RESPONSIBILITIES TO ENSURE FULL COMPLIANCE  
• THIS REVIEW DOES NOT RELEASE THE CONTRACTOR OF HIS RESPONSIBILITIES TO ENSURE WORKS IN COMPLIANCE TO CONTRACT SPECIFICATION, OTHER DRAWINGS AND STATUTORY REQUIREMENT HAVING JURISDICTION OVER THE INSTALLATION.

LEGEND :		LEGEND :	
	4 WAY CEILING CASSETTE FCU		FAD (FRESH AIR DUCT)
	WALL MOUNTED FCU		EAD (EXHAUST AIR DUCT)
	CEILING DUCTED FCU		FIRE RATED DUCT
	CONDENSING UNIT		INTERNAL INSULATION
	THERMOSTAT(REMOTE)		SAG (SUPPLY AIR GRILLE)
	CENTRALIZED REMOTE CONTROLLER		EAG (EXHAUST AIR GRILLE)
	RP (REFRIGERANT PIPE)		FAL (FRESH AIR LOUVER)
	CDP (CONDENSATE DRAIN PIPE)		NRD (NON RETURN DAMPER)
	(CP) CONTROL PANEL FOR MV		VCD (VOLUME CONTROL DAMPER)
	(ACP) 24HRS ARCON CHANGEOVER PANEL		MD (MOTORIZED DAMPER)
	POWER ISOLATOR		FD (FIRE DAMPER)
	POWER POINT(13A)		STROBE-LIGHT / HIGH Temp Beacon Light
	MECHANICAL VENTILATION FAN		EXPANSION CONTROLLER

AS-BUILT DRAWING

Project Ref. No. : A2105-00599-2022

PEH SEOH CHIN  
HOD (Army Camps)

EDMUND TEO KUAN WEI  
Senior Programme Manager

D&B Main Contractor:  
**DEENN ENGINEERING PTE LTD**  
29 Harrison Road, Lian Beng Building, Singapore 369648  
TEL No.6283 1468 FAX No.6280 9360  
e-mail : lianbengconstrn@pacific.net.sg  
Website: www.lianbeng.com.sg

Architect:  
**ID ARCHITECTS PTE LTD**  
3 HarbourFront Place, #03-01,  
HarbourFront Tower Two,  
Singapore 089254  
Tel: 6225 6011  
Fax: 6225 6022  
general@idarchitects.com.sg  
www.idarchitects.com.sg

Structure:  
**TW-ASIA Consultants Pte Ltd**  
NO. 28 SIN MING LANE #04-137 MIDVIEW CITY  
SINGAPORE 573972 TEL : 62916292 FAX : 62932196

M&E Consultant:  
**PdcConsultants Pte Ltd**  
23 NEW INDUSTRIAL ROAD #06-03  
SOLISTICE BUSINESS CENTER  
SINGAPORE 536209  
TEL: 6444 7748 F: 6444 7141  
E: contact@pdcngs.com

Sub Contractor:  
**INTAC SYSTEMS SOLUTION PTE LTD**  
BLOCK 1 KAKI BUKIT AVENUE 3  
#04-03 KB-1, SINGAPORE 416087  
Tel: +65 6842 7318 Fax: +65 6842 7319  
Email: intac@intacsystems.com.sg

Project No.:  
D2019-00162

Project Title:  
PROPOSED ADDITIONS OF 1 BLOCK OF 3-STOREY OFFICE BUILDING (BLK 2), 1 BLOCK OF 6-STOREY ACCOMMODATION BUILDING (BLK 3), 1 BLOCK OF 4-STOREY ACCOMMODATION BUILDING (BLK 4), 1 BLOCK OF 2-STORY TRAINING MULTIPLEX (BLK 9), 1 BLOCK OF MSVS (BLK 10), AND ANCILLARY FACILITIES (BLK 5, 6 & 8) TO EXISTING DIEPPE BARRACK ON LOT 05019M MK13 AT SEMBAWANG ROAD (MANDAI PLANNING AREA)

Drawing title:  
BLOCK 2 - 3RD STOREY ACMV LAYOUT PLAN

	Initial	Date	Scale	Revision no.:
Drawn	MS	30/12/2024	Scale	1:200 (A1)
Checked	HK	30/12/2024	Software	CAD
Drawing no.:	D2019-00162/BLK 2/ACMV 03			Revision no.:
				00

THIS DRAWING IS COPYRIGHT  
THIS DRAWING IS THE PROPERTY OF DSTA. IF FOUND, PLEASE RETURN TO DSTA  
BUILDING AND INFRASTRUCTURE PROGRAMME CENTRE, 1 DEPOT ROAD,  
SINGAPORE 109678  
REPRODUCTION OF DRAWING WITHOUT THE WRITTEN PERMISSION OF DSTA IS  
STRICTLY PROHIBITED. ANY UNAUTHORIZED REPRODUCTION OR POSSESSION  
SHALL BE DEALT WITH UNDER THE OFFICIAL SECRETS ACT.

3RD STOREY PLAN