


OFFICAL (CLOSED)

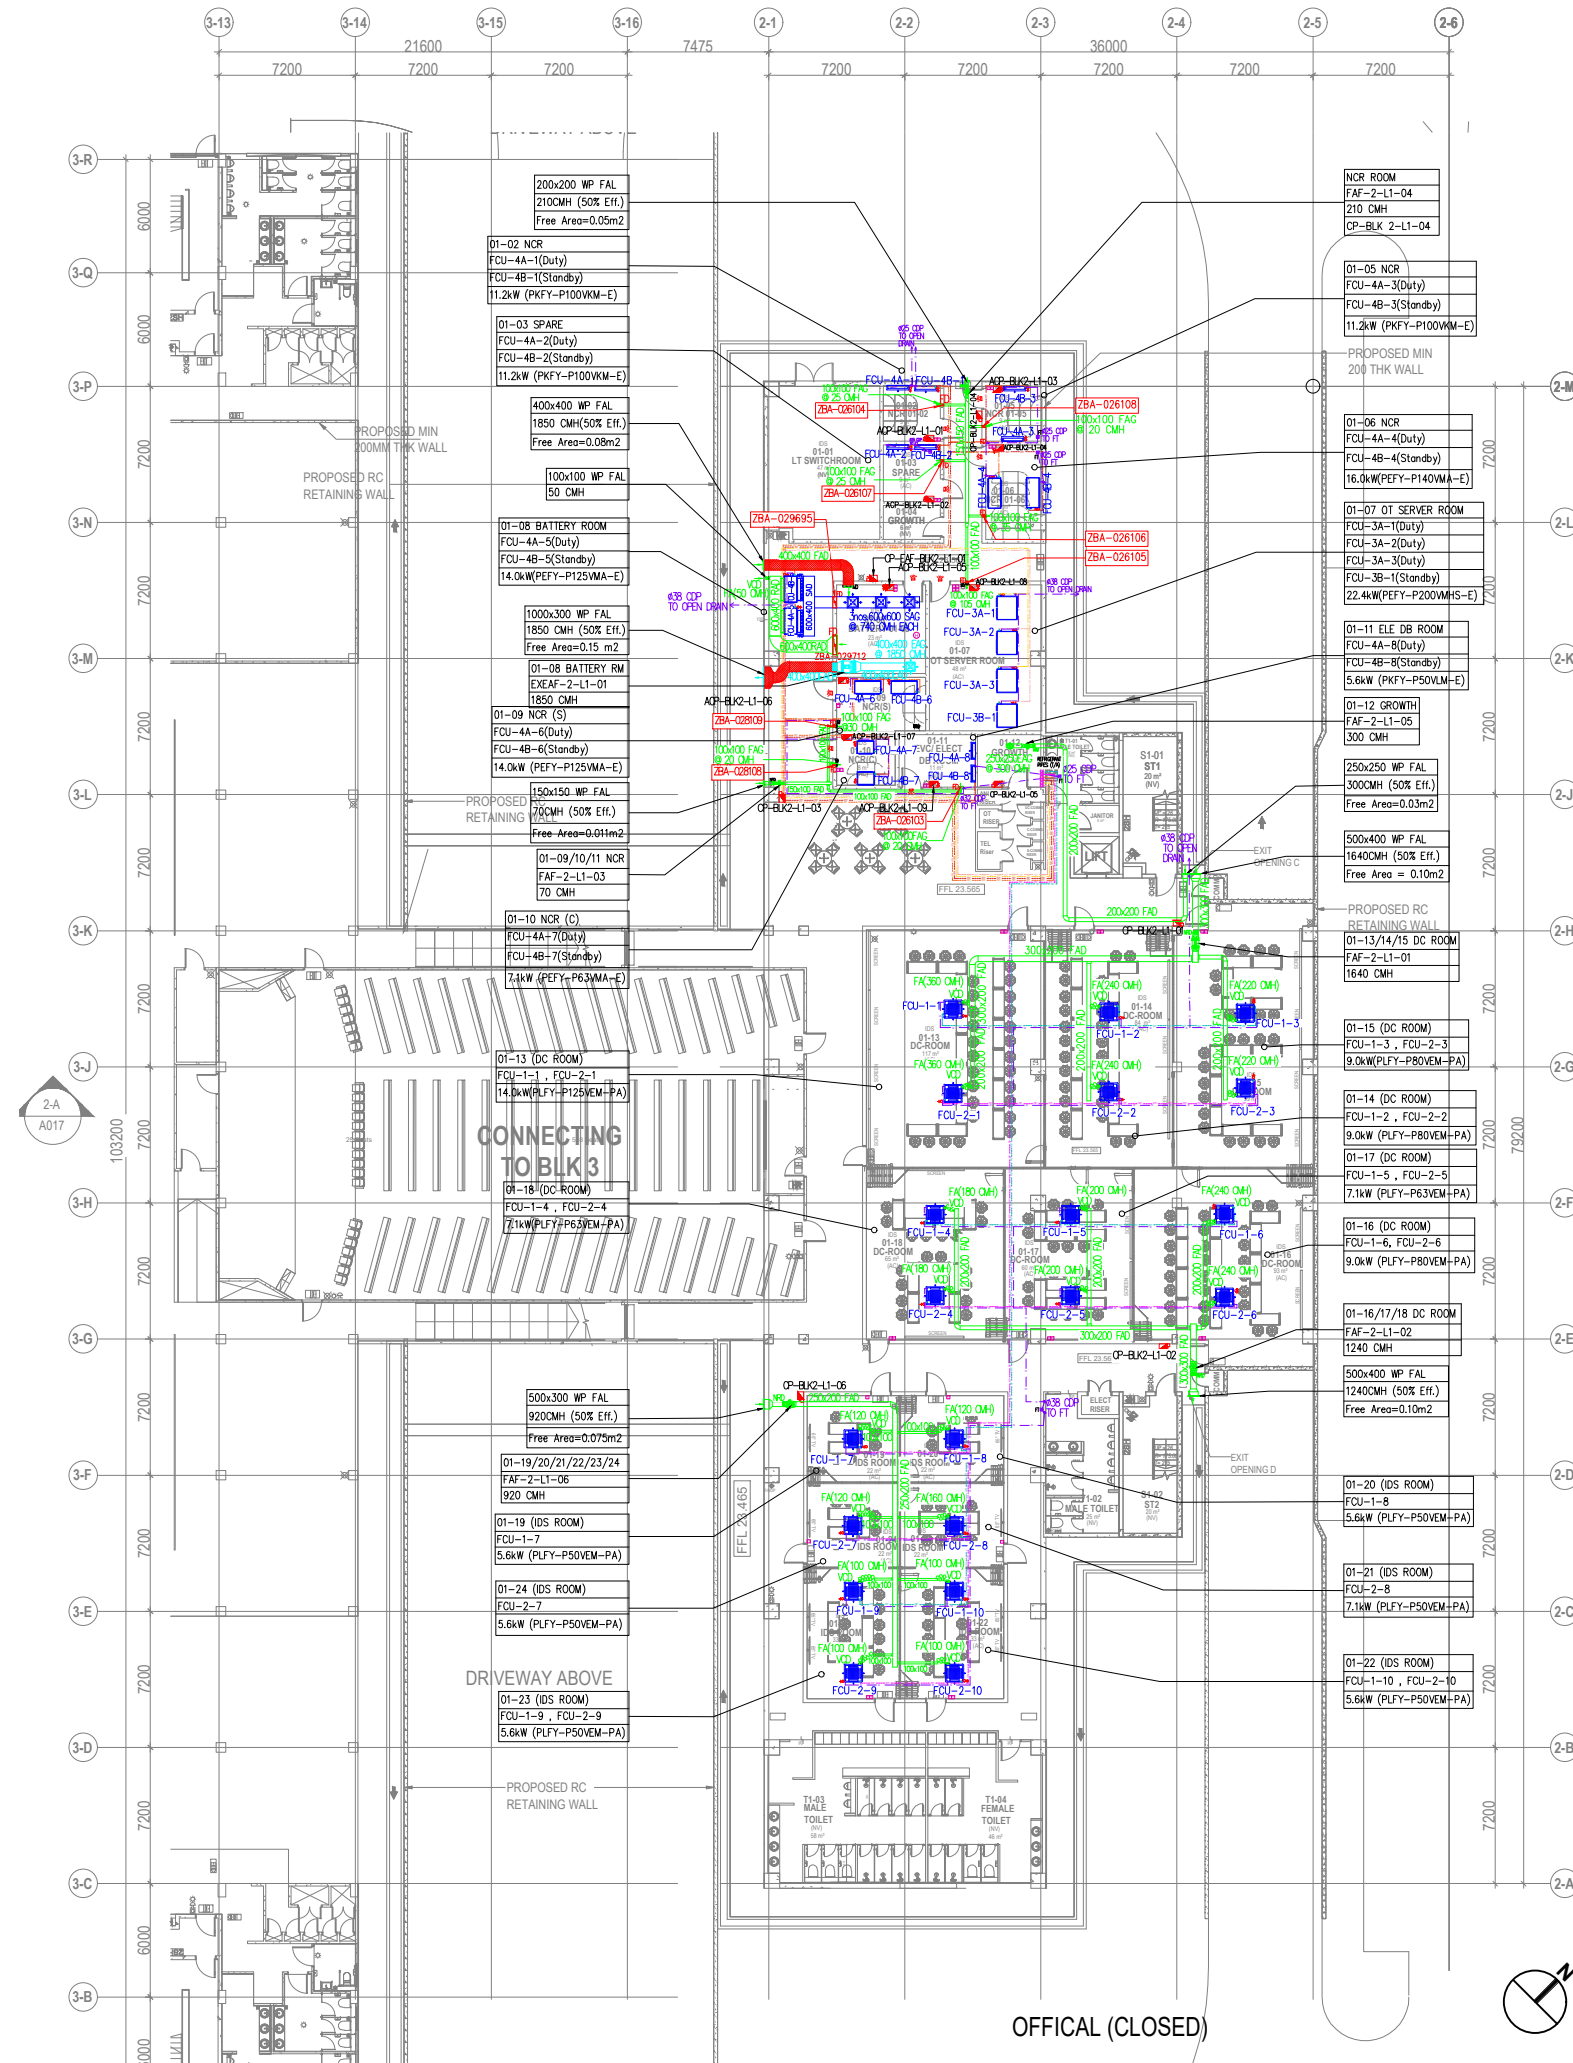

LEGEND :	LEGEND :
4 WAY CEILING CASSETTE FCU	FAD (FRESH AIR DUCT)
WALL MOUNTED FCU	EAD (EXHAUST AIR DUCT)
CEILING DUCTED FCU	FIRE RATED DUCT
CONDENSING UNIT	INTERNAL INSULATION
THERMOSTAT(REMOTE)	SAG (SUPPLY AIR GRILLE)
CENTRALIZED REMOTE CONTROLLER	EAG (EXHAUST AIR GRILLE)
RP (REFRIGERANT PIPE)	FAL (FRESH AIR LOUVER)
CDP (CONDENSATE DRAIN PIPE)	NRD (NON RETURN DAMPER)
(CP) CONTROL PANEL FOR MV	VCD (VOLUME CONTROL DAMPER)
(ACP) 24HRS AIRCON CHANGEOVER PANEL	MD (MOTORIZED DAMPER)
POWER ISOLATOR	FD (FIRE DAMPER)
POWER POINT(13A)	STROBE-LIGHT / HIGH Temp Beacon Light
MECHANICAL VENTILATION FAN	EXPANSION CONTROLLER

M&E CONSULTANTS
PdcConsultants Pte Ltd
23 NEW INDUSTRIAL ROAD #06-03
SOLSTICE BUSINESS CENTRE SINGAPORE 530209
TEL: 6444 7748
FAX: 6444 7141

DATE RECEIVED: _____
DATE RETURNED: _____
RECEIVED BY: _____

☐ NO EXCEPTION TAKEN
☐ MAKE CORRECTIONS NOTED PRIOR TO GENERAL USE
☐ TO REVISE & RESUBMIT
☐ REJECTED & RESUBMIT

SIGNATURE: _____

• WHERE RESUBMISSION IS REQUIRED, SUBMIT REVISED DRAWINGS FOR REVIEW PRIOR TO PROCEEDING WITH WORK
• THIS REVIEW IS FOR GENERAL ARRANGEMENT ONLY AND DOES NOT EXTEND TO DIMENSIONS OF SETTING OUT OF THE WORKS AND DOES NOT RELEASE THE CONTRACTOR OF HIS RESPONSIBILITIES TO ENSURE FULL COMPLIANCE
• THIS REVIEW DOES NOT RELEASE THE CONTRACTOR OF HIS RESPONSIBILITIES TO ENSURE WORKS IN COMPLIANCE TO CONTRACT SPECIFICATION, OTHER DRAWINGS AND STATUTORY REQUIREMENT HAVING JURISDICTION OVER THE INSTALLATION.

AS-BUILT DRAWING

Project Ref. No. : A2105-00599-2022



PCH SEOH CHIN
H&I (Army Camp)

EDMUND TEO KUAN WEI
Senior Programme Manager

D&B Main Contractor:

DEENN ENGINEERING PTE LTD
29 Harrison Road, Lian Beng Building, Singapore 369648
TEL No 6283 1468 FAX No 6280 9360
e-mail : lianbengconstn@pacific.net.sg
Website: www.lianbeng.com.sg

Architect:
ID ARCHITECTS PTE LTD
3 HarbourFront Place, #03-01,
HarbourFront Tower Two,
Singapore 099254
Tel: 6225 6011
Fax: 6225 6022
general@idarchitects.com.sg
www.idarchitects.com.sg

Structure:

TW-ASIA Consultants Pte Ltd

NO. 28 SIN MING LANE #04-137 MIDVIEW CITY
SINGAPORE 573972 TEL : 62916292 FAX : 62832196

M&E Consultant:

PdcConsultants Pte Ltd
23 New Industrial Road #06-03
Solstice Business Center
Singapore 530209
t: 6444 7748 f: 6444 7141
e: contact@pdcengs.com

Sub Contractor:

INTAC SYSTEMS SOLUTION PTE LTD
BLOCK 1 KAKI BUKIT AVENUE 3
#04-03 KB-1, SINGAPORE 416087
Tel: +65 6862 7318 Fax: +65 6862 7319
Email: intacsol@intacsol.com.sg

Project No:

D2019-00162

Project Title:

PROPOSED ADDITIONS OF 1 BLOCK OF 3-STORY OFFICE BUILDING (BLK 2), 1 BLOCK OF 6-STORY ACCOMMODATION BUILDING (BLK 3), 1 BLOCK OF 4-STORY ACCOMMODATION BUILDING (BLK 4), 1 BLOCK OF 2-STORY TRAINING MULTIPLEX (BLK 9), 1 BLOCK OF MSVS (BLK 10), AND ANCILLARY FACILITIES (BLK 5, 6 & 8) TO EXISTING DIEPPE BARRACK ON LOT 05019M MK13 AT SEMBAWANG ROAD (MANDAI PLANNING AREA)

Drawing title:

BLOCK 2_1ST STOREY ACMV LAYOUT PLAN

Initial Date Scale

Drawn MS 30/12/2024 t:200 (A1)

Checked HK 30/12/2024 Software CAD

Drawing no:

D2019-00162/BLK 2/ACMV 01

Revision no:

00

THIS DRAWING IS COPYRIGHT
THIS DRAWING IS THE PROPERTY OF DSTA. IF FOUND, PLEASE RETURN TO DSTA
BUILDING AND INFRASTRUCTURE PROGRAMME CENTRE, 1 DEPOT ROAD,
SINGAPORE 109679.
REPRODUCTION OF DRAWING WITHOUT THE WRITTEN PERMISSION OF DSTA IS
STRICTLY PROHIBITED. ANY UNAUTHORIZED REPRODUCTION OR POSSESSION
SHALL BE DEALT WITH UNDER THE OFFICIAL SECRETS ACT.

1ST STOREY PLAN