


BLK 2 - LEVEL 1 DC ROOM 01-12 TO 01-19  
SCALE 1 :100

LEGEND & SYMBOL	
	800 ANSI LUMENS / 10000 RESOLUTION EB-L3200 (EPSON/JAPAN)
	MOTORIZED SCREEN - 8000(W) X 6000(H) IMAGE SIZE: 8000(W) X 3750(H) 16:9 HARRIS MEGAVIEW (LAIN/SINGAPORE) CASING DIM: 835(W) X 274(H) X 254(D)mm
	7" FULL RANGE CEILING SPEAKER, 30W/100V F-2322C (TAN/JAPAN) DIM: 230(DIA) X 200(H)mm
	WDM WALL PLATE WPD10A (EXTRON/USA) DIM: 89(W) X 114(H) X 50(D)mm
	LAN RECEPTACLE SINGLE GANG SIZE
	NETWORK BUTTON PANEL - 16 BUTTONS NP200 (EXTRON/USA) DIM: 165(W) X 114(H) X 46(D)mm
	3KVA UPS TO BACKUP SOUND SYSTEM FOR 15 MINS ST2100 (ACG/TAIPEI) DIM: 200(W) X 345(H) X 450(D)mm - UPS DIM: 210(W) X 200(H) X 510(D)mm - Battery
	4 CHANNEL BALLAST CONTROLLER, POWER SUPPLY UNIT, RS232 AV INTERFACE HOUSE IN ENCLOSURE 414 422 300 (HELVAR/FINLAND) DIM: 490(W) X 380(H) X 110(D)mm
	16 BUTTON CONTROL PANEL 160SS (HELVAR/FINLAND) DIM: 80(W) X 86(H) X 110(D)mm
	PTZ PTZ 20X CAMERA PTC-140 (DATAVIDEO/TAIWAN) DIM: 150(W) X 185(H) X 183.5(D)mm
	PTZ CAMERA CONTROL UNIT RMC-100 MK II (DATAVIDEO/TAIWAN) DIM: 310(W) X 170(H) X 125(D)mm
	19" EQUIPMENT RACK DIM: 600(W) X 2070(H) X 600(D)mm
	10" WIRED TOUCH PANEL TLP PRO 10ST (EXTRON/USA) DIM: 257(W) X 174(H) X 105(D)mm
	UPS (FLOOR STANDING) ST2100C (ACG/TAIPEI) DIM: 190(W) X 330(H) X 427(D)mm
	UPS BATTERY CABINET (FLOOR STANDING) 16AH BATTERY X 8PCS DIM: 210(W) X 200(H) X 510(D)mm
	13A 1-GANG SWITCH SOCKET OUTLET
	20A ISOLATOR

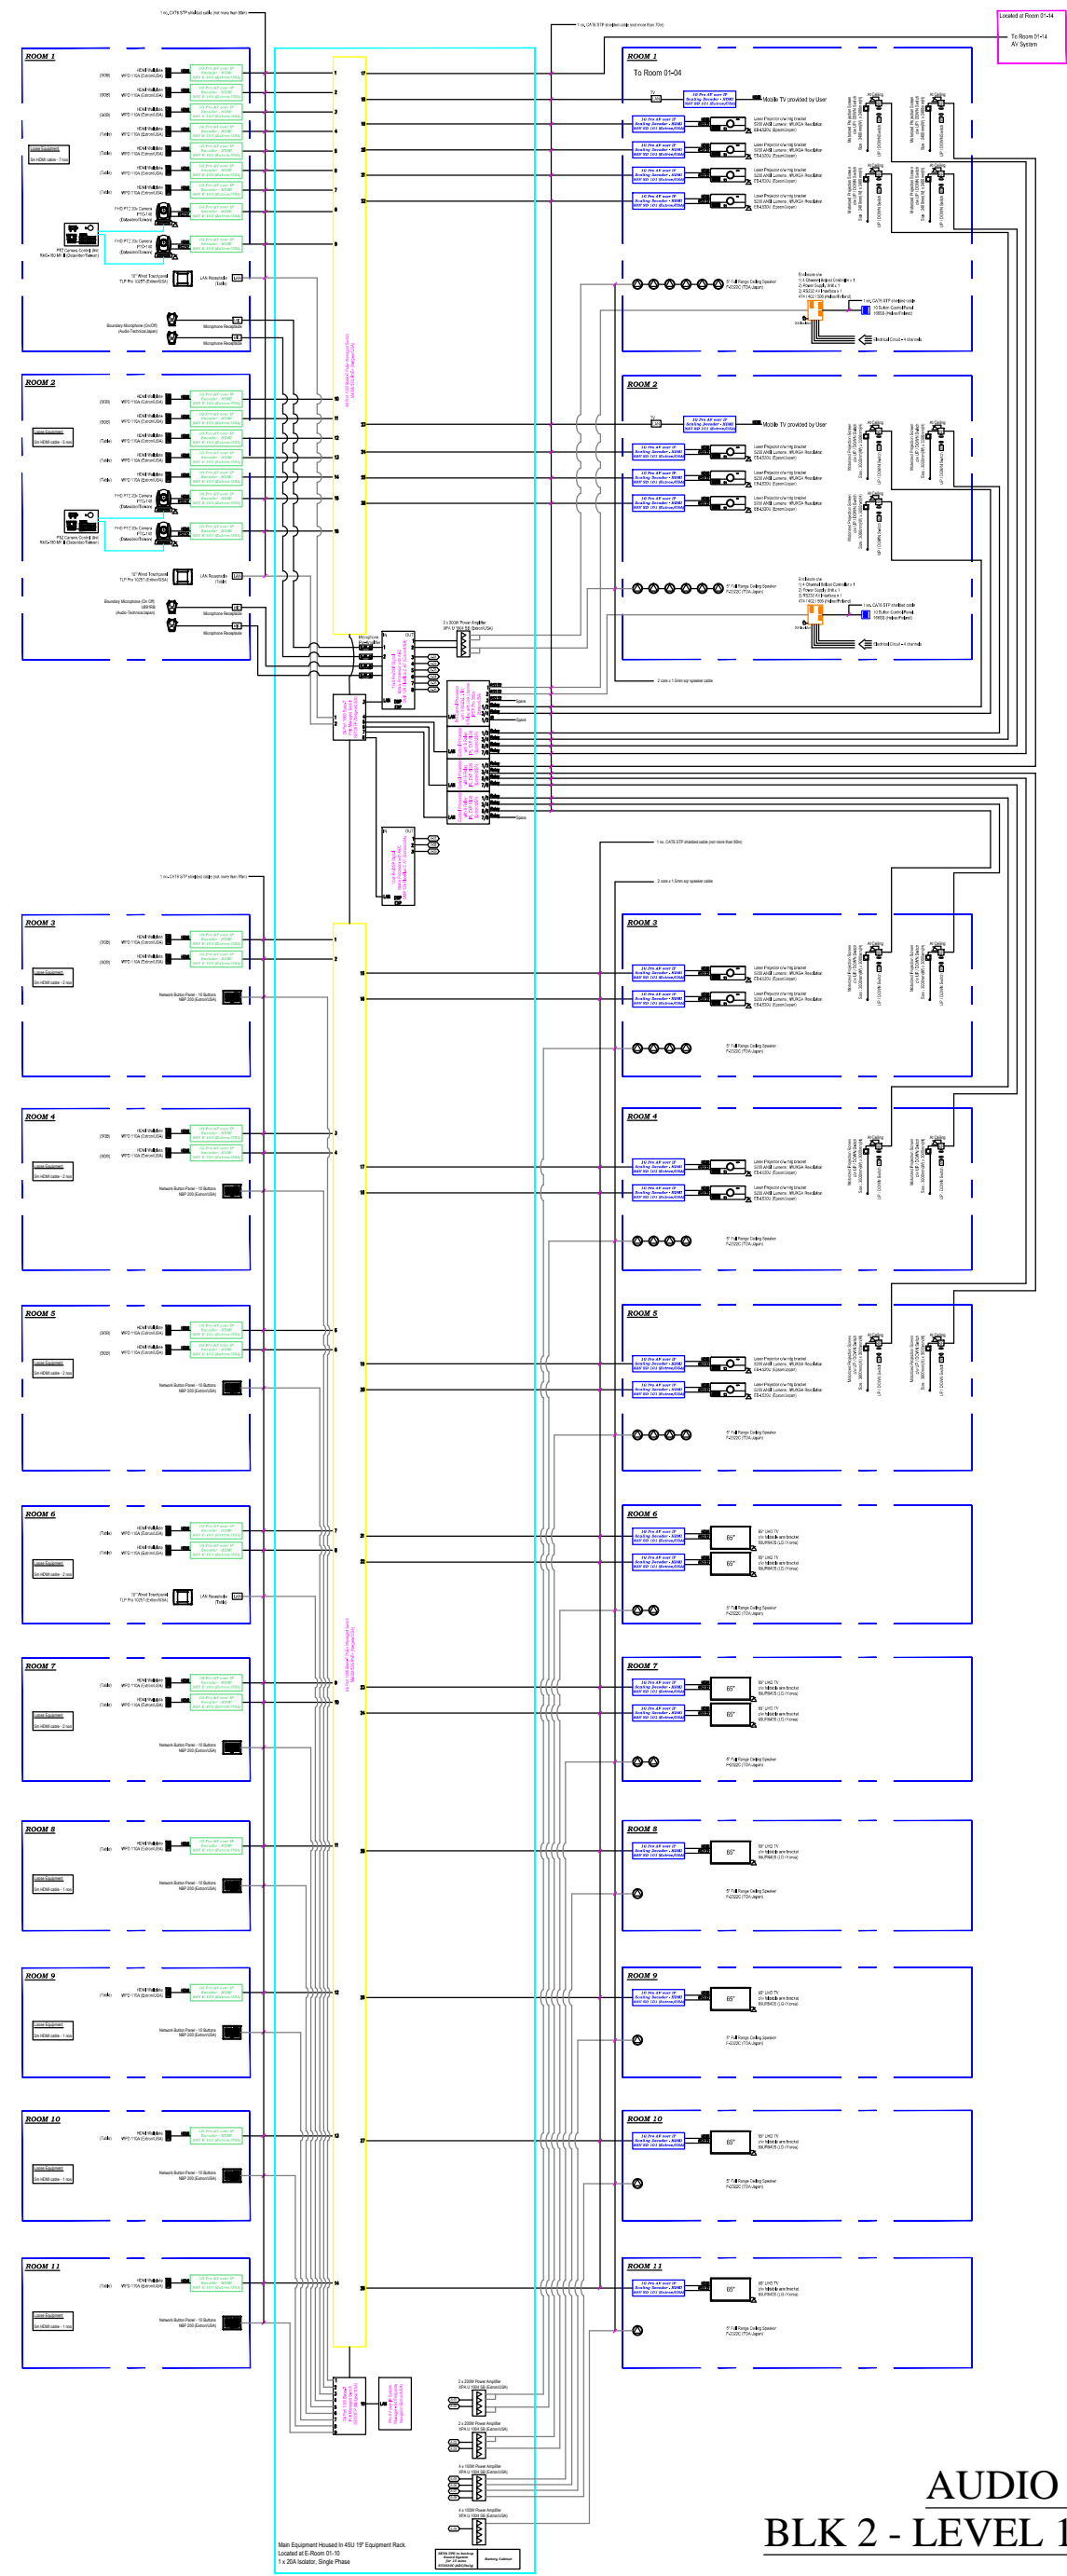

AUDIO VISUAL SYSTEM  
BLK 2 - LEVEL 1 DC ROOM 01-12 TO 01-19

## AS BUILT DRAWING

DEVELOPER:



CHIN  
HCD (Army Camps)

Edmund Teo  
Kuan Wei

Senior Programme Manager

D&B MAIN CONTRACTOR:

**DEENN ENGINEERING PTE LTD**  
29 Harrison Road, Lian Beng Building, Singapore 369648  
TEL: No. 6283 1468 FAX No. 6280 9360  
e-mail: lianbengconstn@pacific.net.sg  
Website: www.lianbeng.com.sg

ARCHITECT CONSULTANT:

**ID ARCHITECTS PTE LTD**  
3 Harbourfront Place, #03-01  
Harbourfront Tower Two  
Singapore 099254  
Tel: 6225 4011 Fax: 6225 4022  
Email: general@idarchitects.com.sg  
www.idarchitects.com.sg

STRUCTURE CONSULTANT:

TW-ASIA Consultants Pte Ltd

NO. 25, SIN MING LANE #04-137 MINDEN CITY  
SINGAPORE 573972 TEL: 62916292 FAX: 62933295

M&E Consultant:

**PdcConsultants Pte Ltd**  
23 New Industrial Road #06-03  
Solstice Business Center  
Singapore 536209  
t: 6444 7748 f: 6444 7141  
e: contact@pdcengrs.com

Sub Contractor:

**CHIN SENG ENGINEERING (S) PTE LTD**  
33 Ubi Avenue 3, Vertex Tower B, #08-27, Singapore 408868  
TEL: 6742 9392 FAX: 6742 9390

Project Title:

PROPOSED ADDITIONS OF 1 BLOCK OF 3-STORY OFFICE  
BUILDING BLK 2, 1 BLOCK OF 6-STORY ACCOMMODATION  
BUILDING BLK 3 (11), 1 BLOCK OF 4-STORY ACCOMMODATION  
BUILDING BLK 4 (10), 1 BLOCK OF 2-STORY TRAINING MULTIPLEX  
BLK 9 (6), 1 BLOCK OF MSVS BLK 10 (9), AND ANCILLARY  
FACILITIES BLK 5, 6(4) & 8 TO EXISTING DIEPPE BARRACK ON LOT  
05019M MK13 AT SEMBAWANG ROAD (MANDAI PLANNING AREA)

Drawing Title:

**AUDIO VISUAL SYSTEM**  
BLOCK 2 - LEVEL 1 DC ROOM 01-12 TO 01-19

Initial	Date	Job ref no.
Designed JEFFREY	08/09/2023	
Checked JEFFREY	08/09/2023	
Drawn KHANG	08/09/2023	Filename
Software CAD		
Scale AS SHOWN		Sources
Drawing no.	D2019-00162/ELECT/BLK2/AV/01	

THIS DRAWING IS COPYRIGHT  
THIS DRAWING IS THE PROPERTY OF DSTA. IF FOUND, PLEASE RETURN TO  
DSTA BUILDING AND INFRASTRUCTURE PROGRAMME CENTRE,  
1 DEPOT ROAD, SINGAPORE 109679.  
REPRODUCTION OF DRAWING WITHOUT THE WRITTEN PERMISSION OF DSTA BI  
IS STRICTLY PROHIBITED. ANY UNAUTHORIZED REPRODUCTION OR POSSESSION  
SHALL BE DEALT WITH UNDER THE OFFICIAL SECRETS ACT.