

AS BUILT DRAWING

DEVELOPER:



VYNNA PEH  
SEOH CHIN

HCD (Army Camps)

Edmund Teo  
Kuan Wei

Senior Programme Manager

Project No.:

D2019-00162

D&B MAIN CONTRACTOR:



**DEENN ENGINEERING PTE LTD**

29 Harrison Road, Lion Beng Building, Singapore 369648  
TEL. No. 6283 1468 FAX No. 6280 9360  
e-mail : lionbengconstn@pacific.net.sg  
Website: www.lionbeng.com.sg

ARCHITECT CONSULTANT:

**ID ARCHITECTS PTE LTD**

3 Harbourfront Place, #03-01  
Harbourfront Tower Two  
Singapore 099254  
Tel: 6225 4011 Fax: 6225 4022  
Email: general@idarchitects.com.sg  
www.idarchitects.com.sg

STRUCTURE CONSULTANT:

**TW-ASIA Consultants Pte Ltd**

NO. 25, SIN MING LANE #04-137 MINDEN CITY  
SINGAPORE 573972 TEL : 62916292 FAX : 62933296

M&E Consultant:



**PdcConsultants Pte Ltd**

23 New Industrial Road #06-03  
Solstice Business Center  
Singapore 536209  
t: 6444 7748 f: 6444 7141  
e: contact@pdcengrs.com

Sub Contractor:

**CHIN SENG ENGINEERING (S) PTE LTD**

33 Ubi Avenue 3, Vertex Tower B, #08-27, Singapore 408868  
TEL: 6742 9392 FAX: 6742 9390

Project Title:


PROPOSED ADDITIONS OF 1 BLOCK OF 3-STOREY OFFICE BUILDING BLK 2, 1 BLOCK OF 6-STOREY ACCOMMODATION BUILDING BLK 3 (11), 1 BLOCK OF 4-STOREY ACCOMMODATION BUILDING BLK 4 (10), 1 BLOCK OF 2-STOREY TRAINING MULTIPLEX BLK 9 (6), 1 BLOCK OF MSVS BLK 10 (9), AND ANCILLARY FACILITIES BLK 5, 6(4) & 8 TO EXISTING DIEPPE BARRACK ON LOT 05019M MK13 AT SEMBAWANG ROAD (MANDAI PLANNING AREA)

Drawing Title:

**BLOCK 2 - 2ND STOREY  
LIGHTNING PROTECTION LAYOUT**

Designed	Initial	Date	Job ref no.
JEFFREY		19/09/2024	
Checked	JEFFREY	19/09/2024	
Drawn	KHANG	19/09/2024	Filename
Software	CAD		
Scale	1:250	Sources	
Drawn no.	D2019-00162/ELECT/BLK2/LPS/02		

THIS DRAWING IS COPYRIGHT  
THIS DRAWING IS THE PROPERTY OF DSTA. IF FOUND, PLEASE RETURN TO  
DSTA BUILDING AND INFRASTRUCTURE PROGRAMME CENTRE,  
1 DEPOT ROAD, SINGAPORE 108673.  
REPRODUCTION OF DRAWING WITHOUT THE WRITTEN PERMISSION OF DSTA IS  
STRICTLY PROHIBITED. ANY UNAUTHORIZED REPRODUCTION OR POSSESSION  
SHALL BE DEALT WITH UNDER THE OFFICIAL SECRETS ACT.

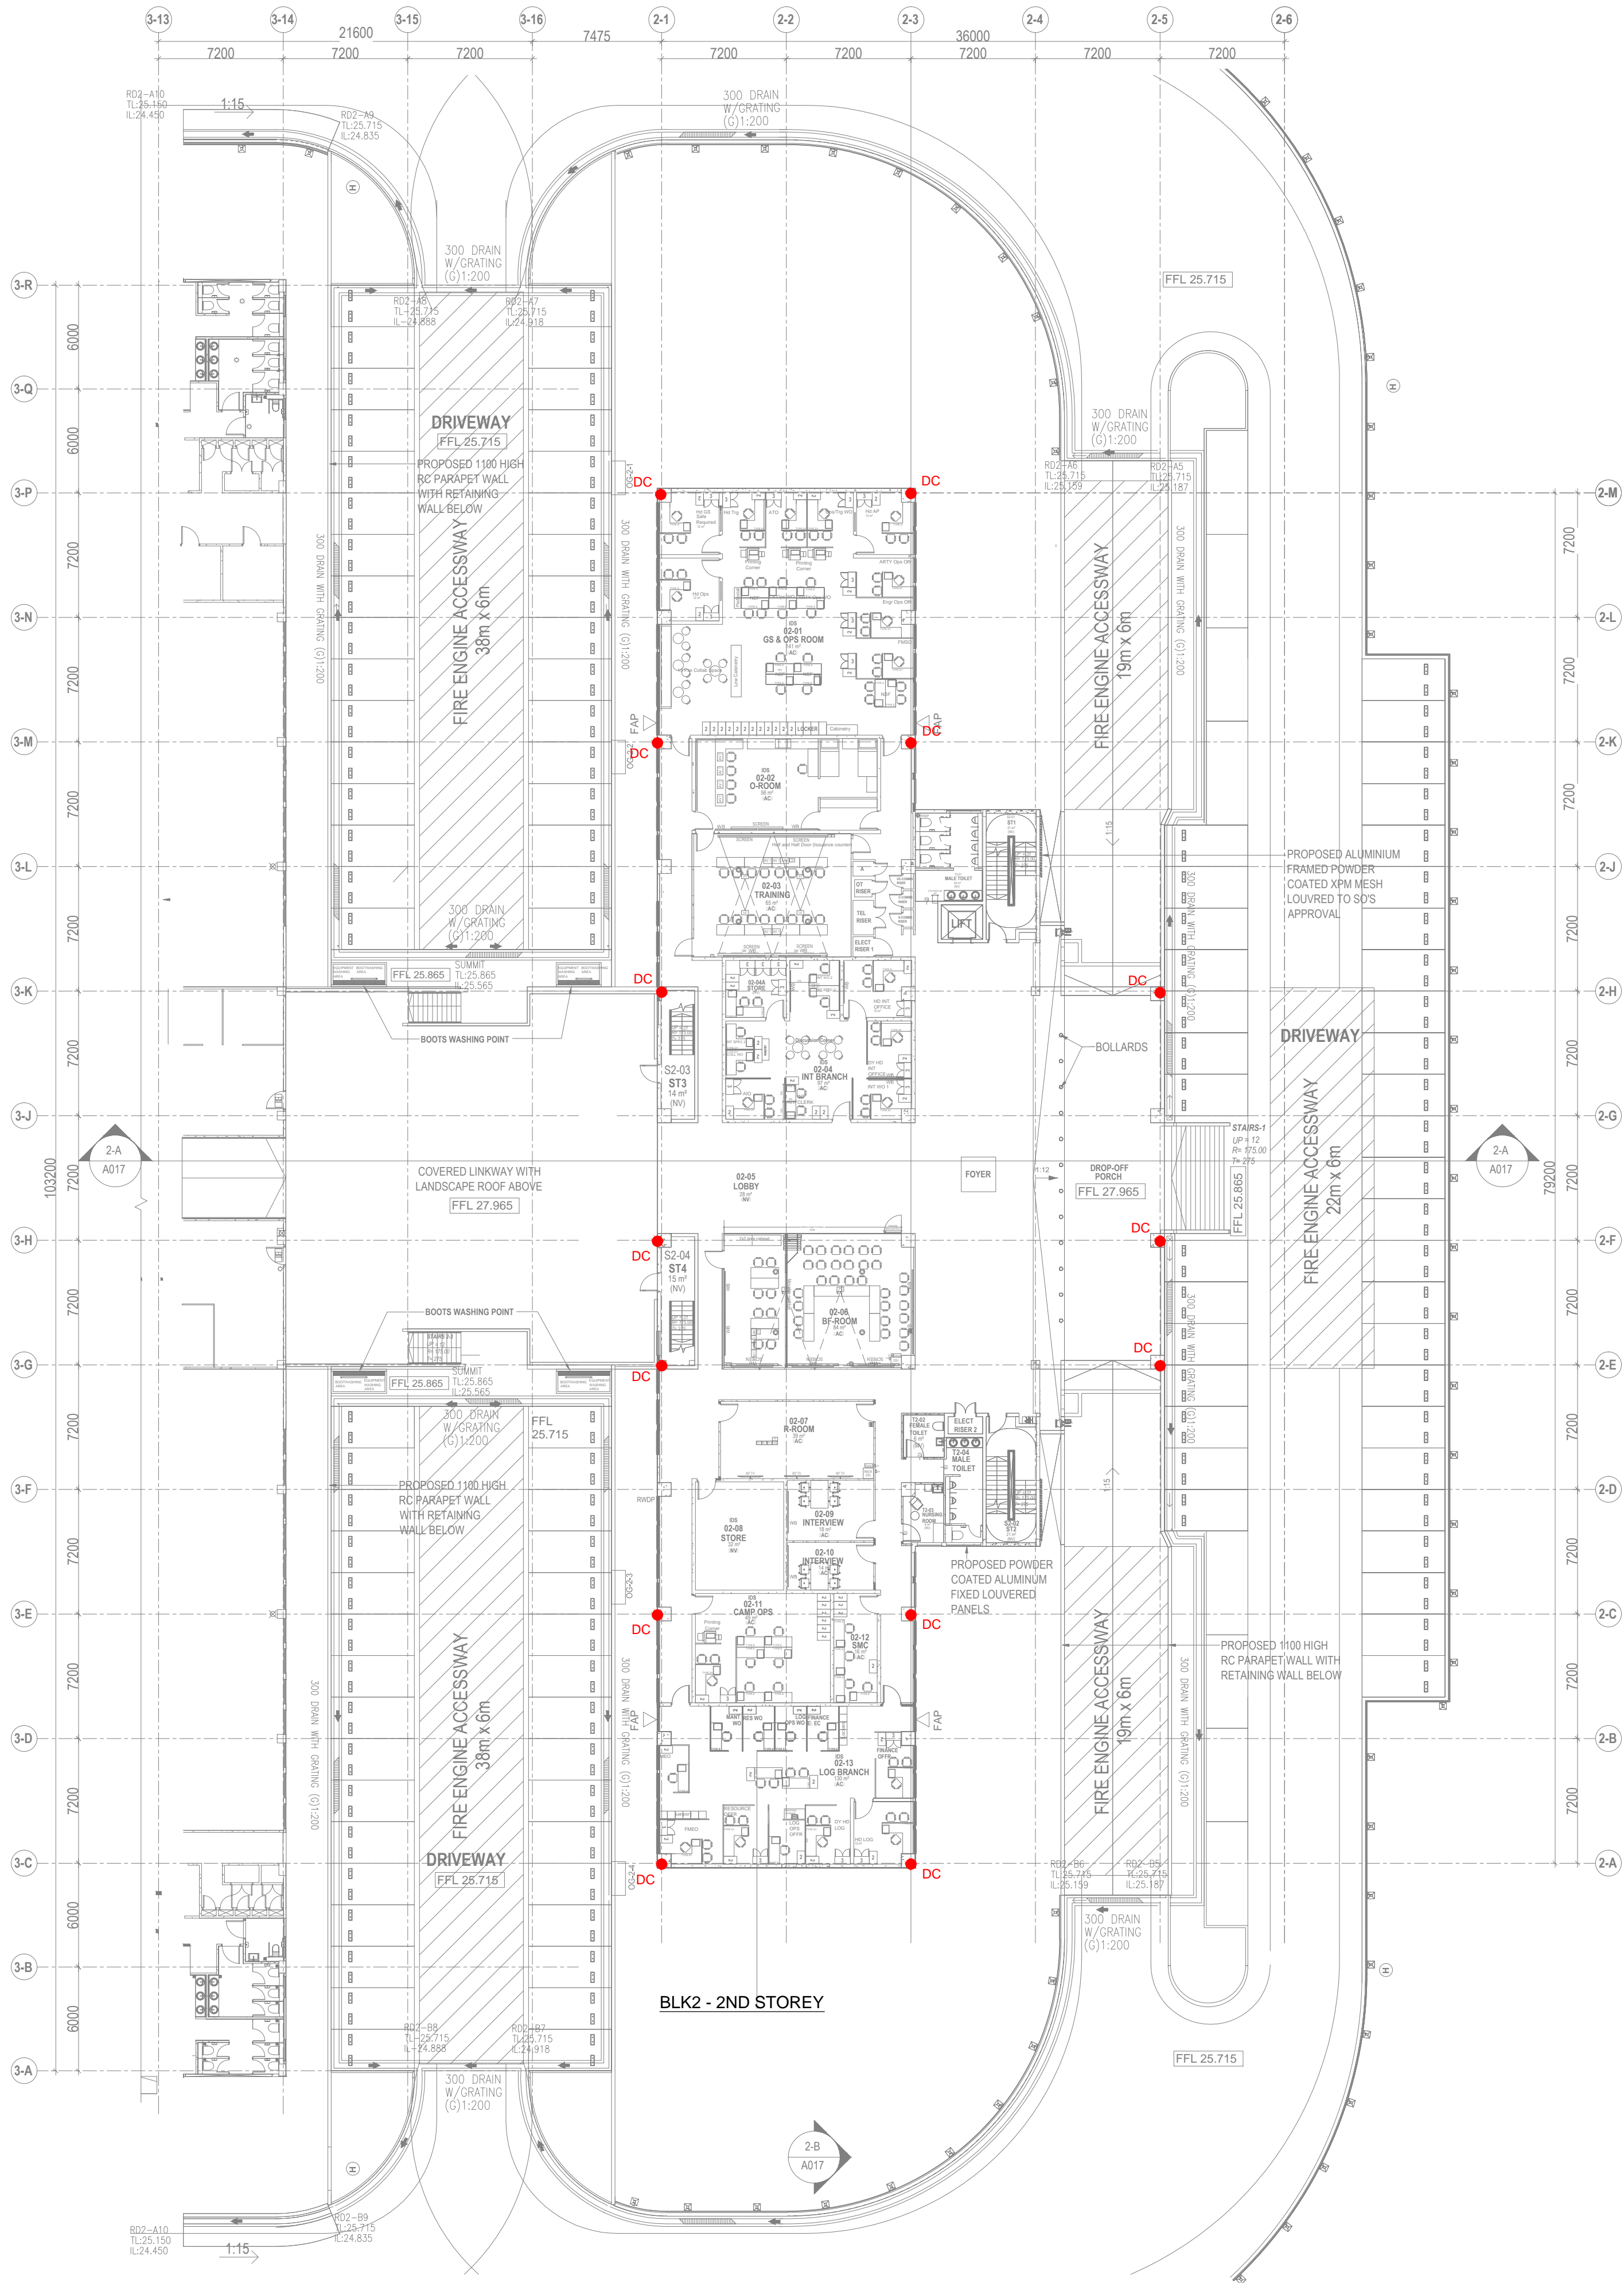

Legend	Description
	Earth Pit (Pilecap) C/W Test Link Box
	Down Conductor (T13 Dedicated Rebar)
	BONDED
	2.5m Air Terminal
	300 mm Air Terminal
	25mm x 3mm Aluminium Tape
	T13 Dedicated Rebar