


LEGEND

| SYMBOL | DESCRIPTIONS |
|--------|--|
| | 13A SWITCH SOCKET OUTLET (ONE GANG) |
| | 13A TWIN SWITCH SOCKET OUTLET (TWO GANG) |
| | 13A SWITCH SOCKET OUTLET (ONE GANG, METAL/GLASS) |
| | 13A SWITCH SOCKET OUTLET (TWO GANG, METAL/GLASS) |
| | 13A SWITCH SOCKET OUTLET (ONE GANG, MOUNTED AT HIGH LEVEL) |
| | 13A SWITCH SOCKET OUTLET FOR HAND DRYER |
| | 13A SWITCH SOCKET OUTLET WEATHERPROOF |
| | 2 NOS 13A TWIN SWITCH SOCKET OUTLET (TWO GANG) |
| | 13A SWITCH SOCKET OUTLET (ONE GANG) LOCKABLE TYPE |
| | 32A ISOLATOR DP (RATING AS SHOWN ON DRAWING) |
| | ISOLATOR TN (RATING AS SHOWN ON DRAWING) |
| | DISTRIBUTION BOARD / EMERGENCY DISTRIBUTION BOARD |
| | TELEPHONE OUTLET (COMMS - ADMIN) |
| | DATA OUTLET (COMMS - 05A NET = B NET) |
| | DATA OUTLET (COMMS - 1 NET = A NET) |
| | DATA OUTLET (COMMS - 07 NET) |
| | DATA OUTLET (COMMS - 5 NET = C NET) |
| | FLANGE LINE PORT |
| | DEL PORT |
| | DD PORT |
| | WIRELESS ACCESS POINT |
| | 1 NO 24/3A SSO AND 2 NOS 6 HOLE BUS OPENING |
| | 2 NOS 14/3A SSO AND 2 NOS 6 HOLE BUS OPENING |
| | 1 NO 24/3A SSO AND 1 NO 6 HOLE BUS OPENING |
| | 1 NO 24/3A SSO AND 1 NO 6 HOLE BUS OPENING |
| | SSO C/W 1 NO 24/3A SSO AND 4 NOS 24/3A SSO ON SYSTEM FURNITURE |


FOR DC ROOMS

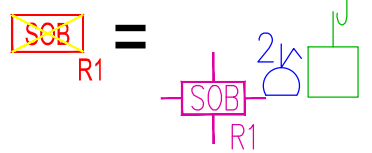

TOTAL SOB BOX = 95 NOS.

AS BUILT DRAWING

DEVELOPER:

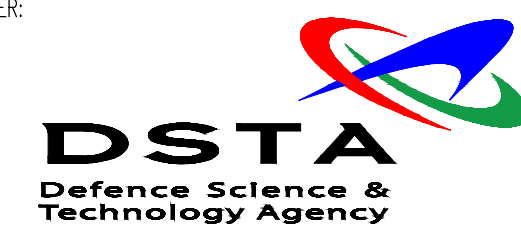

VYNNA PEH
SEOH CHIN

HCD (Army Camps)

Edmund Teo
Kuan Wei

Senior Programme Manager

Project No.:

D2019-00162

D&B MAIN CONTRACTOR:

DEENN ENGINEERING PTE LTD

29 Harrison Road, Lion Beng Building, Singapore 369648
TEL: No.6283 1468 FAX No. 6280 9360
e-mail : lionbengconstn@pacific.net.sg
Website: www.lionbeng.com.sg

ARCHITECT CONSULTANT:

ID ARCHITECTS PTE LTD


3 Harbourfront Place, #03-01
Harbourfront Tower Two
Singapore 099254
Tel: 6225 4011 Fax: 6225 4022
Email: general@idarchitects.com.sg
www.idarchitects.com.sg

STRUCTURE CONSULTANT:

TW-ASIA Consultants Pte Ltd

NO. 25, SIN MING LANE #04-137 MINDEN CITY
SINGAPORE 573972 TEL : 62316292 FAX : 623932 95

M&E Consultant:

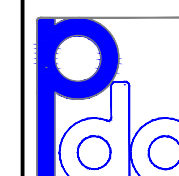

PdcConsultants Pte Ltd

23 New Industrial Road #06-03
Solstice Business Center
Singapore 536209
t : 6444 7748 f : 6444 7141
e : contact@pdcengrs.com

Sub Contractor:

CHIN SENG ENGINEERING (S) PTE LTD

33 Ubi Avenue 3, Vertex Tower B, #08-27, Singapore 408868
TEL: 6742 9392 FAX: 6742 9390

Project Title:

PROPOSED ADDITIONS OF 1 BLOCK OF 3-STORY OFFICE BUILDING BLK 2, 1 BLOCK OF 6-STORY ACCOMMODATION BUILDING BLK 3 (11), 1 BLOCK OF 4-STORY ACCOMMODATION BUILDING BLK 4 (10), 1 BLOCK OF 2-STORY TRAINING MULTIPLEX BLK 9 (6), 1 BLOCK OF MSVS BLK 10 (9), AND ANCILLARY FACILITIES BLKS 5, 6(4) & 8 TO EXISTING DIEPPE BARRACK ON LOT 05019M MK13 AT SEMBAWANG ROAD (MANDAI PLANNING AREA)

Drawing Title:

**BLOCK 2 - 1ST STOREY
POWER LAYOUT**

| | Initial | Date | Job ref no. |
|-------------|------------------------------|------------|-------------|
| Designed | JEFFREY | 18/10/2024 | |
| Checked | JEFFREY | 18/10/2024 | |
| Drawn | SUZY | 18/10/2024 | Filename |
| Software | CAD | | |
| Scale | 1:150 | Sources | |
| Drawing no. | D2019-00162/ELECT/BLK2/EP/01 | | |

THIS DRAWING IS COPYRIGHT
THIS DRAWING IS THE PROPERTY OF DSTA. IF FOUND, PLEASE RETURN TO
DSTA BUILDINGS AND INFRASTRUCTURE PROGRAMME CENTRE,
1 DEPOT ROAD, SINGAPORE 10879.
REPRODUCTION OF DRAWING WITHOUT THE WRITTEN PERMISSION OF DSTA IS
STRICTLY PROHIBITED. ANY UNAUTHORIZED REPRODUCTION OR POSSESSION
SHALL BE DEALT WITH UNDER THE OFFICIAL SECRETS ACT.

