


BLK 2 - LEVEL 3 DISSCUSSION ROOM AND ROOM 3
SCALE 1:100

LEGEND & SYMBOL

	65" COMMERCIAL UHD TV C/W FOLDABLE ARM BRACKET 65UR640S (LG/KOREA) DIM : 1454(W) x 838(H) x 57.7(D)mm
	TWO INPUT DTP TRANSMITTER FOR HDMI & VGA DTP T UWP 4K 232 D (EXTRON/USA) DIM : 89(W) x 107(H) x 48(D)mm

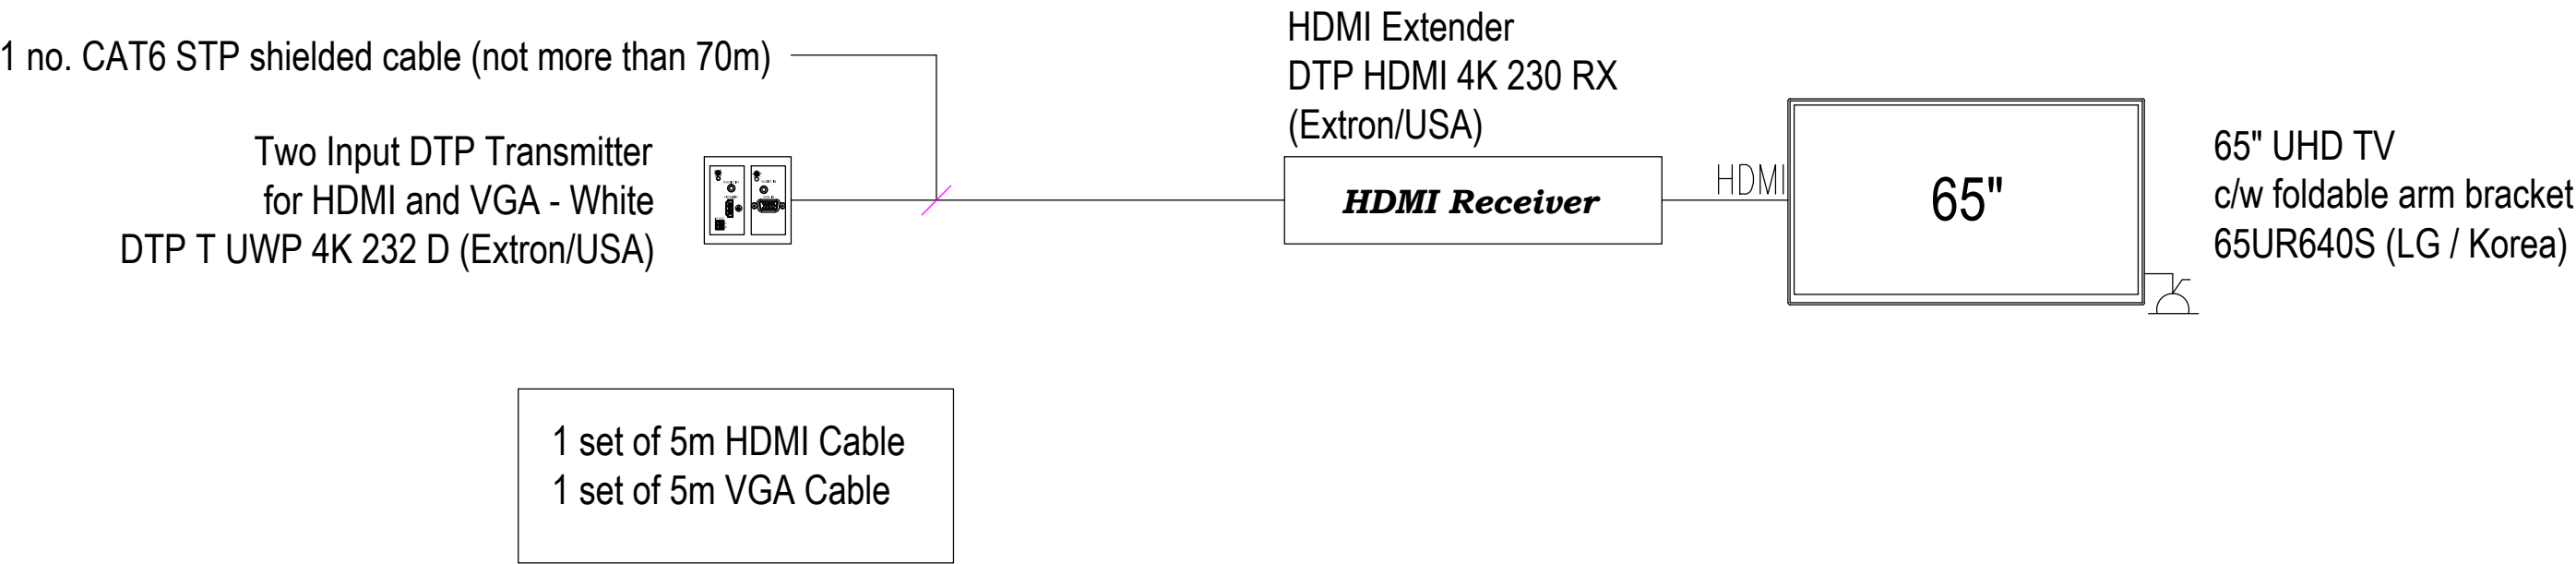

AUDIO VISUAL SYSTEM
BLK 2 - LEVEL 3 DISSCUSSION ROOM AND ROOM 3

AS BUILT DRAWING

DEVELOPER:

DSTA
Defence Science & Technology Agency

YVYNA PEH SEOH
CHIN

HCD (Army Camps)

Edmund Teo
Kuan Wei

Senior Programme Manager

D&B MAIN CONTRACTOR:

DEENN ENGINEERING PTE LTD

29 Harrison Road, Lian Beng Building, Singapore 369648
TEL: No. 6283 1468 FAX No. 6280 9360
e-mail: lianbengconstn@pacific.net.sg
Website: www.lianbeng.com.sg

ARCHITECT CONSULTANT:

ID ARCHITECTS PTE LTD

3 Harbourfront Place, #03-01
Harbourfront Tower Two
Singapore 099254
Tel: 6225 4011 Fax: 6225 4022
Email: general@idarchitects.com.sg
www.idarchitects.com.sg

STRUCTURE CONSULTANT:

TW-ASIA Consultants Pte Ltd

NO. 25, SIN MING LANE #04-137 MINDEN CITY
SINGAPORE 573972 TEL: 62916292 FAX: 62933296

M&E Consultant:

PdcConsultants Pte Ltd

23 New Industrial Road #06-03
Solstice Business Center
Singapore 536209
t: 6444 7748 f: 6444 7141
e: contact@pdcengrs.com

Sub Contractor:

CHIN SENG ENGINEERING (S) PTE LTD

33 Ubi Avenue 3, Vertex Tower B, #08-27, Singapore 408868
TEL: 6742 9392 FAX: 6742 9390

Project Title:

PROPOSED ADDITIONS OF 1 BLOCK OF 3-STOREY OFFICE BUILDING BLK 2, 1 BLOCK OF 6-STOREY ACCOMMODATION BUILDING BLK 3 (11), 1 BLOCK OF 4-STOREY ACCOMMODATION BUILDING BLK 4 (10), 1 BLOCK OF 2-STOREY TRAINING MULTIPLEX BLK 9 (6), 1 BLOCK OF MSVS BLK 10 (9), AND ANCILLARY FACILITIES BLK 5, 6(4) & 8 TO EXISTING DIEPPE BARRACK ON LOT 05019M MK13 AT SEMBAWANG ROAD (MANDAI PLANNING AREA)

Drawing Title:

AUDIO VISUAL SYSTEM
LEVEL 3 DISCUSSION ROOM

	Initial	Date	Job ref no.	
Designed	JEFFREY	08/09/2023		
Checked	JEFFREY	08/09/2023		
Drawn	KHANG	08/09/2023	Filename	
Software	CAD			
Scale	AS SHOWN		Sources	
Drawing no.			D2019-00162/ELECT/BLK2/AV/09	

THIS DRAWING IS COPYRIGHT
THIS DRAWING IS THE PROPERTY OF DSTA. IF FOUND, PLEASE RETURN TO
DSTA BUILDING AND INFRASTRUCTURE PROGRAMME CENTRE,
1 DEPOT ROAD, SINGAPORE 109679.
REPRODUCTION OF DRAWING WITHOUT THE WRITTEN PERMISSION OF DSTA BI
IS STRICTLY PROHIBITED. ANY UNAUTHORIZED REPRODUCTION OR POSSESSION
SHALL BE DEALT WITH UNDER THE OFFICIAL SECRETS ACT.