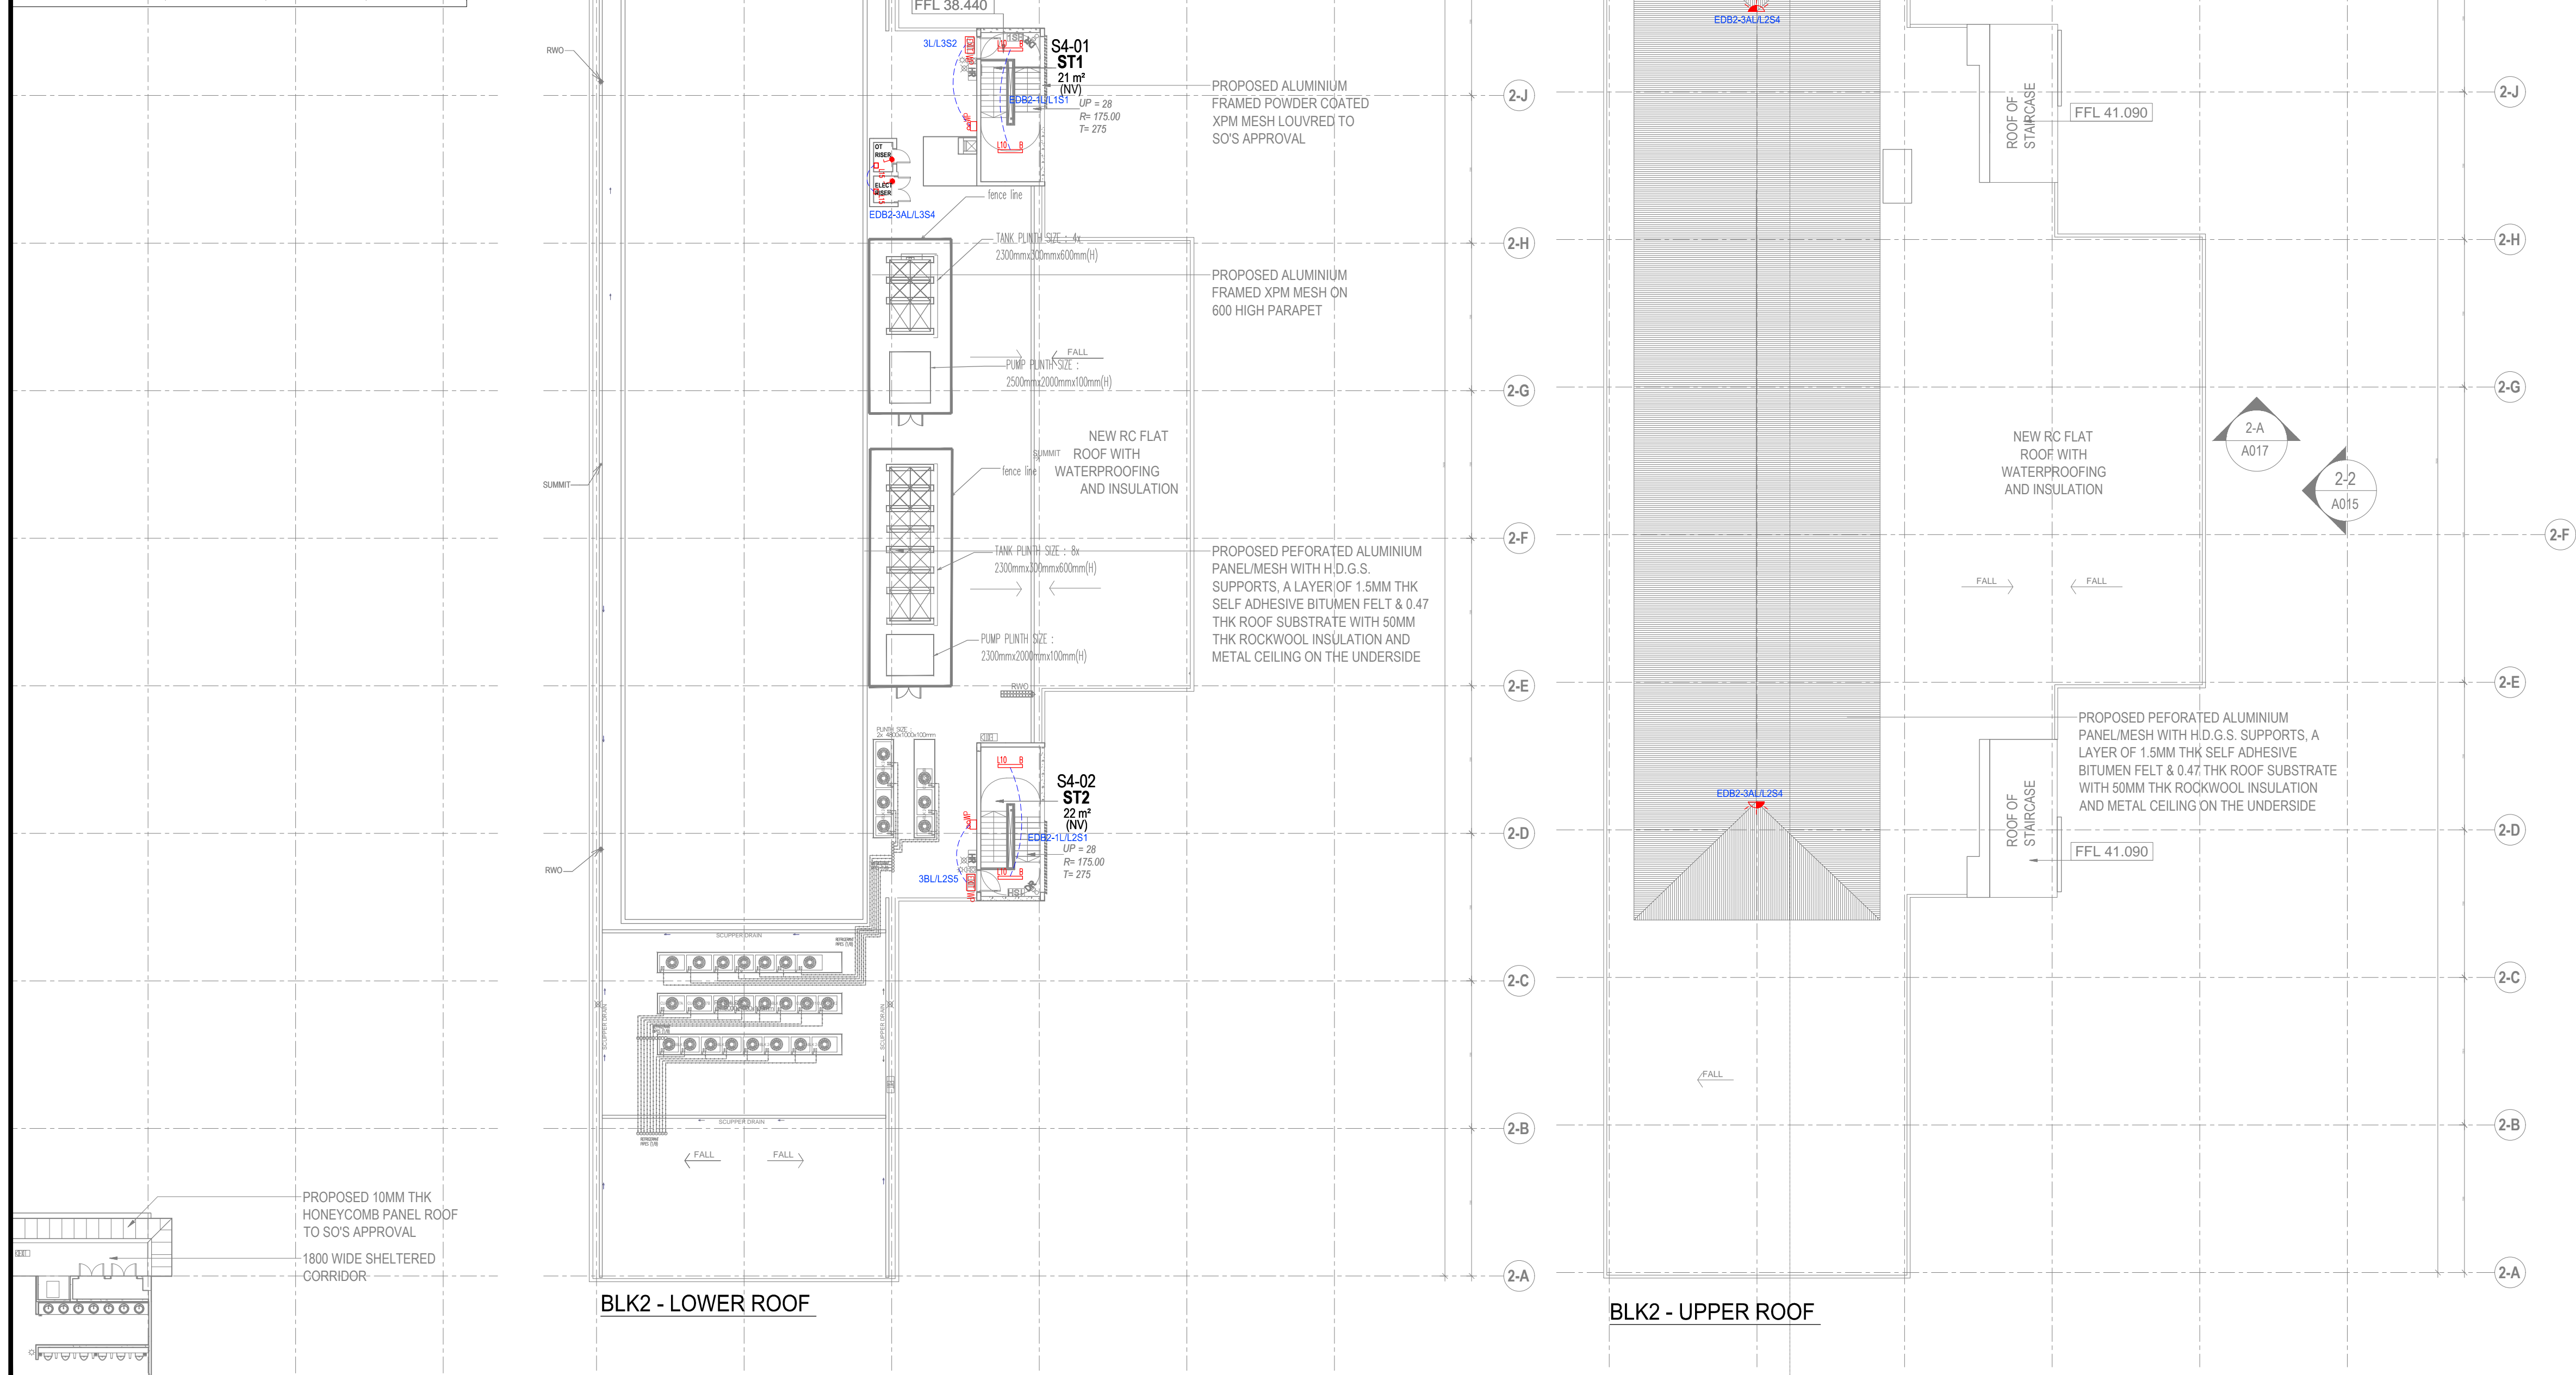


[illegible]

AS BUILT DRAWING

DEVELOPER

VYNNA PEH
SEOH CHIN

Edmund Teo
Kuan Wei
Senior Programme Manager

Project No.:	D2019-00162
--------------	-------------

D&B MAIN CONTRACTOR



DEENN ENGINEERING PTE LTD

29 Harrison Road, Lian Beng Building, Singapore 369648
TEL. No.6283 1468 FAX No. 6280 9360
e-mail : lianbengconstn@pacific.net.sg
Website: www.lianbeng.com.sg

ARCHITECT CONSULTANT

ID ARCHITECTS PTE LTD


3 HarbourFront Place, #03-01
HarbourFront Tower Two
Singapore 099254
Tel: 6225 6011 Fax: 6225 6022
Email: general@idarchitects.com.sg
www.idarchitects.com.sg

STRUCTURE CONSULTANT:

TW-ASIA Consultants Pte Ltd

NO. 28 SIN MING LANE #04-137 MIDVIEW CITY
SINGAPORE 573972 TEL : 62916292 FAX : 62932196

M&E Consultant:

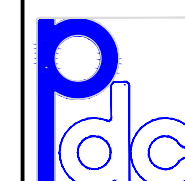

Pdc Consultants Pte Ltd

23 New Industrial Road #06-03
Solstice Business Center
Singapore 536209
t: 6444 7748 f: 6444 7141
e: contact@pdcengrs.com

Sub Contractor

CHIN SENG ENGINEERING (S) PTE LTD

33 Ubi Avenue 3, Vertex Tower B, #08-27, Singapore 408868
TEL: 6742 9392 FAX: 6742 9390

Project Title:

PROPOSED ADDITIONS OF 1 BLOCK OF 3-STOREY OFFICE BUILDING BLK 2, 1 BLOCK OF 6-STOREY ACCOMMODATION BUILDING BLK 3 (11), 1 BLOCK OF 4-STOREY ACCOMMODATION BUILDING BLK 4 (10), 1 BLOCK OF 2-STOREY TRAINING MULTIPLEX BLK 5 (6), 1 BLOCK OF MSVS BLK 10 (9), AND ANCILLARY FACILITIES BLK 5, 6/4 & 8 TO EXISTING DIEPPE BARRACK ON LOT 05019M MK13 AT SEMBAWANG ROAD (MANDAI PLANNING AREA)

Drawing Title:

BLOCK 2 - ROOF
LIGHTING LAYOUT

	Initial	Date	Job ref. no.	
Designed	JEFFREY	30/12/2024		
Checked	JEFFREY	30/12/2024		
Drawn	SUZY	30/12/2024	Filename	
Software	CAD			
Scale	1:200		Sources	

D2019-00162/ELECT/BLK2/EL/04

THIS DRAWING IS COPYRIGHT
THIS DRAWING IS THE PROPERTY OF DSTA. IF FOUND, PLEASE RETURN TO
DSTA BUILDING AND INFRASTRUCTURE PROGRAMME CENTRE,
1 DEPOT ROAD, SINGAPORE 109679.
REPRODUCTION OF DRAWING WITHOUT THE WRITTEN PERMISSION OF DSTA IS
STRICTLY PROHIBITED. ANY UNAUTHORIZED REPRODUCTION OR POSSESSION
SHALL BE DEALT WITH UNDER THE OFFICIAL SECRETS ACT.