


[illegible]

AS BUILT DRAWING

DEVELOPER:

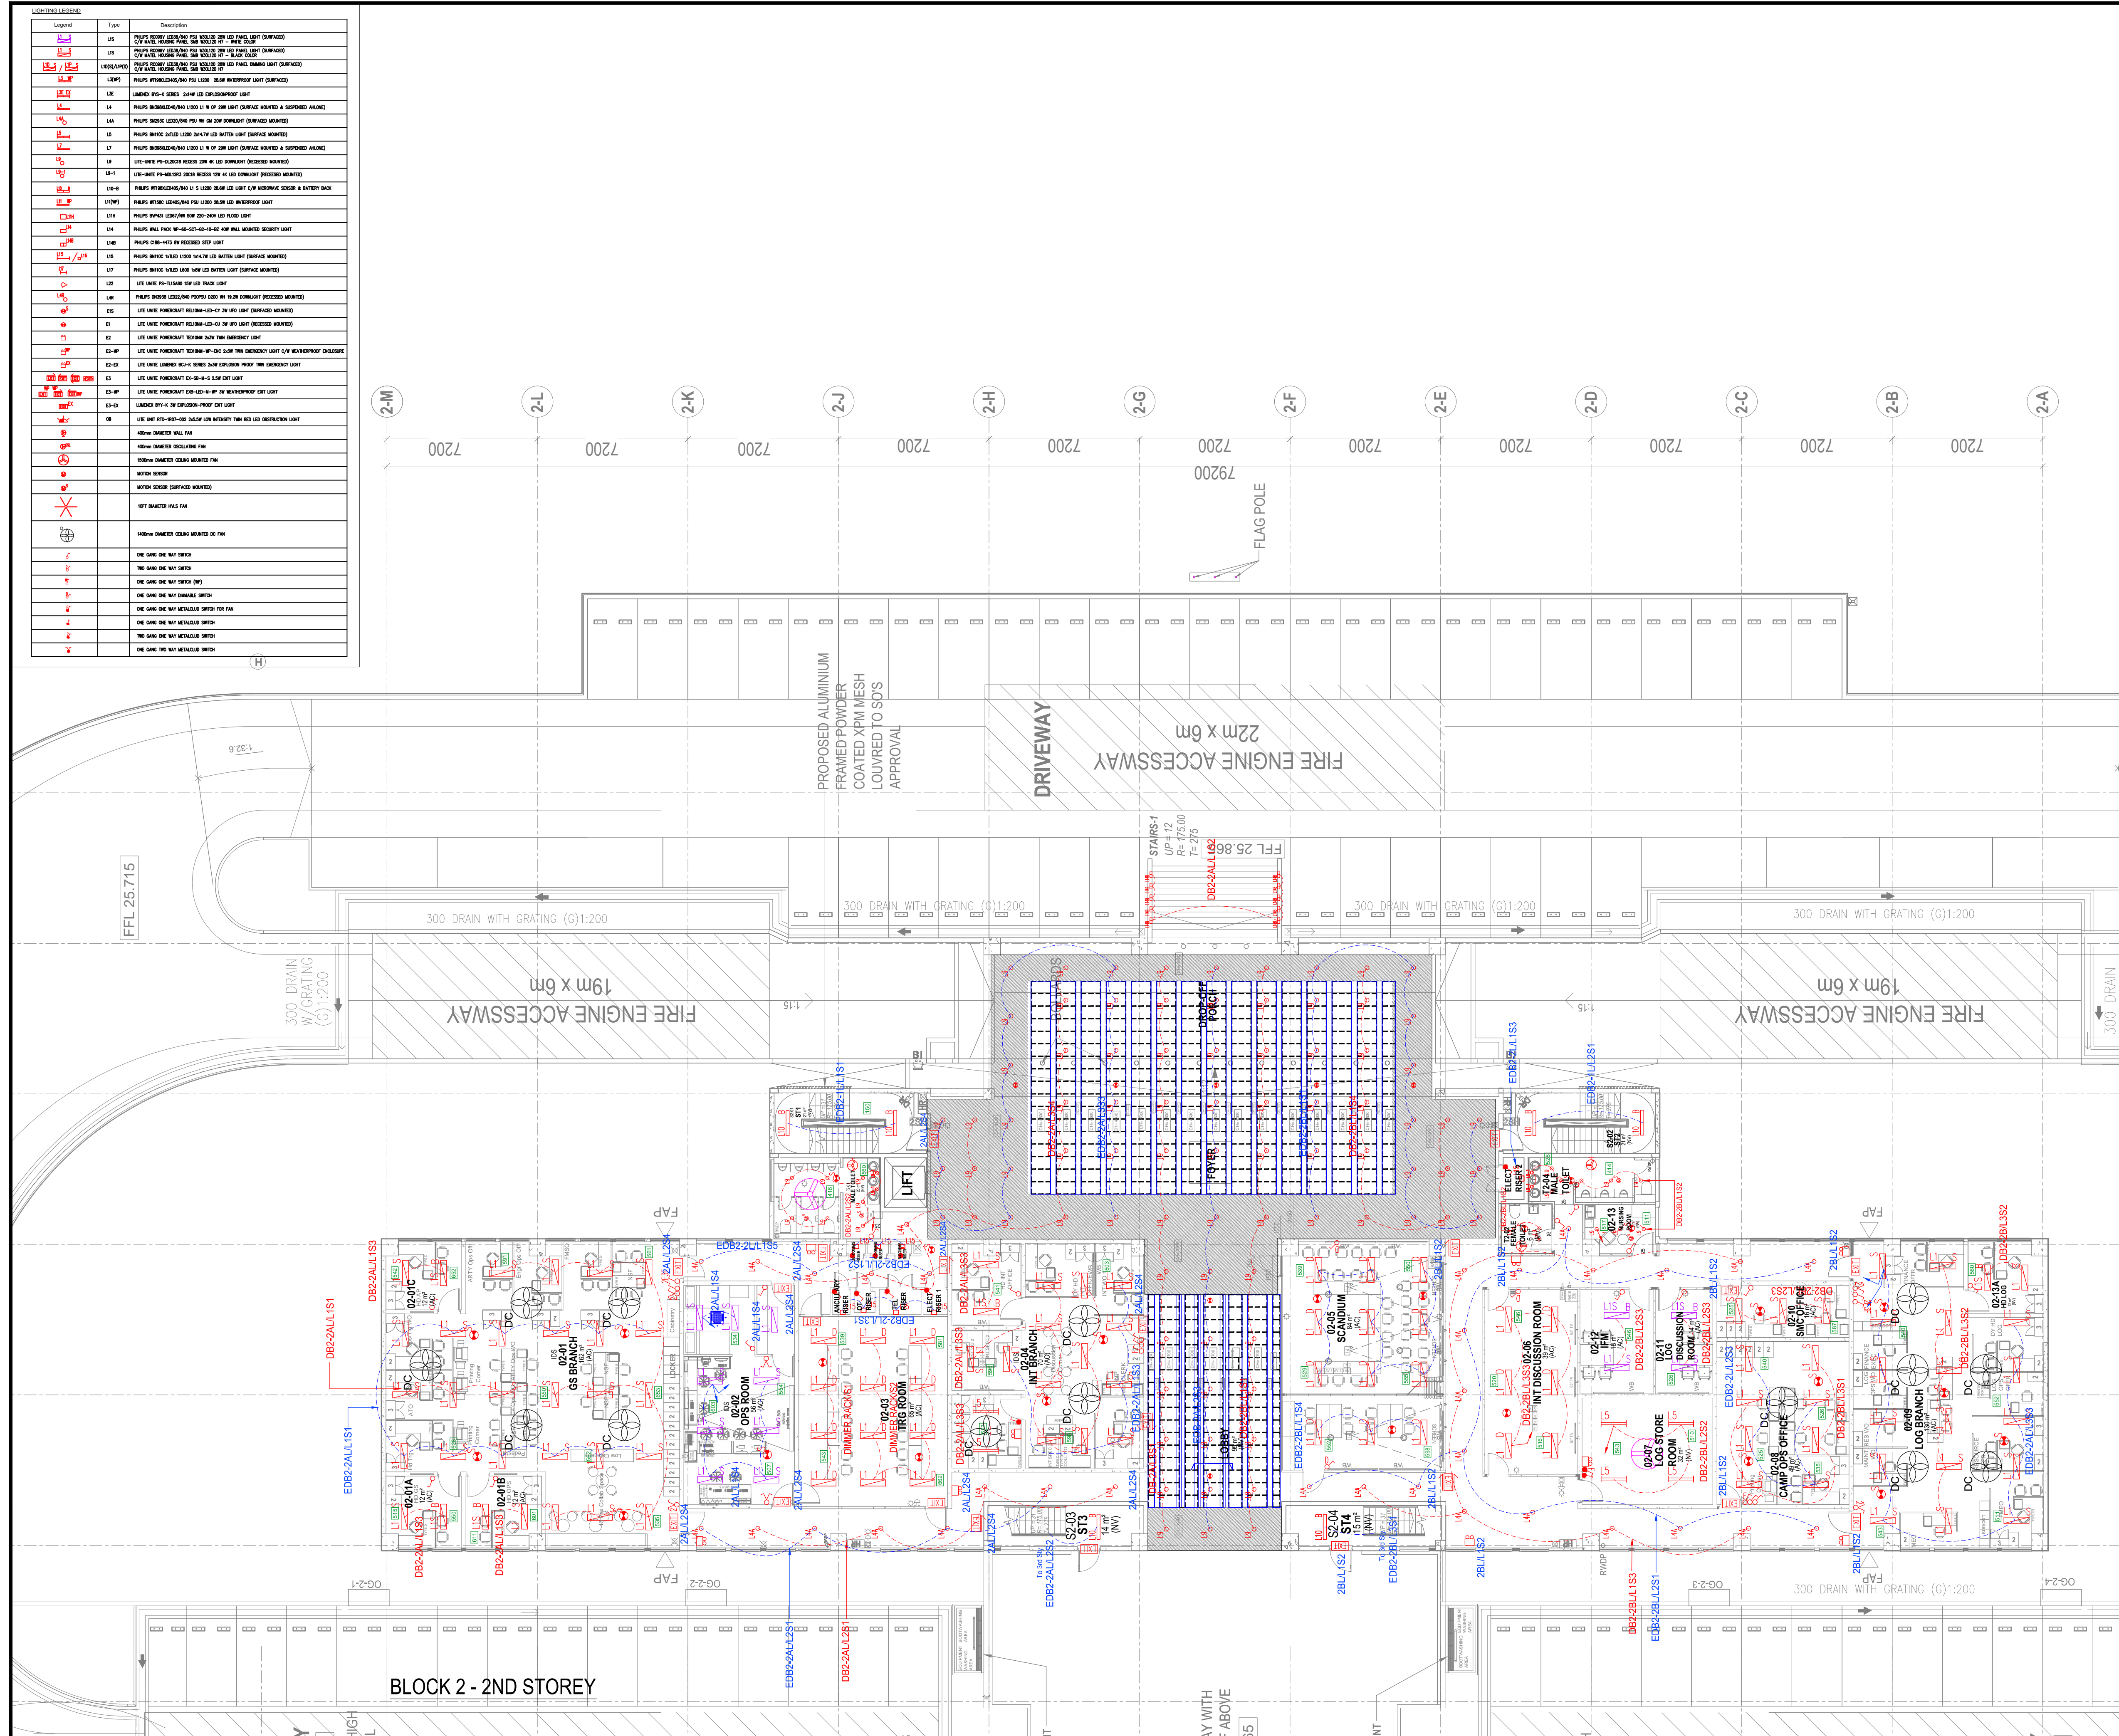

VYNNA PEH
SEOH CHIN



Edmund Teo
Kuan Wei

Senior Programme Manager
D&B MAIN CONTRACTOR;



LIANBENG ENGINEERING PTE LTD
 9 Harrison Road, Lian Beng Building , Singapore 369648
 TEL. No.6283 1468 FAX No. 6280 9360
 e-mail : lianbengconstn@pacific.net.sg
 Website: www.lianbeng.com.sg

ARCHITECT CONSULTANT:

ID ARCHITECTS PTE LTD


3 HarbourFront Place, #03-01
HarbourFront Tower Two
Singapore 099254
Tel: 6225 6011 Fax: 6225 6022
Email: general@idarchitects.com.sg
www.idarchitects.com.sg

STRUCTURE CONSULTANT:

TW-ASIA Consultants Pte Ltd

NO. 28 SIN MING LANE #04-137 MIDVIEW CITY
SINGAPORE 573972 TEL : 62916292 FAX : 62933296

M&E Consultant:

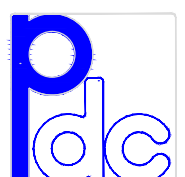

Pdc Consultants Pte Ltd

23 New Industrial Road #06-03
Solstice Business Center
Singapore 536209
t: 6444 7748 f: 6444 7141
e: contact@pdcengrs.com

Sub Contractor:

CHIN SENG ENGINEERING (S) PTE LTD

33 Ubi Avenue 3, Vertex Tower B, #08-27, Singapore 408868
TEL: 6742 9392 FAX: 6742 9390

Project Title:

PROPOSED ADDITIONS OF 1 BLOCK OF 3-STOREY OFFICE BUILDING BLK 2, 1 BLOCK OF 6-STOREY ACCOMMODATION BUILDING BLK 3 (11), 1 BLOCK OF 4-STOREY ACCOMMODATION BUILDING BLK 4 (10), 1 BLOCK OF 2-STOREY TRAINING MULTIPLEX BLK 9 (6), 1 BLOCK OF MSVS BLK 10 (9), AND ANCILLARY FACILITIES BLK 5, 6(4) & 8 TO EXISTING DIEPPE BARRACK ON LOT 05019M MK13 AT SEMBAWANG ROAD (MANDAI PLANNING AREA)

Drawing Title:

BLOCK 2 - 2ND STOREY
LIGHTING LAYOUT

	Initial	Date	Job ref no.	
Designed	JEFFREY	30/12/2024		
Checked	JEFFREY	30/12/2024		
Drawn	SUZY	30/12/2024	Filename	
Software	CAD			
Scale	1:150		Sources	

D2019-00162/ELECT/BLK2/EL/02

THIS DRAWING IS COPYRIGHT
THIS DRAWING IS THE PROPERTY OF DSTA. IF FOUND, PLEASE RETURN TO
DSTA BUILDING AND INFRASTRUCTURE PROGRAMME CENTRE,
1 DEPOT ROAD, SINGAPORE 109679.
REPRODUCTION OF DRAWING WITHOUT THE WRITTEN PERMISSION OF DSTA BI
IS STRICTLY PROHIBITED. ANY UNAUTHORIZED REPRODUCTION OR POSSESSION
SHALL BE DEALT WITH UNDER THE OFFICIAL SECRETS ACT.