

# AS BUILT DRAWING

DEVELOPER:



VYNNA PEH SEOH  
CHIN

HCD (Army Camps)

Edmund Teo  
Kuan Wei  
Senior Programme Manager

Project No.:  
D2019-00162

D&B MAIN CONTRACTOR:

**DEENN ENGINEERING PTE LTD**  
29 Harrison Road, Lion Beng Building, Singapore 369648  
TEL: No.6283 1468 FAX No. 6280 9360  
e-mail : lionbengconstn@pacific.net.sg  
Website: www.lionbeng.com.sg

ARCHITECT CONSULTANT:

**ID ARCHITECTS PTE LTD**  
3 Harbourfront Place, #03-01  
Harbourfront Tower Two  
Singapore 099254  
Tel: 6225 6011 Fax: 6225 6022  
Email: general@idarchitects.com.sg  
www.idarchitects.com.sg



STRUCTURE CONSULTANT:

**TW-ASIA Consultants Pte Ltd**

10, 28, 51, 111, 115, 116, 117, 999, 1000

M&E Consultant:

**Pdc Consultants Pte Ltd**  
23 New Industrial Road, #06-03  
Solstice Business Center  
Singapore 536209  
t: 6444 7748 f: 6444 7141  
e: contact@pdcengrs.com

Sub Contractor:

**CHIN SENG ENGINEERING (S) PTE LTD**  
33 Ubi Avenue 3, Vertex Tower B, #08-27, Singapore 408868  
TEL: 6742 9392 FAX: 6742 9390

Project Title:

PROPOSED ADDITIONS OF 1 BLOCK OF 3-STORY OFFICE BUILDING BLK 2, 1 BLOCK OF 6-STORY ACCOMMODATION BUILDING BLK 3 (11), 1 BLOCK OF 4-STORY ACCOMMODATION BUILDING BLK 4 (10), 1 BLOCK OF 2-STORY TRAINING MULTIPLEX BLK 9 (6), 1 BLOCK OF MSVS BLK 10 (9), AND ANCILLARY FACILITIES BLK 5, 6(4) & 8 TO EXISTING DIEPPE BARRACK ON LOT 05019M MK13 AT SEMBAWANG ROAD (MANDAI PLANNING AREA)

Drawing Title:

**AUDIO VISUAL SYSTEM**  
BLOCK 2 - LEVEL 3 CONFERENCE ROOM 03-09


Designed	Initial	Date	Job ref no.
Checked	JEFFREY	08/09/2023	
Drawn	JEFFREY	08/09/2023	Filename
Software	KHANG	08/09/2023	
Scale	AS SHOWN	Sources	
Drawing no.			

THIS DRAWING IS COPYRIGHT  
THIS DRAWING IS THE PROPERTY OF DSTA. IF FOUND, PLEASE RETURN TO  
DSTA BUILDING AND INFRASTRUCTURE PROGRAMME CENTRE,  
1 DEPOT ROAD, SINGAPORE 109679.  
REPRODUCTION OF DRAWING WITHOUT THE WRITTEN PERMISSION OF DSTA IS  
STRICTLY PROHIBITED. ANY UNAUTHORIZED REPRODUCTION OR POSSESSION  
SHALL BE DEALT WITH UNDER THE OFFICIAL SECRETS ACT.

## LEGEND & SYMBOL

P1	LASER PROJECTOR C/W MTG BRACKET 5200 ANSI LUMENS ; WUXGA RESOLUTION EB-L520U (EPSON/JAPAN) DIM : 440(W) x 122(H) x 304(D)mm
MS	MOTORISED SCREEN - 3000(W) X 3000(H) IMAGE SIZE : 3000(W) X 1685(H), 16:9 CLASS 10 (LAV/SINGAPORE) CASING DIM : 3138(W) x 156(H) x 134(D)mm
	5" FULL RANGE CEILING SPEAKER, 30W/100V F-2322C (TOA/JAPAN) DIM : 230(DIA) x 200(H)mm
AV 1	TWO INPUT DTP TRANSMITTER FOR HDMI & VGA DTP T UWP 4K 232 D (EXTRON/USA) DIM : 89(W) x 107(H) x 48(D)mm
LAN	LAN RECEPTACLE SINGLE GANG SIZE
S	UP/DOWN SWITCH SINGLE GANG SIZE
AV 2	DTP RECEIVER FOR HDMI DTP R HWP 4K 231 D (EXTRON/USA) DIM : 43(W) x 107(H) x 55(D)mm
RACK 22U	19" EQUIPMENT RACK DIM : 600(W) x 1180-22U(H) x 600(D)mm
	13A 1-GANG SWITCH SOCKET OUTLET
20A	20A ISOLATOR
TP	7" WIRED TOUCHPANEL TLP PRO 725T (EXTRON/USA) DIM : 181(W) x 122(H) x 90(D)mm

BLK 2 - LEVEL 3 CONFERENCE ROOM 03-09  
SCALE 1:100

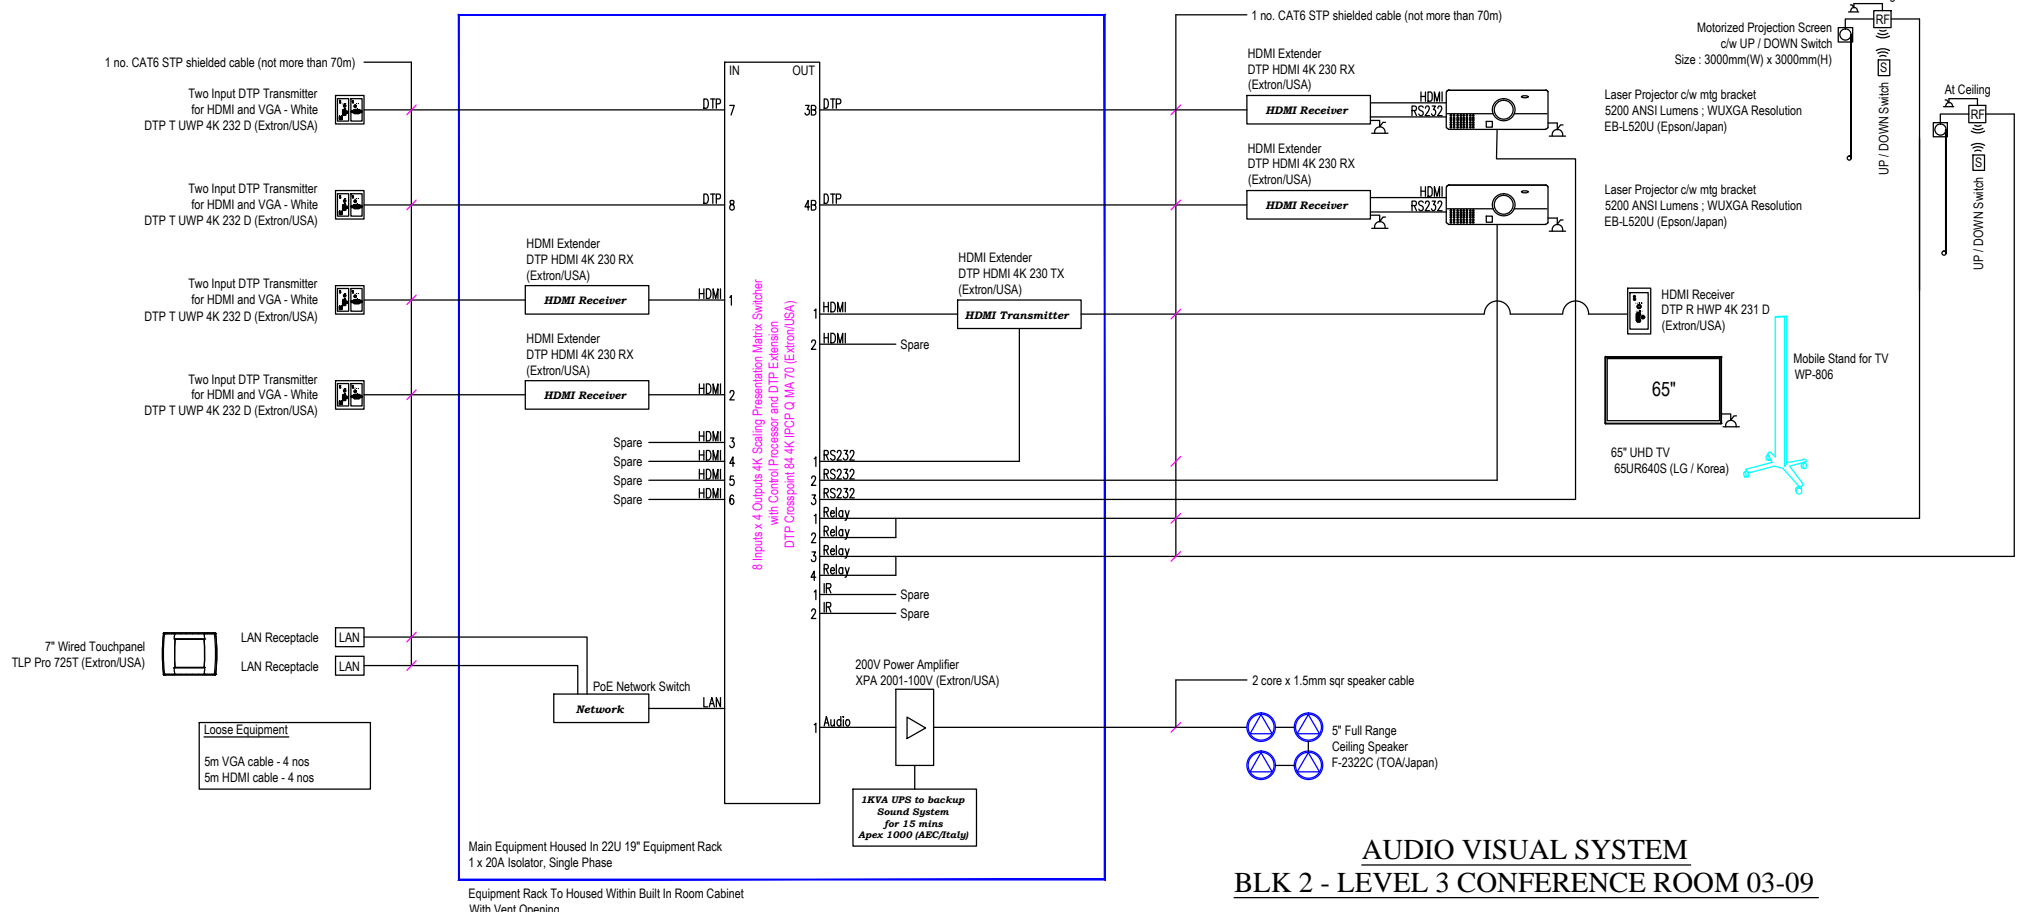

**AUDIO VISUAL SYSTEM**  
BLK 2 - LEVEL 3 CONFERENCE ROOM 03-09