

AS BUILT DRAWING

DEVELOPER:



YVYNA PEH
SEOH CHIN



Edmund Teo
Kuan Wei

Project No.:
D2019-00162

D&B MAIN CONTRACTOR:

DEENN ENGINEERING PTE LTD
29 Harrison Road, Lian Beng Building , Singapore 369648
TEL. No.6283 1468 FAX No. 6280 9360
e-mail : lianbengconstn@pacific.net.sg
Website: www.lianbeng.com.sg

ARCHITECT CONSULTANT:

ID ARCHITECTS PTE LTD
3 Harbourfront Place, #03-01
Harbourfront Tower Two
Singapore 099254
Tel: 6225 4011 Fax: 6225 4022
Email: general@idarchitects.com.sg
www.idarchitects.com.sg



STRUCTURE CONSULTANT:

TW-ASIA Consultants Pte Ltd

NO. 25 SUN MING LANE #04-137 MINDEN CITY
SINGAPORE 573972 TEL : 62916292 FAX : 62933296

M&E Consultant:



PdcConsultants Pte Ltd

23 New Industrial Road #06-03
Solstice Business Center
Singapore 536209
t : 6444 7748 f: 6444 7141
e: contact@pdcengrs.com

Sub Contractor:

CHIN SENG ENGINEERING (S) PTE LTD

33 Ubi Avenue 3, Vertex Tower B, #08-27, Singapore 408668
TEL: 6742 9392 FAX: 6742 9390

Project Title:

PROPOSED ADDITIONS OF 1 BLOCK OF 3-STOREY OFFICE BUILDING BLK 2, 1 BLOCK OF 6-STOREY ACCOMMODATION BUILDING BLK 3 (11), 1 BLOCK OF 4-STOREY ACCOMMODATION BUILDING BLK 4 (10), 1 BLOCK OF 2-STOREY TRAINING MULTIPLEX BLK 9 (6), 1 BLOCK OF MSVS BLK 10 (9), AND ANCILLARY FACILITIES BLK 5, 6(4) & 8 TO EXISTING DIEPPE BARRACK ON LOT 05019M MK13 AT SEMBAWANG ROAD (MANDAI PLANNING AREA)

Drawing Title:

**BLOCK 2 - 2ND STOREY
EVC/PA LAYOUT**

Initial Date Job ref no.

Designed JEFFREY 08/09/2023

Checked JEFFREY 08/09/2023

Drawn KHANG 08/09/2023 Filename

Software CAD


Scale 1:250 Sources

Drawing no.

D2019-00162/ELECT/BLK2/PA/02

THIS DRAWING IS COPYRIGHT

THIS DRAWING IS THE PROPERTY OF DSTA. IF FOUND, PLEASE RETURN TO
DSTA BUILDING AND INFRASTRUCTURE PROGRAMME CENTRE,
1 DEPOT ROAD, SINGAPORE 10879.
REPRODUCTION OF DRAWING WITHOUT THE WRITTEN PERMISSION OF DSTA IS
STRICTLY PROHIBITED. ANY UNAUTHORIZED REPRODUCTION OR POSSESSION
SHALL BE DEALT WITH UNDER THE OFFICIAL SECRETS ACT.

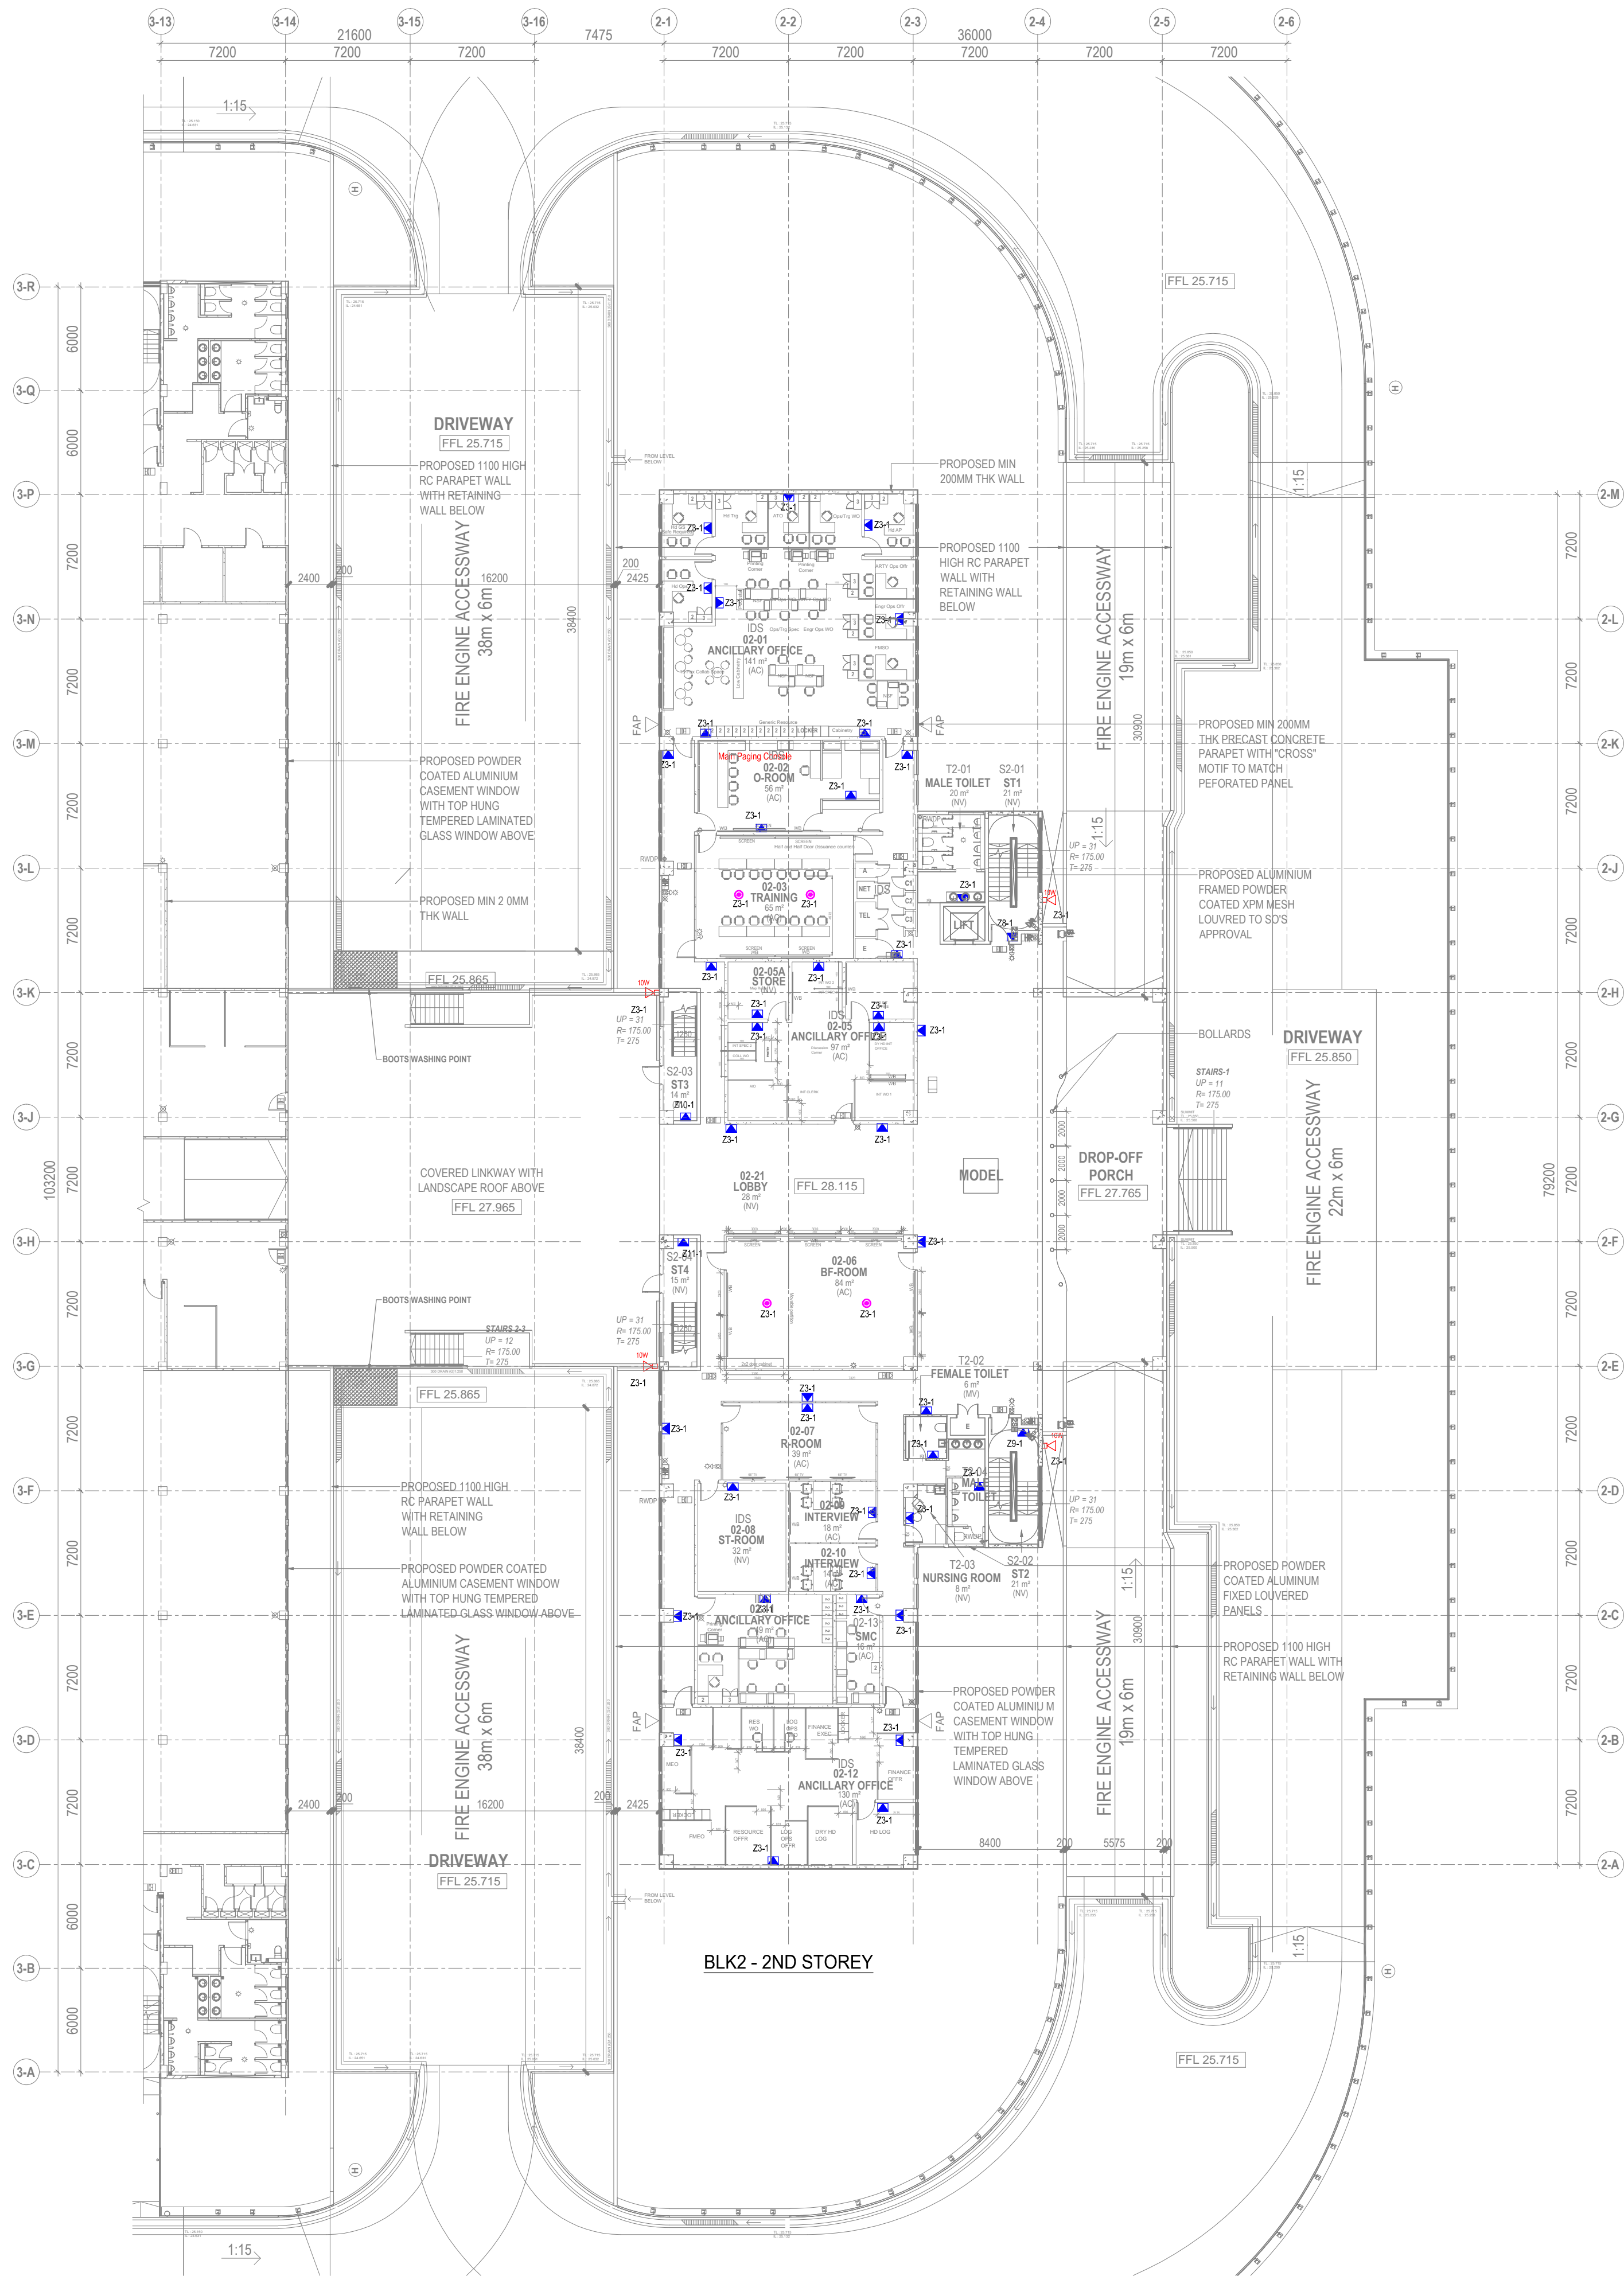

LEGEND:

EVC/PUBLIC ADDRESS SYSTEM



6W FLUSH-MOUNTED CEILING SPEAKER
C/W ENCLOSURE
MADE : TOA (JAPAN)
MODEL : PC-648R / HY-BC648
TAPPED Ø 3W



6W SURFACE-MOUNTED BOX SPEAKER
MADE : TOA (JAPAN)
MODEL : BS-633A
TAPPED Ø 3W



10W SURFACE-MOUNTED HORN SPEAKER, IP65
MADE : TOA (JAPAN)
MODEL : SC-610W
TAPPED Ø 10W

LEGEND:

FIREMAN INTERCOM SYSTEM



RED REMOTE HANDSET COMPLETED WITH BASE PLATE,
FACE PLATE, BACK BOX, SLAM LOCK TYPE
MADE : EVC 7750/S/SL/F1
MADE : EVC (SINGAPORE)
DIM : 182(W) X 360(H) X 92(D)MM