


BLK 2- 1ST STOREY PLAN
SCALE 1:150

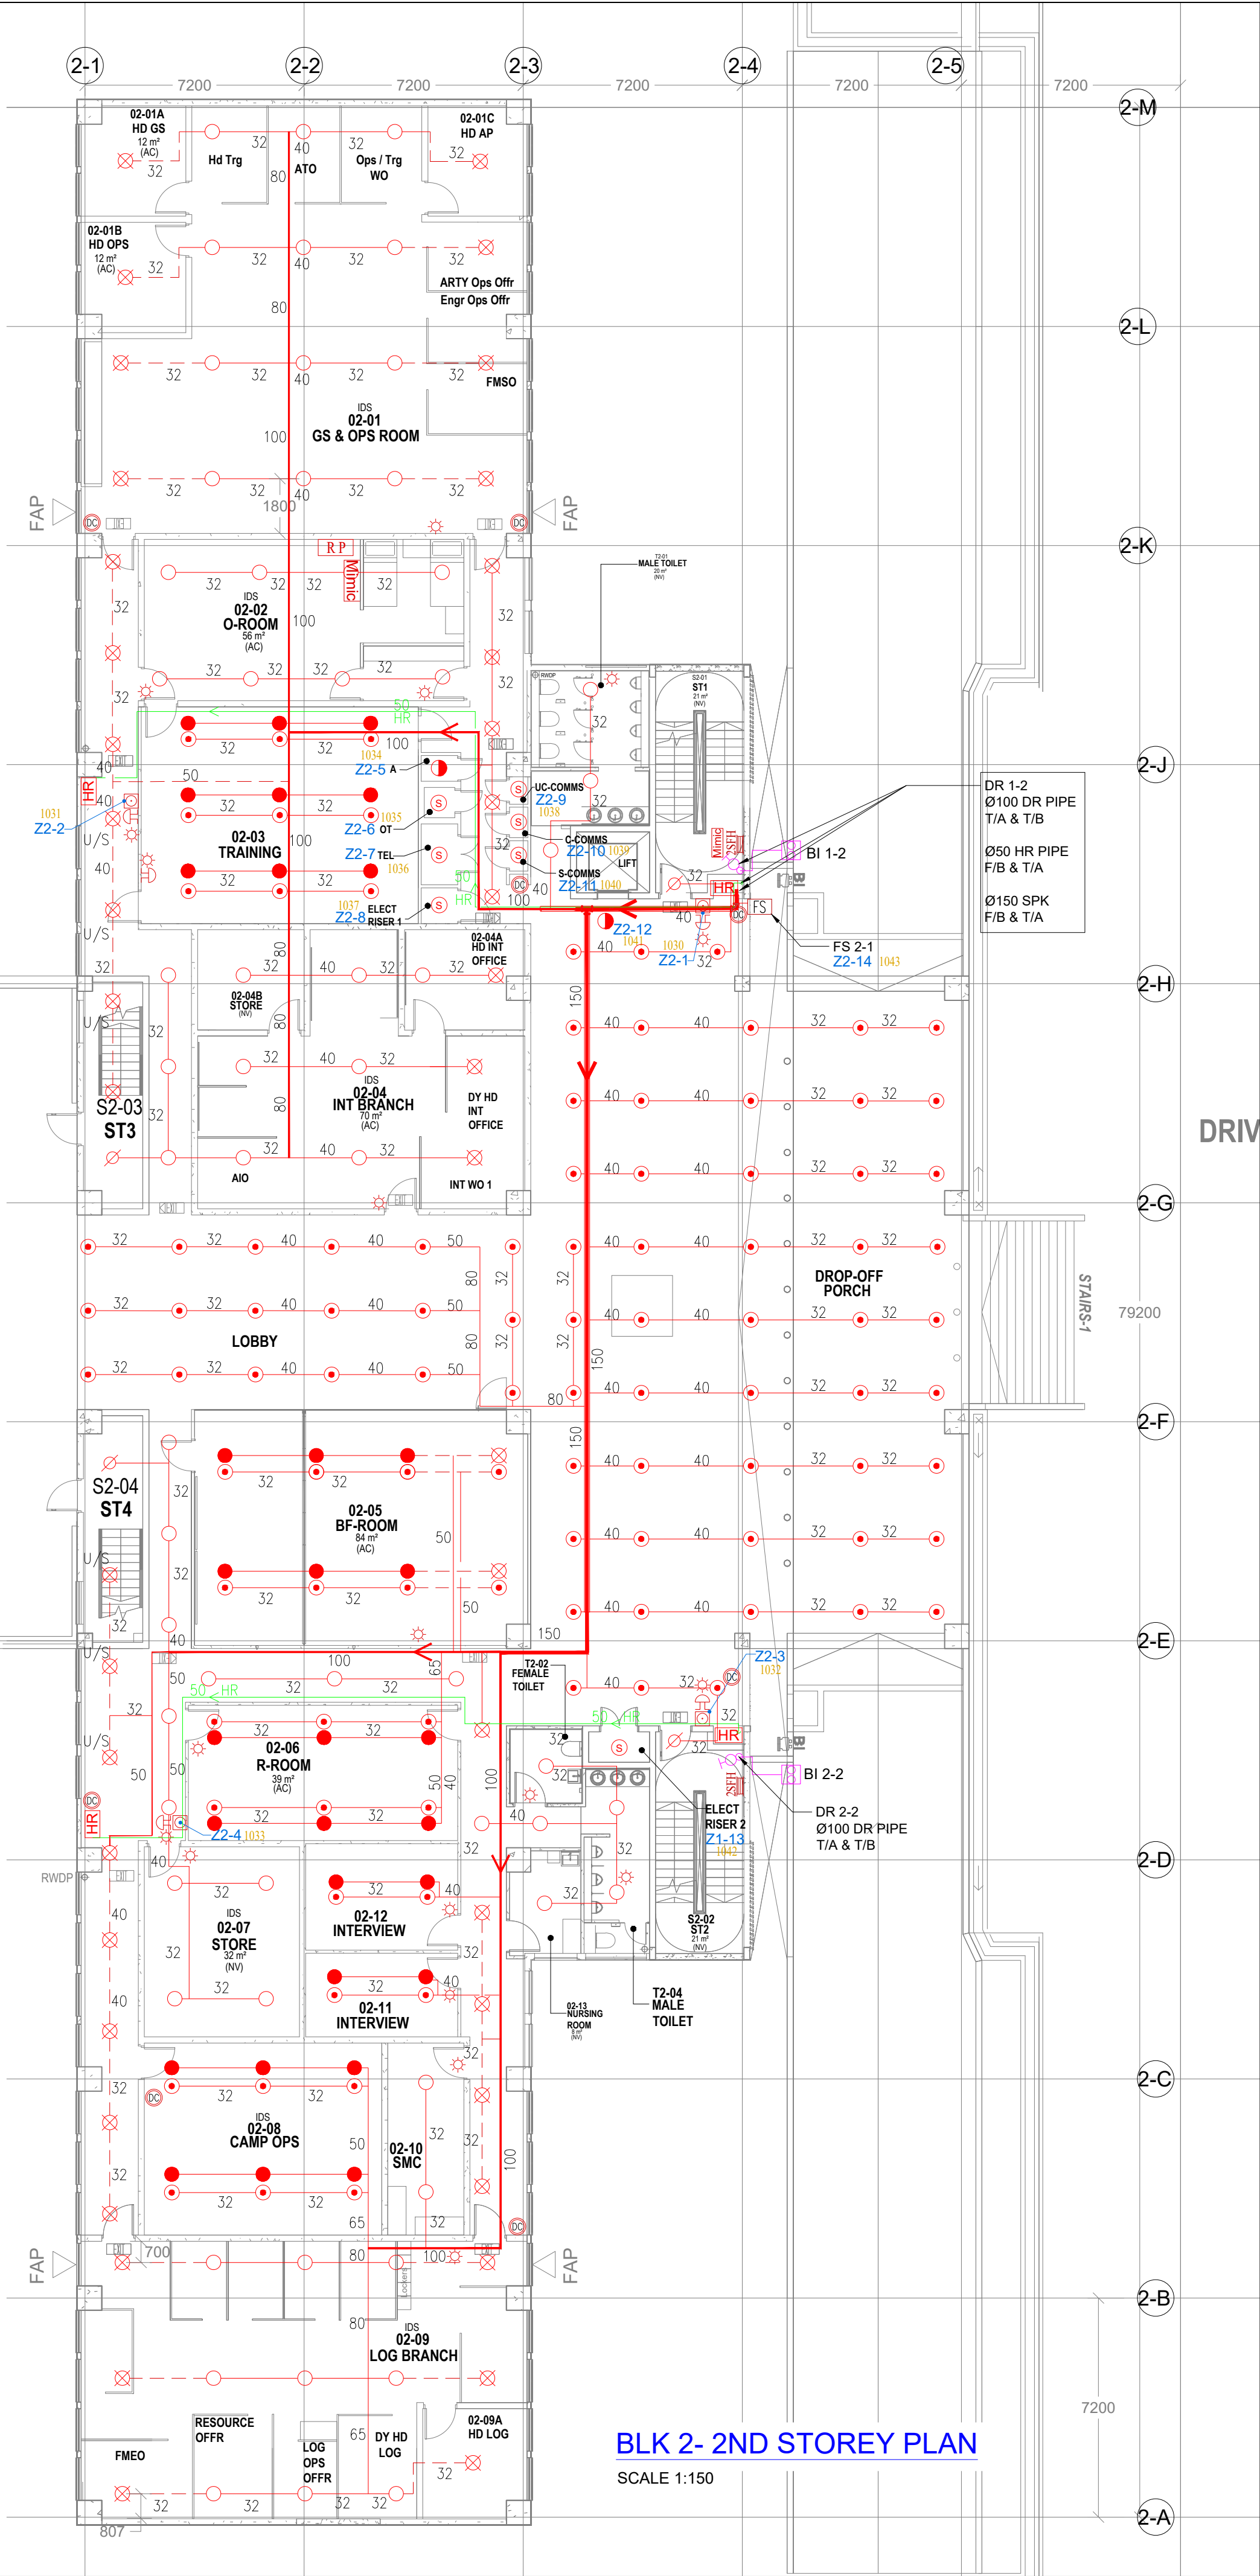

BLK 2- 2ND STOREY PLAN
SCALE 1:150

- LEGEND**
- SAP SUB ALARM PANEL
 - R.P REPEATER PANEL
 - MIMIC MIMIC PANEL
 - FIRE ALARM BELL
 - MANUAL CALL POINT
 - STROBE LIGHT
 - SMOKE DETECTOR
 - HEAT DETECTOR
 - HOSEREEL C/W CABINET
 - HOSEREEL DRUM
 - FIRE EXTINGUISHER
 - EXPOSED SPK HEAD
 - U/BEAM SPK HEAD
 - U/STAIRCSAE SPK HEAD
 - CUT OFF SPK
 - ROYAL FLUSH SPK HEAD
 - CONCEALED SPK HEAD
 - 141°C SIDEWALL SPK
 - DRY RISER LANDING VALVE
 - STAND BY HOSE
 - FM200 PANEL
 - FLOW SWITCH
 - 2-WAY BREECHING INLET
 - SPRINKLER MAIN PIPE
 - HOSEREEL PIPE
 - GRAPHIC MANAGEMENT SYSTEM

AS-BUILT DRAWING

Project Ref. No. : A2105-00599-2022

PEH SEOH CHIN
HD (Army Camps)

EDMUND TEO KUAN WEI
Senior Programme Manager

D&B Main Contractor:

DEENN ENGINEERING PTE LTD
29 Harrison Road, Lian Beng Building, Singapore 369648
TEL No. 6283 1468 FAX No. 6280 9360
e-mail : lianbengconstr@pacific.net.sg
Website: www.lianbeng.com.sg

Structure:

TW-ASIA Consultants Pte Ltd
NO. 28 SIN MING LANE #04-137 MIDVIEW CITY
SINGAPORE 573972 TEL : 62916292 FAX : 62932196

M&E Consultant:

PdcConsultants Pte Ltd
23 New Industrial Road #06-03
Solstice Business Center
Singapore 536209
t: 6444 7748 f: 6444 7141
e: contact@pdcengrs.com

Sub Contractor:

NORTHWAY FIRE PROTECTION PTE LTD
BLK 2 DEFU LANE 10, #04-523
SINGAPORE 539183
TEL : 6285 2846 FAX : 6285 3409
EMAIL : northway_fire@singnet.com.sg

Project No.:

D2019-00162

Project Title:

PROPOSED ADDITIONS OF 1 BLOCK OF 3-STORY OFFICE BUILDING (BLK 2), 1 BLOCK OF 6-STORY ACCOMMODATION BUILDING (BLK 3), 1 BLOCK OF 4-STORY ACCOMMODATION BUILDING (BLK 4), 1 BLOCK OF 2-STORY TRAINING MULTIPLEX (BLK 9), 1 BLOCK OF MSVS (BLK 10), AND ANCILLARY FACILITIES (BLK 5, 6 & 8) TO EXISTING DIEPPE BARRACK ON LOT 05019M MK13 AT SEMBAWANG ROAD (MANDAI PLANNING AREA)

Drawing title:

FIRE PROTECTION SERVICES
BLK 2
1ST & 2ND STOREY PLAN

Initial	Date	Scale	1:150
Drawn THU ZAR	18/12/24	Scale	1:150
Checked ZIN KO	18/12/24	Software	AUTO CAD
Drawing no.:	D2019-00162/NWFP-02-02	Revision no.:	0