


Ø100 uPVC VS T/A - Ø100 uPVC MDS T/A AS VS - Ø100 uPVC SDS T/A AS VS -ø100 uPVC MDS T/B /- Ø100 uPVC SDS T/B ST1 **UP** = 28 ø100 uPVC SWP T= 275 ø100 uPVC SWP ø100 uPVC SWP

> BLOW -UP PLAN 1-1 Scale: 1:50

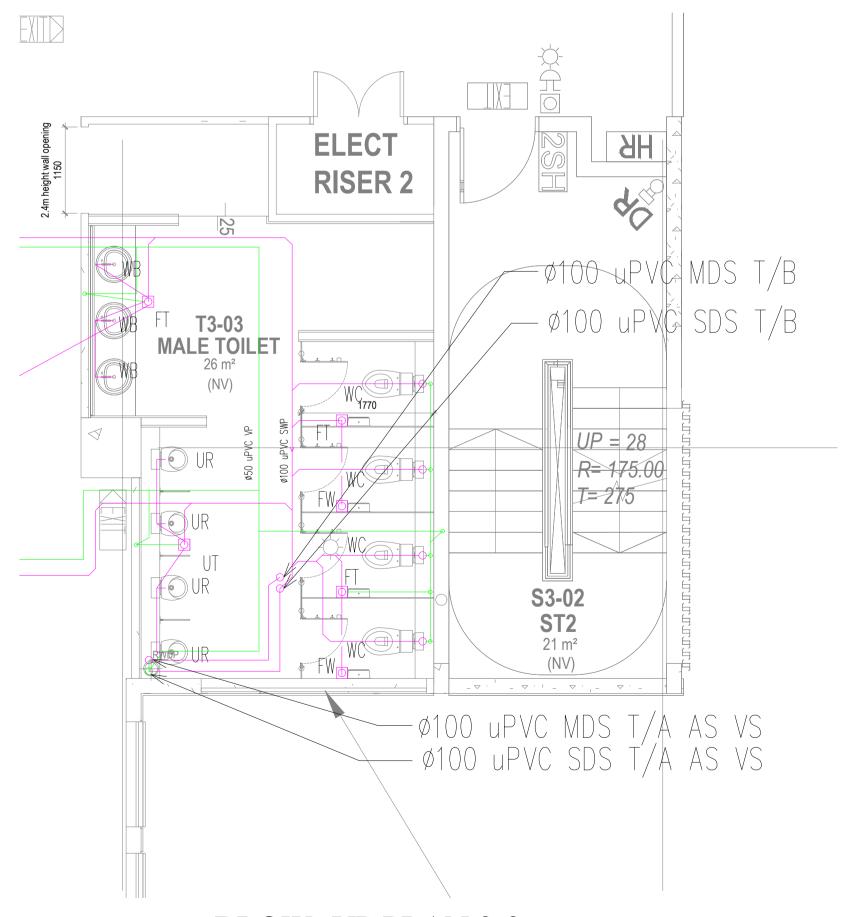

BLOW -UP PLAN 2-2

Scale: 1:50

AS-BUILT DRAWING

Project Ref. No.: A2105-00599-2022

PdcConsultants Pte Ltd

□ NO EXCEPTION TAKEN □ MAKE CORRECTIONS NOTED PRIOR TO GENERAL US □ TO REVISE & RESUBMIT □ REJECTED & RESUBMIT

EDMUND TEO KUAN WEI Senior Programme Manager

&B Main Contractor:

DEENN ENGINEERING PTE LTD

29 Harrison Road, Lian Beng Building , Singapore 369648 TEL. No.6283 1468 FAX No. 6280 9360 e-mail : lianbengconstn@pacific.net.sg

Website: www.lianbeng.com.sg

Architect:

ID ARCHITECTS PTE LTD 3 HarbourFront Place, #03-01, HarbourFront Tower Two, Singapore 099254 Tel:6225 6011 Fax:6225 6022

general@idarchitects.com.sg www.idarchitects.com.sg

Paya Lebar Square

TW—ASIA Consultants Pte Ltd

NO. 28 SIN MING LANE #04-137 MIDVIEW CITY SINGAPORE 573972 TEL": 62916292 FAX: 62932196



Tel:6444 6855 FAX : 6444 7378



D2019-00162

roject Title:

PROPOSED ADDITIONS OF 1 BLOCK OF 3-STOREY OFFICE BUILDING BLK 2, 1 BLOCK OF 6-STOREY ACCOMMODATION BUILDING BLK 3 (11), 1 BLOCK OF 4-STOREY ACCOMMODATION BUILDING BLK 4 (10), 1 BLOCK OF 2-STOREY TRAINING MULTIPLEX BLK 9 (6), 1 BLOCK OF MSVS BLK 10 (9), AND ANCILLARY FACILITIES BLK 5, 6(4) & 8 TO EXISTING DIEPPE BARRACK ON LOT 05019M MK13 AT SEMBAWANG ROAD (MANDAI PLANNING AREA)

BLK 2 3RD STOREY SANITARY DRAWING

| | Initial | Date | | |
|----------------------------|---------|------------|----------|---------------|
| Drawn | SAN | 15.08.2024 | Scale | AS SHOWN |
| Checked | TOMMY | 15.08.2024 | Software | C AD |
| Drawing no.: | | | | Revision no.: |
| D2019-00162/WT/LB/BLK2/S03 | | | | |

THIS DRAWING IS COPYRIGHT THIS DRAWING IS THE PROPERTY OF DSTA. IF FOUND, PLEASE RETURN TO DSTA BUILDING AND INFRASTRUCTURE PROGRAMME CENTRE, 1 DEPOT ROAD,

SINGAPORE 109679. REPRODUCTION OF DRAWING WITHOUT THE WRITTEN PERMISSION OF DSTA BI IS STRICTLY PROHIBITED. ANY UNAUTHORIZED REPRODUCTION OR POSSESSION SHALL BE DEALT WITH UNDER THE OFFICIAL SECRETS ACT.