 DEENN Engineering Pte Ltd (A member of Lian Beng Group Ltd) 29 Harrison Road, Lian Beng Building Singapore 369648 Tel: 6283 1468 Fax: 6280 9360		Ref No	DE-DB-BLK 2-FPS-T&C-003	
		Date	11/09/2024	
Project : D2019-00162		To: Resident Engineer/ RTO (M&E)		
<u>REQUEST FOR INSPECTION OF M&E WORKS</u> We have checked and confirmed that the following works is completed and in order for your inspection				
Type of Activity (Tick One Only)		<input type="checkbox"/> Slab Casting <input type="checkbox"/> Services in Wall	<input type="checkbox"/> Service Risers <input type="checkbox"/> Functional Test	<input type="checkbox"/> Final Inspection <input type="checkbox"/> Others
Hose reel system water throw Test				
Type of Services (Tick One Only)		<input type="checkbox"/> Electrical / Tel / SCV <input type="checkbox"/> Plumbing / Sanitary <input type="checkbox"/> Swimming Pool	<input type="checkbox"/> Gas Installation <input checked="" type="checkbox"/> Fire Protection <input type="checkbox"/> Lift Installation	<input type="checkbox"/> ACMV <input type="checkbox"/> Others
LOCATION		BLK 2		
Gridline		Level 1 to Roof		
Drawing Ref: D2019-00162/NWFP-02-04		Revision 01		No. of Attachment
1st Inspection		Passed / Failed		
Date/ Time Submitted	11/09/2024	9:00 am	OK/	
Date/ Time Requested	11/09/2024	10:00 am		
Inspection Date	Time started			
	Time ended			
Name and signature of Contractors representative				
Name and signature of a Resident Technical Officer (M&E)				
2nd Inspection		Passed / Failed		
Date/ Time Submitted			OK/	
Date/ Time Requested				
Inspection Date	Time started			
	Time ended			
Name and signature of Contractors representative				
Name and signature of a Resident Technical Officer (M&E)				
3rd Inspection		Passed / Failed		
Date/ Time Submitted			OK/	
Date/ Time Requested				
Inspection Date	Time started			
	Time ended			
Name and signature of Contractors representative				
Name and signature of a Resident Technical Officer (M&E)				



北威消防私人有限公司
NORTHWAY FIRE PROTECTION PTE LTD

BLK 2 DEFU LANE 10 #04-523 SINGAPORE 539183
TEL: 6285 2846 FAX: 6285 3409 Email: northway_fire@singnet.com.sg
Reg. No: 200413523K • GST No: 20-0413523-K

NORTHWAY FIRE PROTECTION PTE LTD

PROJECT :

TRADE : FIRE PROTECTION SERVICES

FIRE HOSEREEL THROW TEST REPORT

SYSTEM : FIRE HOSEREEL SYSTEM

REF. NO. :

LOCATION : D2019-00162

DATE :

DWG NO. : D2019-00152 / NWFP-02-04

SHEET NO. :

S/N	LEVEL	LOCATION	THROW DISTANCE (meters)	REMARKS
1.	Level 1	Blk 2 - Corridor area.	> 10 m	
2.	Level 2	Blk 2 - corridor area.	> 10 m	
3.	Level 3	Blk 2 - corridor area.	> 10 m	
4.	Roof	near stairs case 1	> 10 m	



ACCEPTED



RE-INSPECTION REQUIRED



ACCEPTED WITH COMMENTS



NOT ACCEPTED

COMMENTS

OK/

Installed & Tested By :

Wann Ko
(Name & signature)

11/09/2024
(Date & Time)

Inspected & Checked By :

Moe Thauk Tun
(Name & signature)

11/09/2024
(Date & Time)

Witnessed & Accepted By :

Soe Jhyr
(Name & signature)

11/09/2024
(Date & Time)


LEGEND

 HOSEREEL C/W STAINLESS STEEL CABINET

 DRAIN OFF VALVE

 AUTOMATIC AIR RELIEF VALVE

 HOSE REEL PIPE

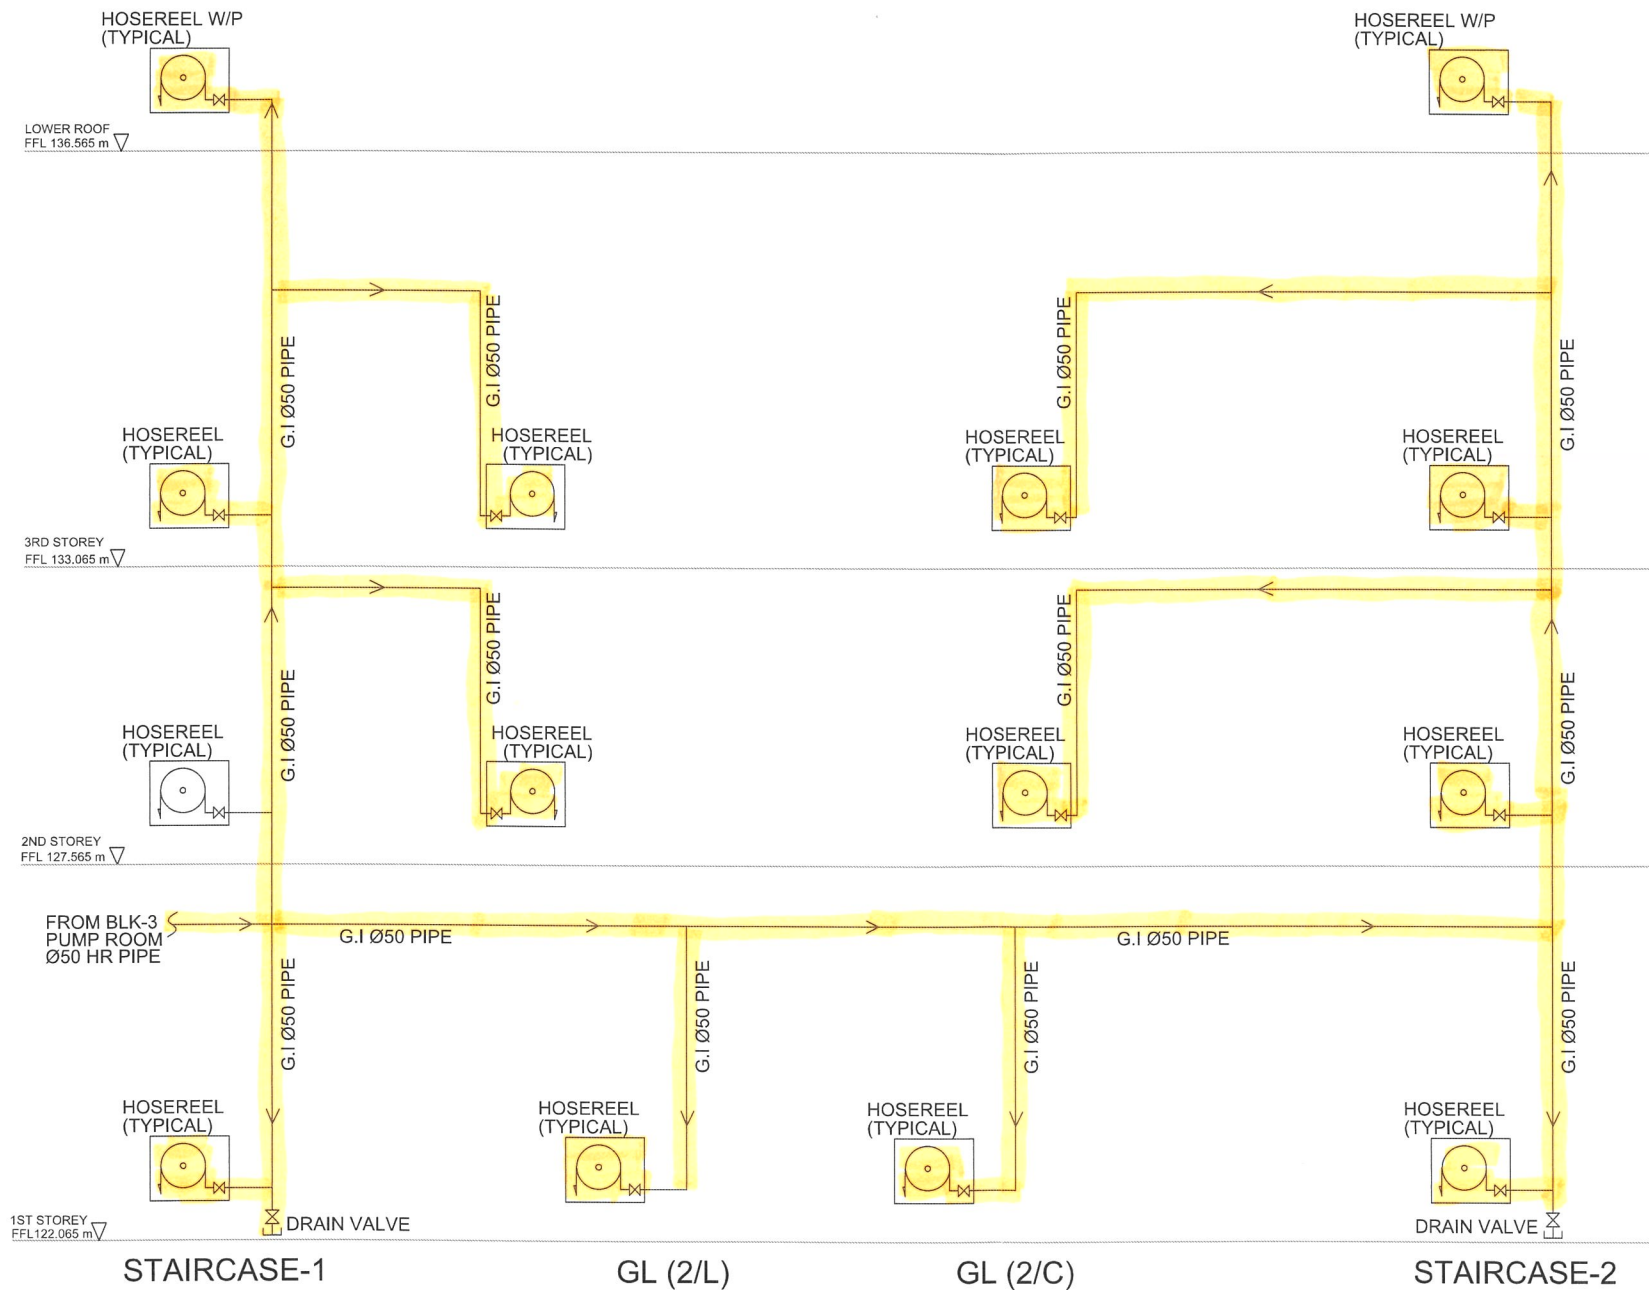

M&E CONSULTANTS
PdcConsultants Pte Ltd
23 NEW INDUSTRIAL ROAD #06-03
SOLISTICE BUSINESS CENTER SINGAPORE 536209
TEL: 6444 7748
FAX: 6444 7141

DATE RECEIVED: _____ RECEIVED BY: _____
DATE RETURNED: _____
☐ NO EXCEPTION TAKEN ☐ MAKE CORRECTIONS NOTED PRIOR TO GENERAL USE
☐ TO REVISE & RESUBMIT ☐ REJECTED & RESUBMIT

SIGNATURE: _____

• WHERE RESUBMISSION IS REQUIRED, SUBMIT REVISED DRAWINGS FOR REVIEW PRIOR TO PROCEEDING WITH WORK.
• THIS REVIEW IS FOR GENERAL ARRANGEMENT ONLY AND DOES NOT EXTEND TO DIMENSIONS OF SETTING OUT OF THE WORKS AND DOES NOT RELEASE THE CONTRACTOR OF HIS RESPONSIBILITIES TO ENSURE FULL COMPLIANCE TO CONTRACT SPECIFICATION, OTHER DRAWINGS AND STATUTORY REQUIREMENT HAVING JURISDICTION OVER THE INSTALLATION.

SHOPDRAWING REVIEW

Date received: _____
Date returned: _____
☐ NC - No Comment
☐ AC - Approved with Comment
☐ RR - Revise & Resubmit
☐ REJ - Rejected

The review of this shopdrawing is for conformity to the design intent and for general arrangement only. It does not relieve the contractor from full responsibility for errors, omissions and from compliance with the requirements of the main contract documents.

ID ARCHITECTS
Signature: _____ Date: _____

PROJECT CONSULTING ARCHITECT
ID ARCHITECTS PTE LTD
3 Harbourfront Place, #03-01 Harbourfront Tower Two
Singapore 099254
Tel: 6225 6011 Fax: 6225 6022
Email: general@idarchitects.com.sg
www.idarchitects.com.sg

SHOP DRAWING

DSTA PROJECT TEAM

☐ NO COMMENT PROJECT OFFICER : _____
DATE : _____
☐ WITH COMMENT PROJECT OFFICER : _____
DATE : _____
☐ REVISE & RESUBMIT
☐ REJECTED Non-compliance to specification

REV	AMENDMENT DESCRIPTION	Requested by	Updated by	Date
01	AS PER ARCHI CHANGED	DSTA	ZIN KO	08.01.2024
00	SUBMISSION FOR APPROVAL	DSTA	ZIN KO	25.04.2023

Project No.: D2019-00162

DEENN ENGINEERING PTE LTD
29 Harrison Road, Lion Beng Building, Singapore 369648
TEL No. 6283 1468 FAX No. 6280 9360
e-mail : lionbengconstr@pacific.net.sg
Website: www.lionbeng.com.sg

ID ARCHITECTS PTE LTD
3 Harbourfront Place, #03-01
Harbourfront Tower Two
Singapore 099254
Tel: 6225 6011 Fax: 6225 6022
Email: general@idarchitects.com.sg
www.idarchitects.com.sg

TW-ASIA Consultants Pte Ltd
110, South Bridge Road, #04-01, Singapore 050070
Tel: 6342 1111 Fax: 6342 1112

PdcConsultants Pte Ltd
MECHANICAL - ELECTRICAL
23 New Industrial Road #06-03
Solstice Business Center
Singapore 536209
t: 6444 7748 f: 6444 7141
e: contact@pdcengrs.com

Sub contractor:
NORTHWAY FIRE PROTECTION PTE LTD
21, Jalan Bukit Merah, #04-01, Singapore 150001
TEL: 6337 0348 FAX: 6337 0349
E-MAIL: northwayfire@northwayfire.com.sg

Project Title: FIRE PROTECTION SERVICES
BLK 2
HOSE REEL SCHEMATIC DIAGRAM

Project No.: D2019-00162

Rev	By	Date	Remarks
01	JASMIN	JAN 2024	
02	ZIN KO	JAN 2024	
03	NAING	JAN 2024	
04	N.T.S		

01 09.01.24