

M&E CONSULTANTS PdcConsultants Pte Ltd 23 NEW INDUSTRIAL ROAD #06-03 SOLSTICE BUSINESS CENTER SINGAPORE 536209 DATE RECEIVED: DATE RETURNED: □ NO EXCEPTION TAKEN □ MAKE CORRECTIONS NOTED PRIOR TO GENERAL USE ☐ TO REVISE & RESUBMIT ☐ REJECTED & RESUBMIT

• WHERE RESUBMISSION IS REQUIRED, SUBMIT REVISED DRAWINGS FOR REVIEW PRIOR TO PROCEEDING WITH WORK THIS REVIEW IS FOR GENERAL ARRANGEMENT ONLY AND DOES NOT EXTEND TO DIMENSIONS OF SETTING OUT OF THE WORKS AND DOES NOT RELEASE THE CONTRACTOR OF HIS RESPONSIBILITIES TO ENSURE FULL COMPLIANCE. THIS REVIEW DOES NOT RELEASE THE CONTRACTOR OF HIS RESPONSIBILITIES TO ENSURE WORKS IN COMPLIANCE
TO CONTRACT SPECIFICATION, OTHER DRAWINGS AND STATUTORY REQUIREMENT HAVING JURISDICTION OVER THE
INSTALLATION.



## PLUMBING SCHEMATIC DRAWING Scale-NTS

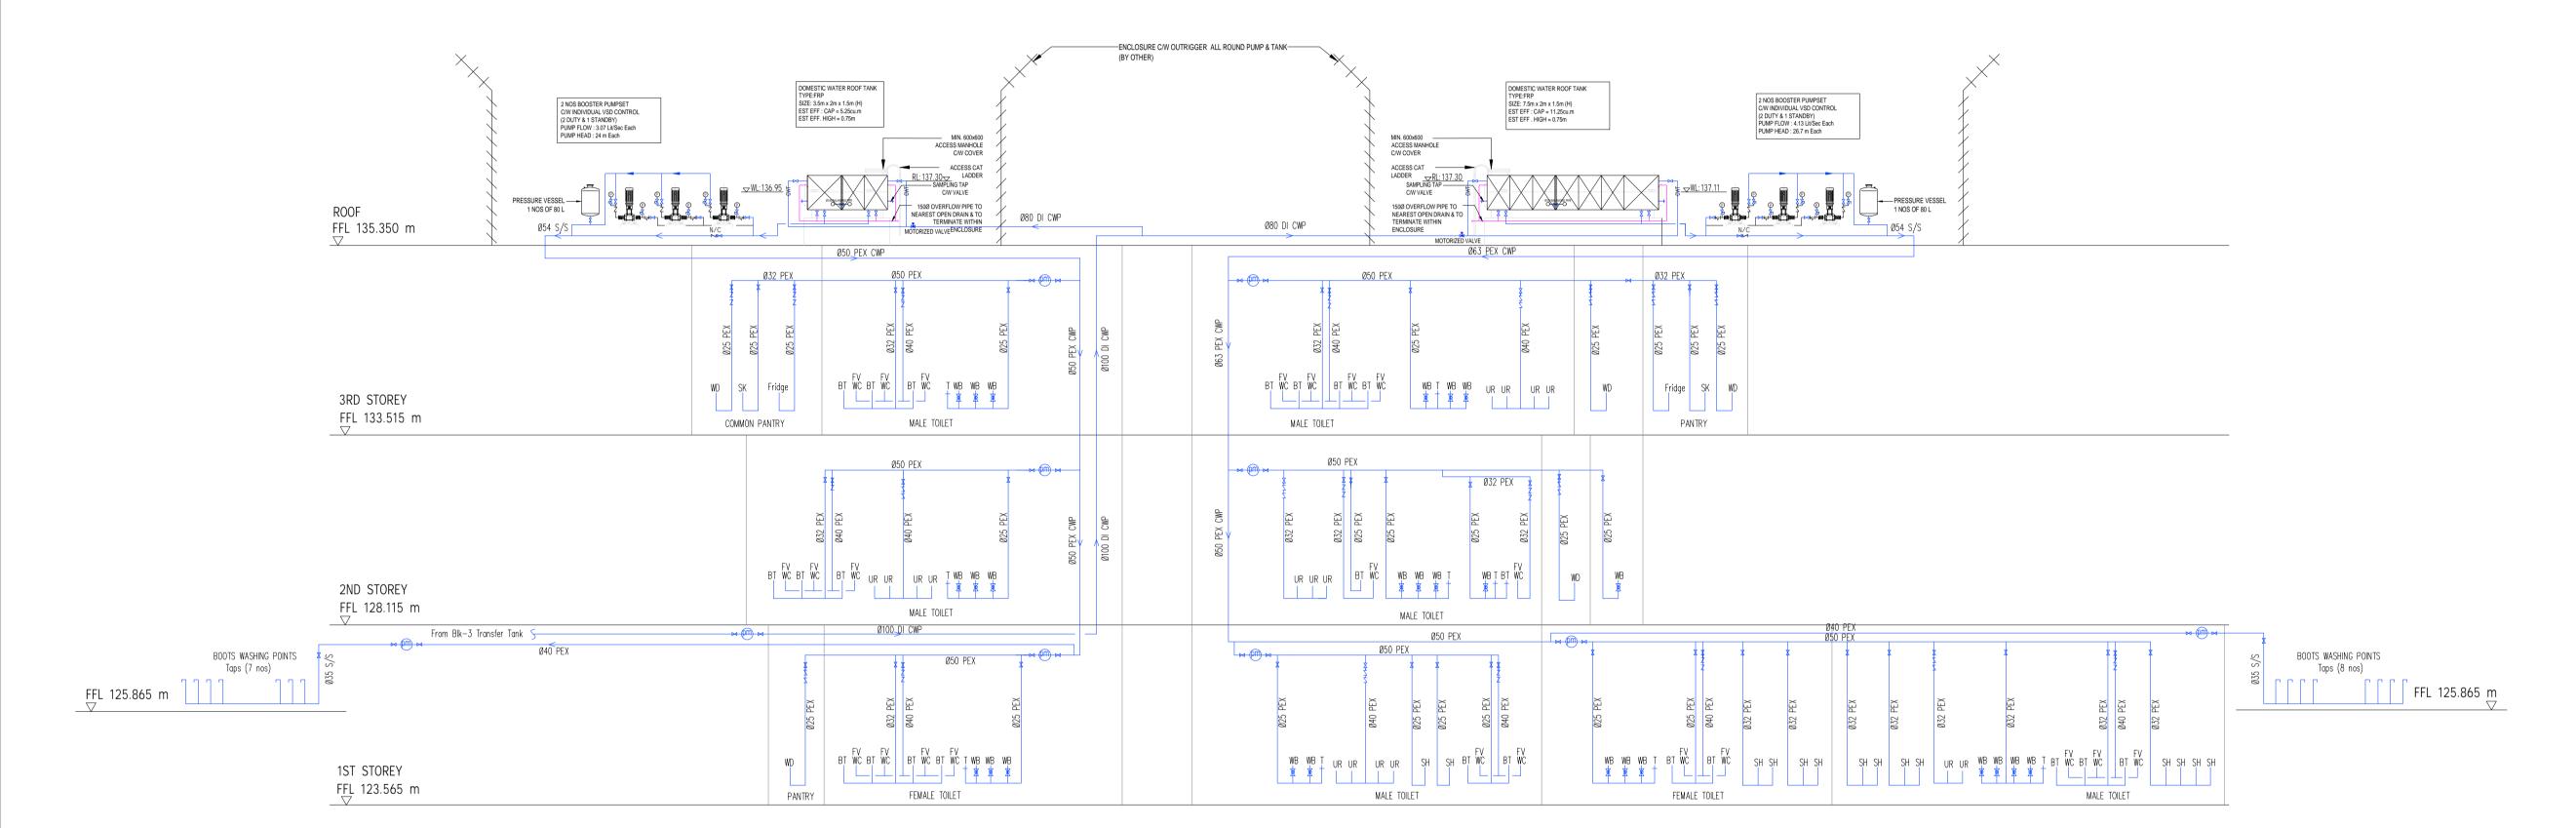

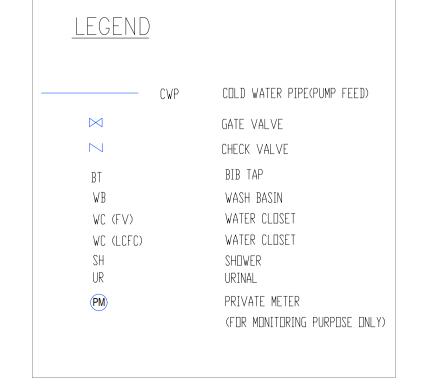

'AS-BUILT'

Project Ref. No.: A2105-00599-2022







EDMUND TEO KUAN WEI

Senior Programme Manager

PEH SEOH CHIN HCD (Army Camps)



DEENN ENGINEERING PTE LTD

29 Harrison Road, Lian Beng Building , Singapore 369648 TEL. No.6283 1468 FAX No. 6280 9360 e-mail: lianbengconstn@pacific.net.sg Website: www.lianbeng.com.sg

Architect:

ID ARCHITECTS PTE LTD Singapore 099254 Tel:6225 6011 Fax:6225 6022

general@idarchitects.com.sg www.idarchitects.com.sg



Structure:

TW- ASIA Consultants Pte Ltd NO. 28 SIN MING LANE #04-137 MIDVIEW CITY

SINGAPORE 573972 TEL : 62916292 FAX : 62932196

## Pdc Consultants Pte Ltd Paya Lebar Square #10-17/18 (Office Lobby 1) 60 Paya Lebar Road Singapore 409051 t: 6444 7748 f: 6444 7141 e: contact@pdcengrs.com

Sub Contractor:



WATERTECH PLUMBING & CONSTRUCTION PTE LTD 30 Kaki Bukit Rd 3 #04-02 Empire TechnoCentre Singapore 417819
Tel:6444 6855 FAX : 6444 7378

D2019-00162

PROPOSED ADDITIONS OF 1 BLOCK OF 3-STOREY OFFICE BUILDING (BLK 2), 1 BLOCK OF 6-STOREY ACCOMMODATION BUILDING (BLK 3), 1 BLOCK OF 4-STOREY ACCOMMODATION BUILDING (BLK 4), 1 BLOCK OF 2-STOREY TRAINING MULTIPLEX (BLK 9), 1 BLOCK OF MSVS (BLK 10), AND ANCILLARY FACILITIES (BLK 5, 6 & 8) TO EXISTING DIEPPE BARRACK ON LOT 05019M MK13 AT SEMBAWANG ROAD (MANDAI PLANNING AREA)

Drawing	title:	
---------	--------	--

BLK 2 PLUMBING SCHEMATIC DRAWING

	Initial	Date		
Drawn	SAN	15.08.2024	Scale	AS SHOWN
Checked	TOMMY	15.08.2024	Software	CAD
Drawing no.:	Revision no.:			
D2019-00				

THIS DRAWING IS COPYRIGHT THIS DRAWING IS THE PROPERTY OF DSTA. IF FOUND, PLEASE RETURN TO DSTA

BUILDING AND INFRASTRUCTURE PROGRAMME CENTRE, 1 DEPOT ROAD, SINGAPORE 109679. REPRODUCTION OF DRAWING WITHOUT THE WRITTEN PERMISSION OF DSTA BI IS STRICTLY PROHIBITED. ANY UNAUTHORIZED REPRODUCTION OR POSSESSION SHALL BE DEALT WITH UNDER THE OFFICIAL SECRETS ACT.