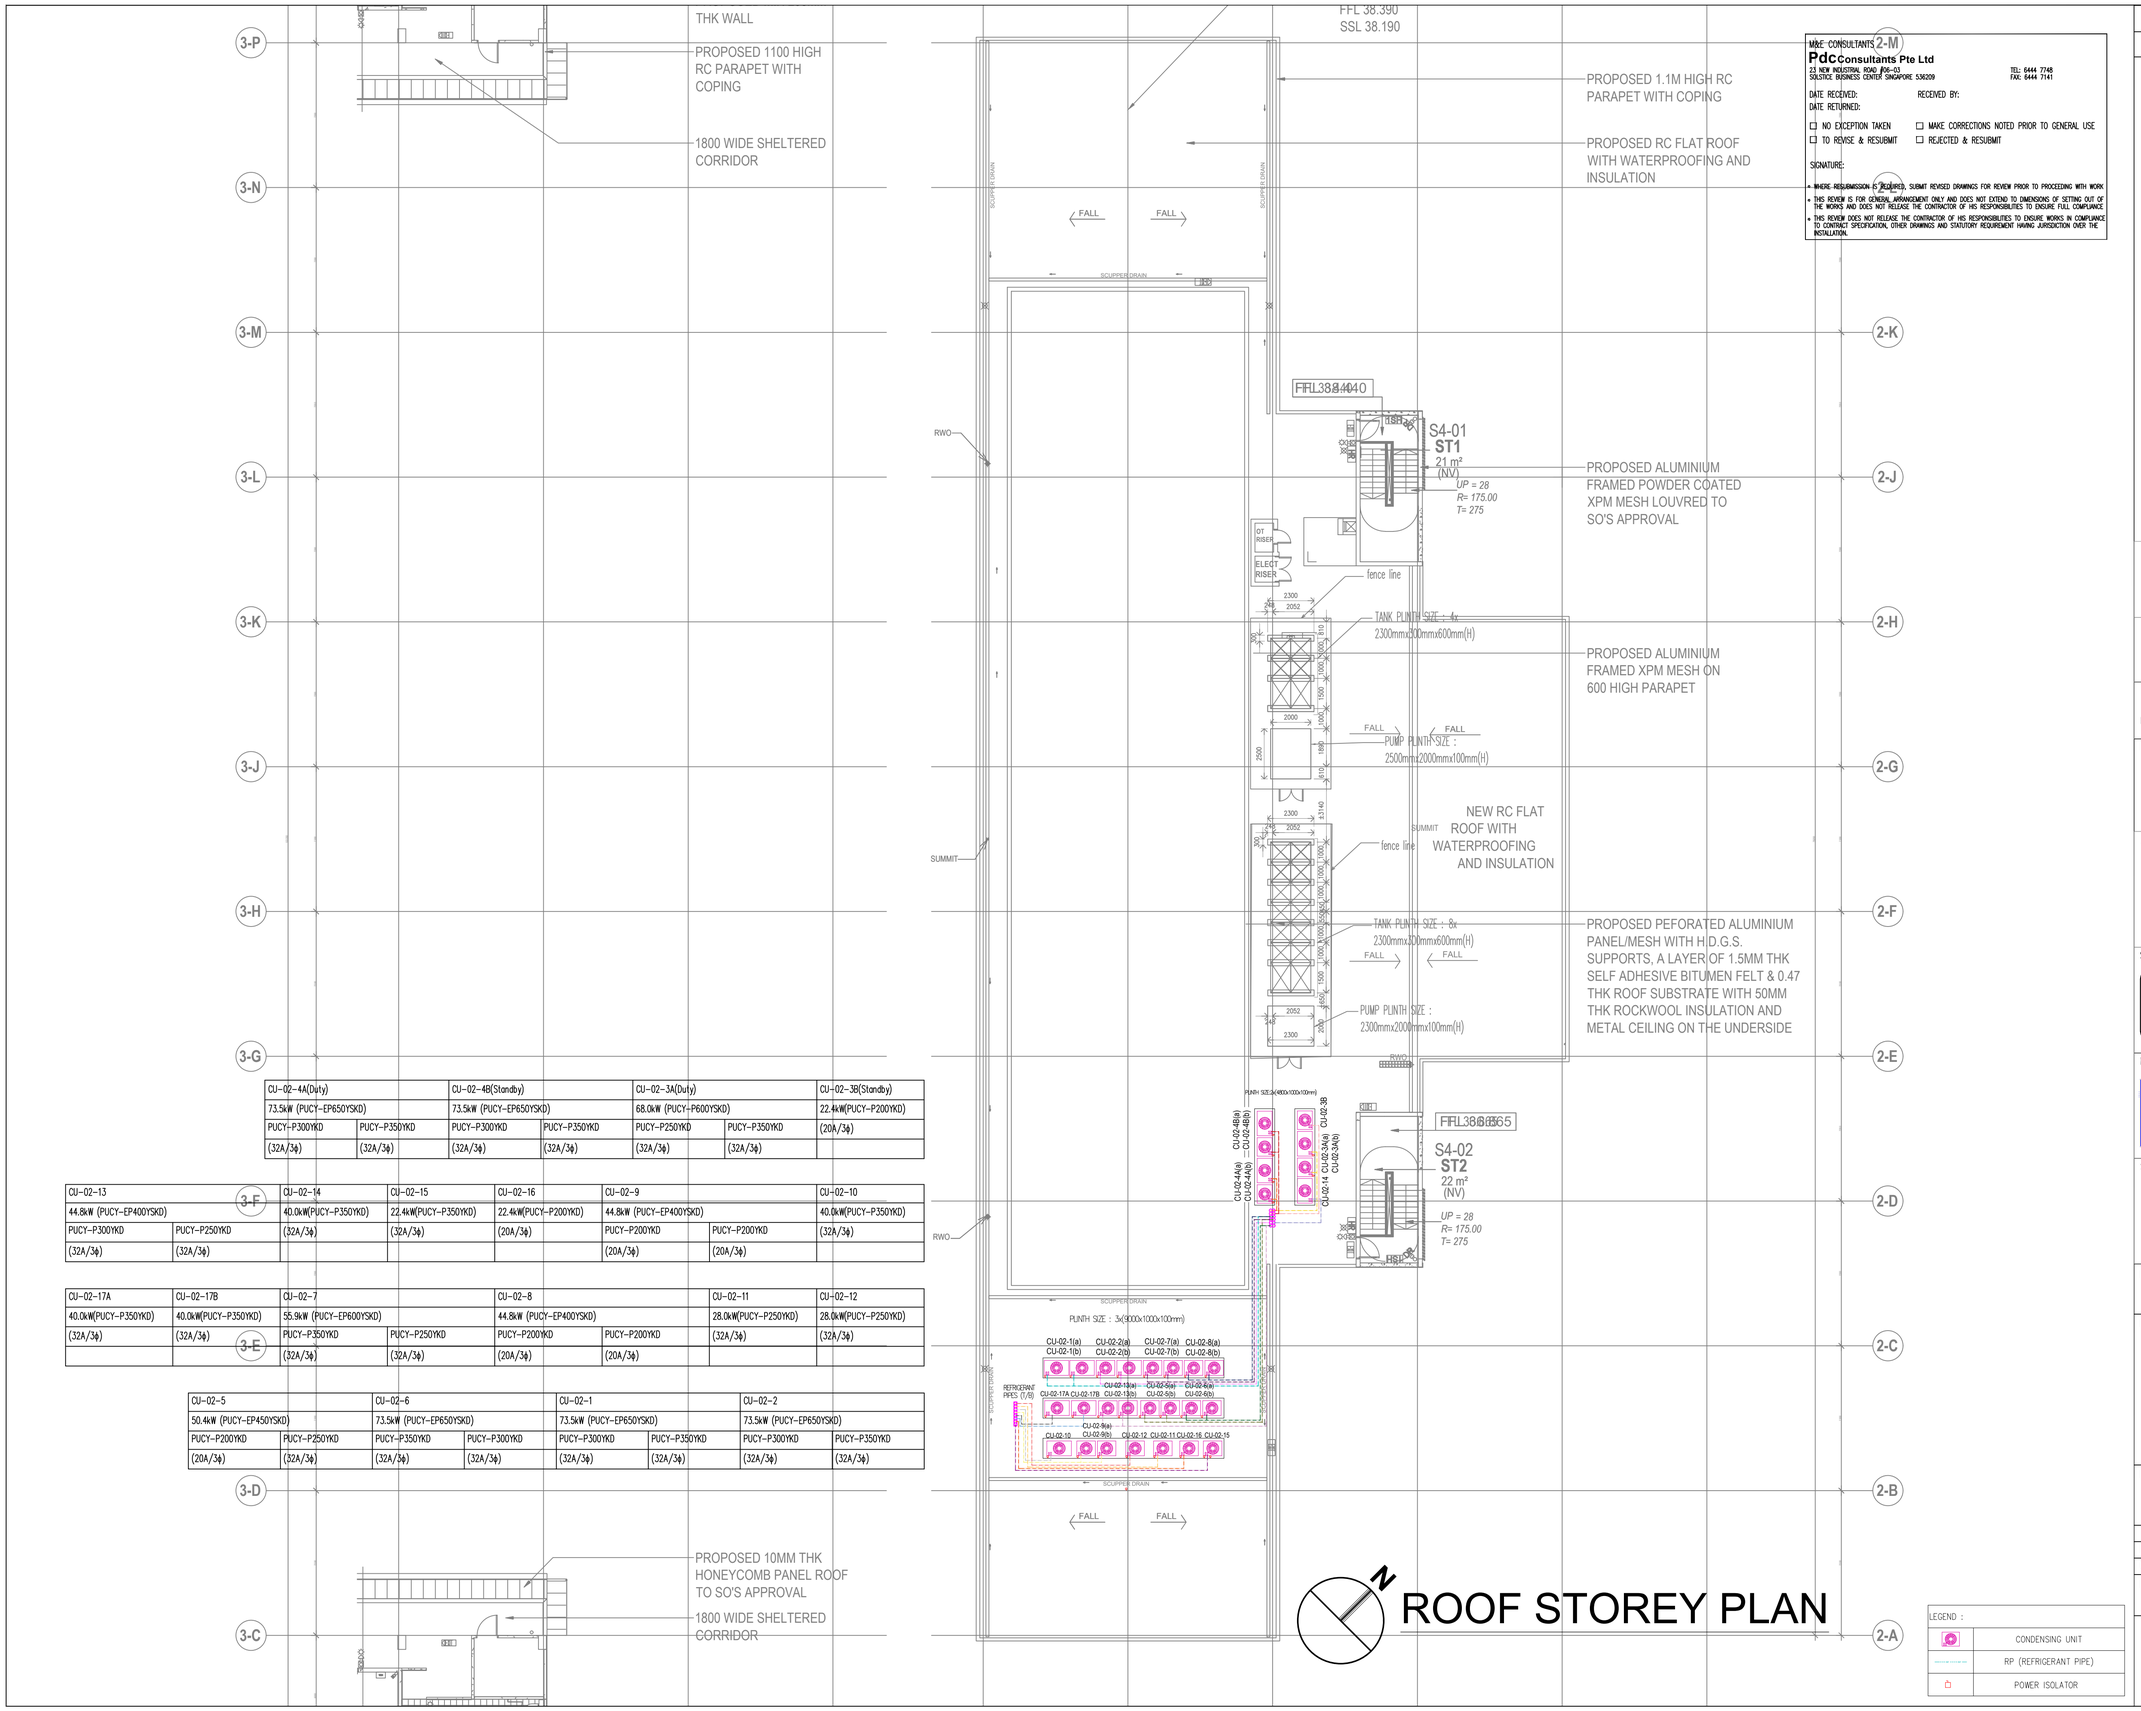

CU-02-4A(Duty)		CU-02-4B(Standby)		CU-02-3A(Duty)		CU-02-3B(Standby)
73.5kW (PUCY-EP650YSKD)		73.5kW (PUCY-EP650YSKD)		68.0kW (PUCY-P600YSKD)		22.4kW(PUCY-P200YKD)
PUCY-P300YKD	PUCY-P350YKD	PUCY-P300YKD	PUCY-P350YKD	PUCY-P250YKD	PUCY-P350YKD	(20A/3ϕ)
(32A/3ϕ)	(32A/3ϕ)	(32A/3ϕ)	(32A/3ϕ)	(32A/3ϕ)	(32A/3ϕ)	

CU-02-13		CU-02-14	CU-02-15	CU-02-16	CU-02-9		CU-02-10
44.8kW (PUCY-EP400YSKD)		40.0kW(PUCY-P350YKD)	22.4kW(PUCY-P350YKD)	22.4kW(PUCY-P200YKD)	44.8kW (PUCY-EP400YSKD)		40.0kW(PUCY-P350YKD)
PUCY-P300YKD	PUCY-P250YKD	(32A/3ϕ)	(32A/3ϕ)	(20A/3ϕ)	PUCY-P200YKD	PUCY-P200YKD	(32A/3ϕ)
(32A/3ϕ)	(32A/3ϕ)				(20A/3ϕ)	(20A/3ϕ)	

CU-02-17A	CU-02-17B	CU-02-7		CU-02-8		CU-02-11	CU-02-12
40.0kW(PUCY-P350YKD)	40.0kW(PUCY-P350YKD)	55.9kW (PUCY-EP600YSKD)		44.8kW (PUCY-EP400YSKD)		28.0kW(PUCY-P250YKD)	28.0kW(PUCY-P250YKD)
(32A/3ϕ)	(32A/3ϕ)	PUCY-P350YKD	PUCY-P250YKD	PUCY-P200YKD	PUCY-P200YKD	(32A/3ϕ)	(32A/3ϕ)
		(32A/3ϕ)	(32A/3ϕ)	(20A/3ϕ)	(20A/3ϕ)		

CU-02-5		CU-02-6		CU-02-1		CU-02-2	
50.4kW (PUCY-EP450YSKD)		73.5kW (PUCY-EP650YSKD)		73.5kW (PUCY-EP650YSKD)		73.5kW (PUCY-EP650YSKD)	
PUCY-P200YKD	PUCY-P250YKD	PUCY-P350YKD	PUCY-P300YKD	PUCY-P300YKD	PUCY-P350YKD	PUCY-P300YKD	PUCY-P350YKD
(20A/3ϕ)	(32A/3ϕ)	(32A/3ϕ)	(32A/3ϕ)	(32A/3ϕ)	(32A/3ϕ)	(32A/3ϕ)	(32A/3ϕ)

M&E CONSULTANTS :
Pdc Consultants Pte Ltd
23 NEW INDUSTRIAL ROAD #06-03
SOLSTICE BUSINESS CENTER SINGAPORE 536209
TEL: 6444 7748
FAX: 6444 7141

DATE RECEIVED: RECEIVED BY:
DATE RETURNED:

☐ NO EXCEPTION TAKEN ☐ MAKE CORRECTIONS NOTED PRIOR TO GENERAL USE
☐ TO REVISE & RESUBMIT ☐ REJECTED & RESUBMIT

SIGNATURE:

- WHERE RESUBMISSION IS REQUIRED, SUBMIT REVISED DRAWINGS FOR REVIEW PRIOR TO PROCEEDING WITH WORK.
- THIS REVIEW IS FOR GENERAL ARRANGEMENT ONLY AND DOES NOT EXTEND TO DIMENSIONS OF SETTING OUT OF THE WORKS AND DOES NOT RELEASE THE CONTRACTOR OF HIS RESPONSIBILITIES TO ENSURE FULL COMPLIANCE.
- THIS REVIEW DOES NOT RELEASE THE CONTRACTOR OF HIS RESPONSIBILITIES TO ENSURE WORKS IN COMPLIANCE TO CONTRACT SPECIFICATION, OTHER DRAWINGS AND STATUTORY REQUIREMENT HAVING JURISDICTION OVER THE INSTALLATION.

LEGEND :	
	CONDENSING UNIT
	RP (REFRIGERANT PIPE)
	POWER ISOLATOR

AS-BUILT DRAWING

Project Ref. No. : A2105-00599-2022

DSTA Defence Science & Technology Agency

PEH SEOH CHIN
HCD (Army Camps)

EDMUND TEO KUAN WEI
Senior Programme Manager

D&B Main Contractor:

DEENN ENGINEERING PTE LTD
29 Harrison Road, Lian Beng Building , Singapore 369648
TEL. No.6283 1468 FAX No. 6280 9360
e-mail : lianbengconstn@pacific.net.sg
Website: www.lianbeng.com.sg

Architect:

ID ARCHITECTS PTE LTD
3 HarbourFront Place, #03-01,
HarbourFront Tower Two,
Singapore 099254
Tel:6225 6011
Fax:6225 6022
general@idarchitects.com.sg
www.idarchitects.com.sg

Structure:

TW-ASIA Consultants Pte Ltd
NO. 28 SIN MING LANE #04-137 MIDVIEW CITY
SINGAPORE 573972 TEL : 62516282 FAX : 62532196

M&E Consultant:

Pdc Consultants Pte Ltd
MECHANICAL + ELECTRICAL
23 New Industrial Road #06-03
Solstice Business Center
Singapore 536209
t : 6444 7748 f: 6444 7141
e : contact@pdcengrs.com

Sub Contractor:

INTAC SYSTEMS SOLUTION PTE LTD
BLOCK 1 KAKI BUKIT AVENUE 3
#04-03 KB-1, SINGAPORE 416087
Tel: +65 6842 7318 Fax: +65 6842 7319
Email: intacss@intacss.com.sg

Project No.:
D2019-00162

Project Title:
PROPOSED ADDITIONS OF 1 BLOCK OF 3-STOREY OFFICE BUILDING (BLK 2), 1 BLOCK OF 6-STOREY ACCOMMODATION BUILDING (BLK 3), 1 BLOCK OF 4-STOREY ACCOMMODATION BUILDING (BLK 4), 1 BLOCK OF 2-STOREY TRAINING MULTIPLEX (BLK 9), 1 BLOCK OF MSVS (BLK 10), AND ANCILLARY FACILITIES (BLK 5, 6 & 8) TO EXISTING DIEPPE BARRACK ON LOT 05019M MK13 AT SEMBAWANG ROAD (MANDAI PLANNING AREA)

Drawing title:
BLOCK 2 - ROOF STOREY
ACMV LAYOUT PLAN

	Initial	Date		
Drawn	MS	30/12/24	Scale	1 : 150 (A1)
Checked	HK	30/12/24	Software	CAD

Drawing no.: D2019-00162/ISS/ACMV-BLK 2-04
Revision no.: 00

THIS DRAWING IS COPYRIGHT
THIS DRAWING IS THE PROPERTY OF DSTA. IF FOUND, PLEASE RETURN TO DSTA BUILDING AND INFRASTRUCTURE PROGRAMME CENTRE, 1 DEPOT ROAD, SINGAPORE 109679.
REPRODUCTION OF DRAWING WITHOUT THE WRITTEN PERMISSION OF DSTA BI IS STRICTLY PROHIBITED. ANY UNAUTHORIZED REPRODUCTION OR POSSESSION SHALL BE DEALT WITH UNDER THE OFFICIAL SECRETS ACT.