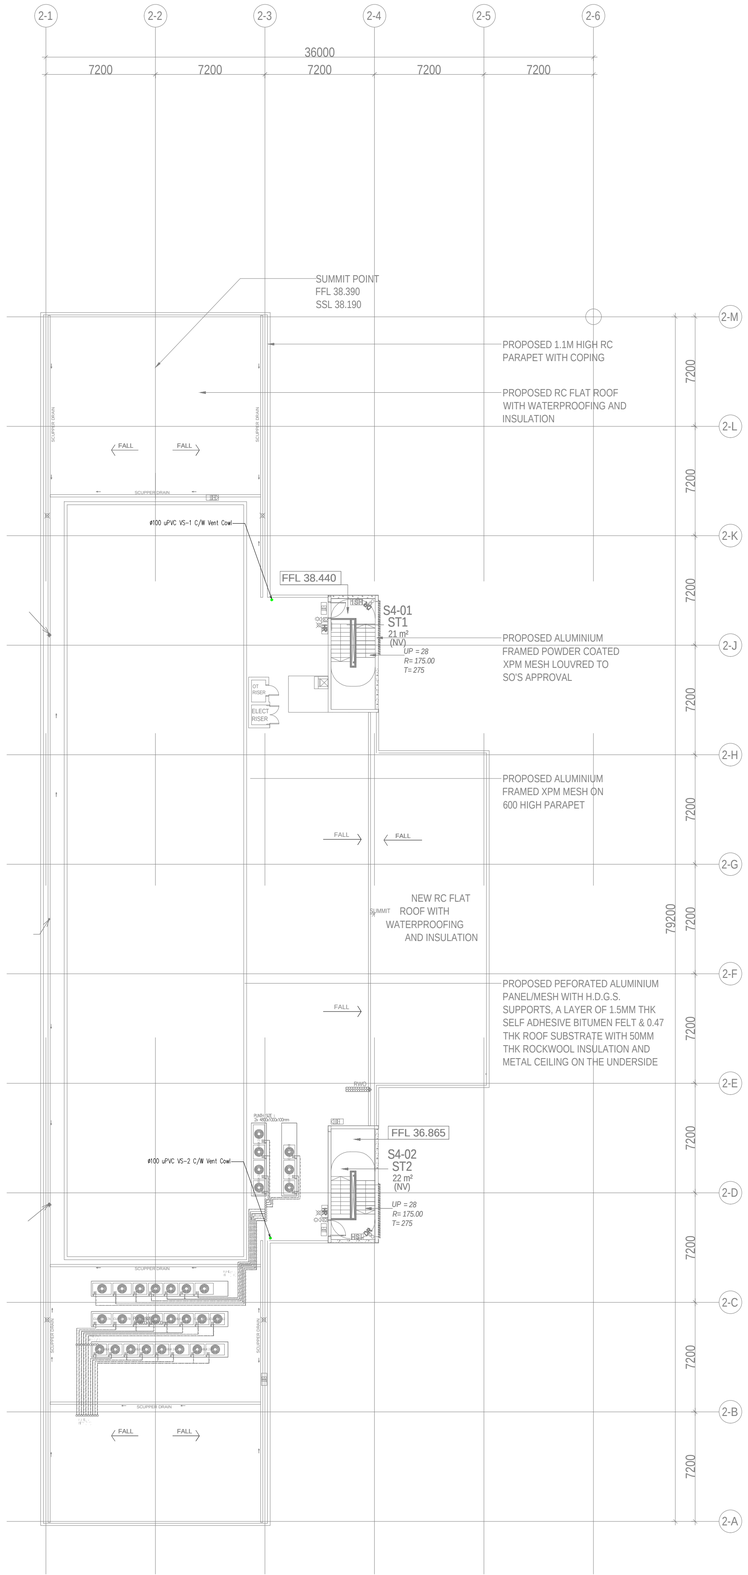

ROOF PLAN

Scale: 1:200

M&E CONSULTANTS

Pdc Consultants Pte Ltd

23 NEW INDUSTRIAL ROAD #06-03
SOLSTICE BUSINESS CENTER SINGAPORE 536209

TEL: 6444 7748
FAX: 6444 7141

DATE RECEIVED: RECEIVED BY:

DATE RETURNED:

☐ NO EXCEPTION TAKEN ☐ MAKE CORRECTIONS NOTED PRIOR TO GENERAL USE

☐ TO REVISE & RESUBMIT ☐ REJECTED & RESUBMIT

SIGNATURE:

- WHERE RESUBMISSION IS REQUIRED, SUBMIT REVISED DRAWINGS FOR REVIEW PRIOR TO PROCEEDING WITH WORK
- THIS REVIEW IS FOR GENERAL ARRANGEMENT ONLY AND DOES NOT EXTEND TO DIMENSIONS OF SETTING OUT OF THE WORKS AND DOES NOT RELEASE THE CONTRACTOR OF HIS RESPONSIBILITIES TO ENSURE FULL COMPLIANCE
- THIS REVIEW DOES NOT RELEASE THE CONTRACTOR OF HIS RESPONSIBILITIES TO ENSURE WORKS IN COMPLIANCE TO CONTRACT SPECIFICATION, OTHER DRAWINGS AND STATUTORY REQUIREMENT HAVING JURISDICTION OVER THE INSTALLATION.

'AS-BUILT'

Project Ref. No. : A2105-00599-2022

DSTA Defence Science & Technology Agency

INNOVATION EXCELLENCE AWARD 2014 WINNER

CERTIFICATION INTERNATIONAL ISO 9001:2008 Cert No: CIS 9170

SINGAPORE QUALITY STAR

PEH SEOH CHIN
HCD (Army Camps)

EDMUND TEO KUAN WEI
Senior Programme Manager

D&B Main Contractor:

DEENN ENGINEERING PTE LTD
29 Harrison Road, Lian Beng Building , Singapore 369648
TEL. No.6283 1468 FAX No. 6280 9360
e-mail : lianbengconstn@pacific.net.sg
Website: www.lianbeng.com.sg

Architect:

ID ARCHITECTS PTE LTD
3 HarbourFront Place, #03-01,
HarbourFront Tower Two,
Singapore 099254
Tel:6225 6011
Fax:6225 6022
general@idarchitects.com.sg
www.idarchitects.com.sg

Structure:

TW-ASIA Consultants Pte Ltd
NO. 28 SIN MING LANE #04-137 MIDVIEW CITY
SINGAPORE 573972 TEL : 62916292 FAX : 62932196

M&E Consultant:

Pdc Consultants Pte Ltd
MECHANICAL + ELECTRICAL
Paya Lebar Square
#10-17/18 (Office Lobby 1)
60 Paya Lebar Road Singapore 409051
t : 6444 7748 f : 6444 7141
e : contact@pdcengrs.com

Sub Contractor:

WATERTECH PLUMBING & CONSTRUCTION PTE LTD
30 Kaki Bukit Rd 3 #04-02
Empire TechnoCentre
Singapore 417819
Tel:6444 6855 FAX : 6444 7378

Project No.:

D2019-00162

Project Title:

PROPOSED ADDITIONS OF 1 BLOCK OF 3-STOREY OFFICE BUILDING (BLK 2), 1 BLOCK OF 6-STOREY ACCOMMODATION BUILDING (BLK 3), 1 BLOCK OF 4-STOREY ACCOMMODATION BUILDING (BLK 4), 1 BLOCK OF 2-STOREY TRAINING MULTIPLEX (BLK 9), 1 BLOCK OF MSVS (BLK 10), AND ANCILLARY FACILITIES (BLK 5, 6 & 8) TO EXISTING DIEPPE BARRACK ON LOT 05019M MK13 AT SEMBAWANG ROAD (MANDAI PLANNING AREA)

Drawing title:

BLK 2 ROOF SANITARY DRAWING

	Initial	Date		
Drawn	SAN	15.08.2024	Scale	AS SHOWN
Checked	TOMMY	15.08.2024	Software	CAD

Drawing no.: D2019-00162/BLK 2/S 04

Revision no.:

THIS DRAWING IS COPYRIGHT
THIS DRAWING IS THE PROPERTY OF DSTA. IF FOUND, PLEASE RETURN TO DSTA BUILDING AND INFRASTRUCTURE PROGRAMME CENTRE, 1 DEPOT ROAD, SINGAPORE 109679.
REPRODUCTION OF DRAWING WITHOUT THE WRITTEN PERMISSION OF DSTA BI IS STRICTLY PROHIBITED. ANY UNAUTHORIZED REPRODUCTION OR POSSESSION SHALL BE DEALT WITH UNDER THE OFFICIAL SECRETS ACT.